
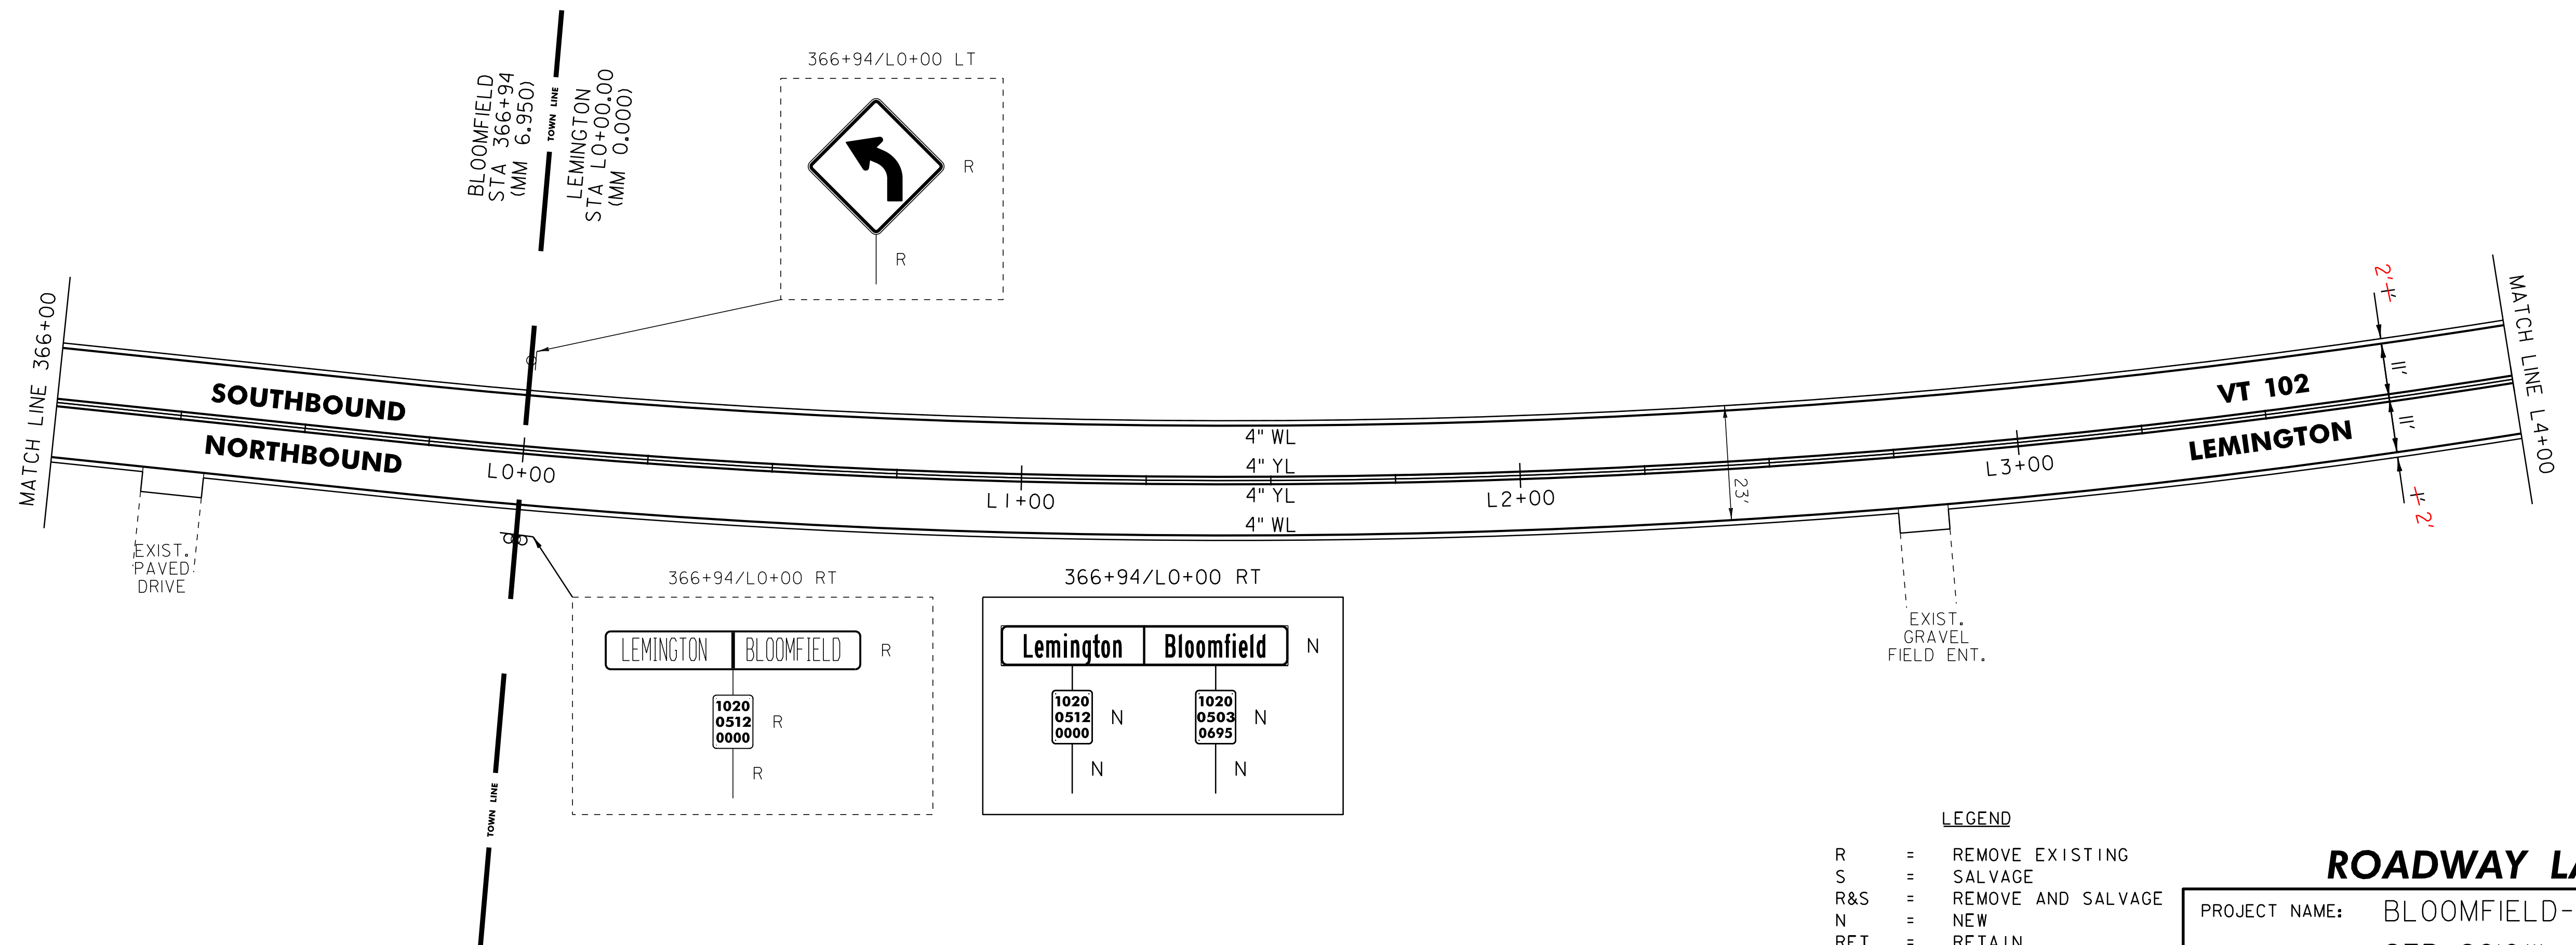


646.602 TEMPORARY 4" WHITE LINE, PAINT  
 646.402 DURABLE 4" WHITE LINE, THERMOPLASTIC OR  
 646.403 DURABLE 4" WHITE LINE, EPOXY PAINT OR  
 646.404 DURABLE 4" WHITE LINE, POLYUREA,  
 360+50 TO L4+00 SOLID LT & RT

646.612 TEMPORARY 4" YELLOW LINE, PAINT  
 646.412 DURABLE 4" YELLOW LINE, THERMOPLASTIC OR  
 646.413 DURABLE 4" YELLOW LINE, EPOXY PAINT OR  
 646.414 DURABLE 4" YELLOW LINE, POLYUREA,  
 360+50 TO L4+00 SOLID LT & RT

675.50 REMOVING SIGNS  
 AS SHOWN - 3

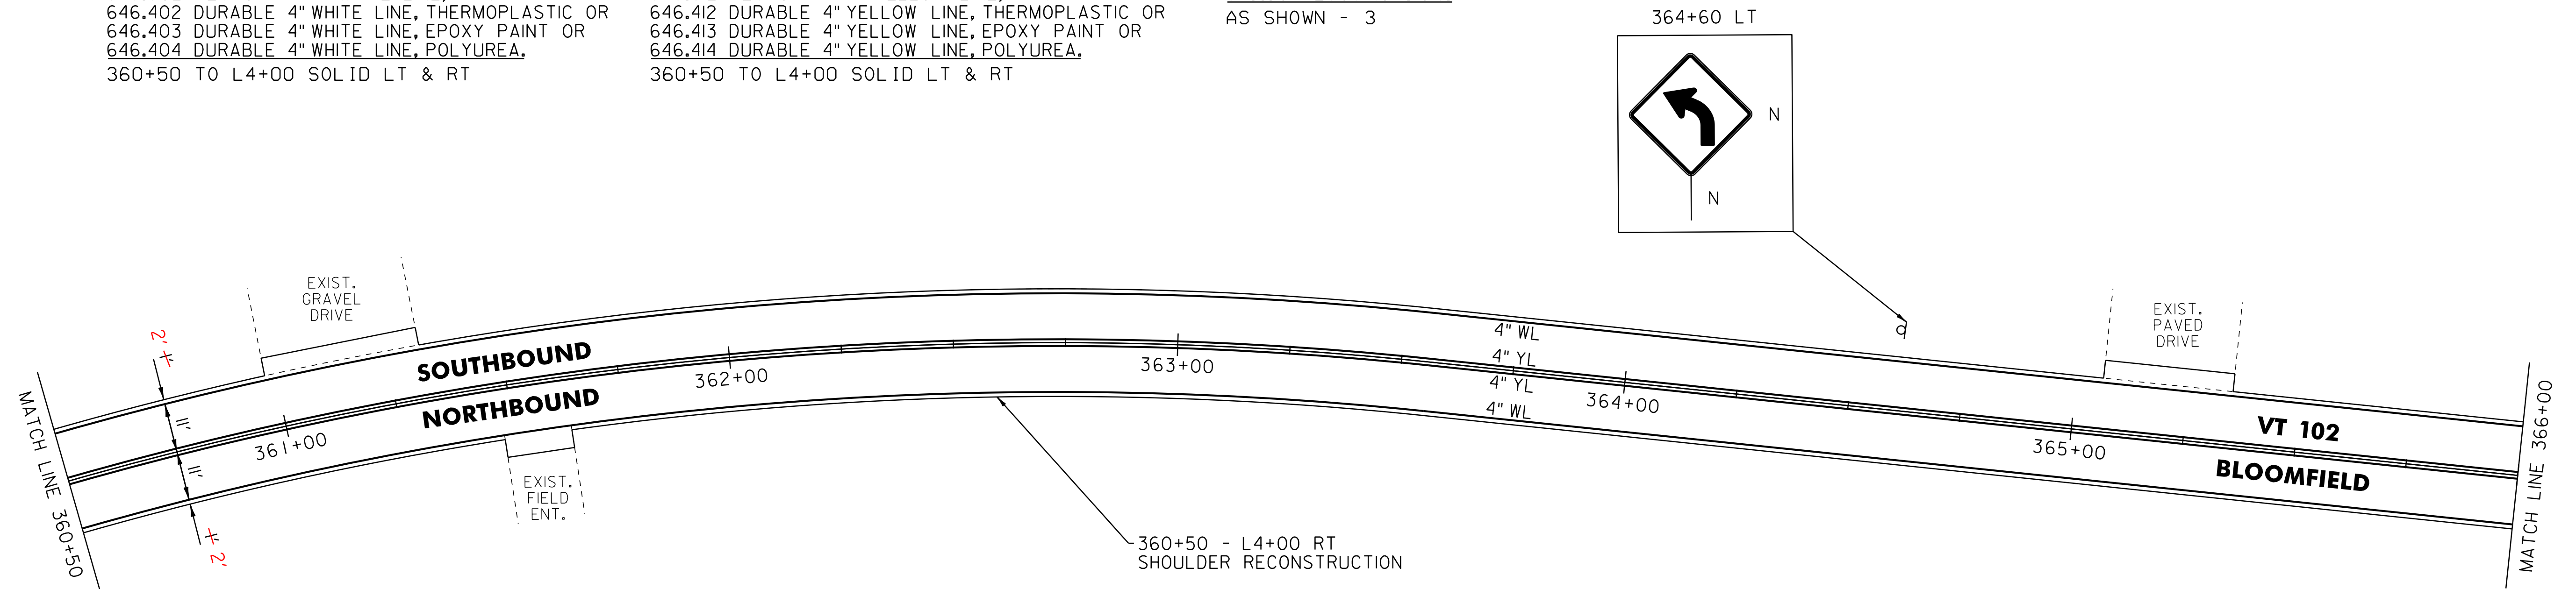

- LEGEND**
- R = REMOVE EXISTING
  - S = SALVAGE
  - R&S = REMOVE AND SALVAGE
  - N = NEW
  - RET = RETAIN
  - B-B = BACK TO BACK
  - = EXISTING GUARDRAIL
  - |— = PROPOSED GUARDRAIL
  - YL = YELLOW LINE
  - WL = WHITE LINE
  - = DELINEATOR

NOT TO SCALE

**ROADWAY LAYOUT 35**

PROJECT NAME: BLOOMFIELD-LEMINGTON  
 PROJECT NUMBER: STP 2610(I)  
 FILE NAME: /pave/06c052/pc052  
 PROJECT LEADER: PTS  
 DESIGNED BY: NULL  
 IPARM FILE NAME: 06C052.49

PLOT DATE: 19-JUN-2013 16:59  
 DRAWN BY: SNG  
 CHECKED BY: PTS  
 SHEET 49 OF 82