
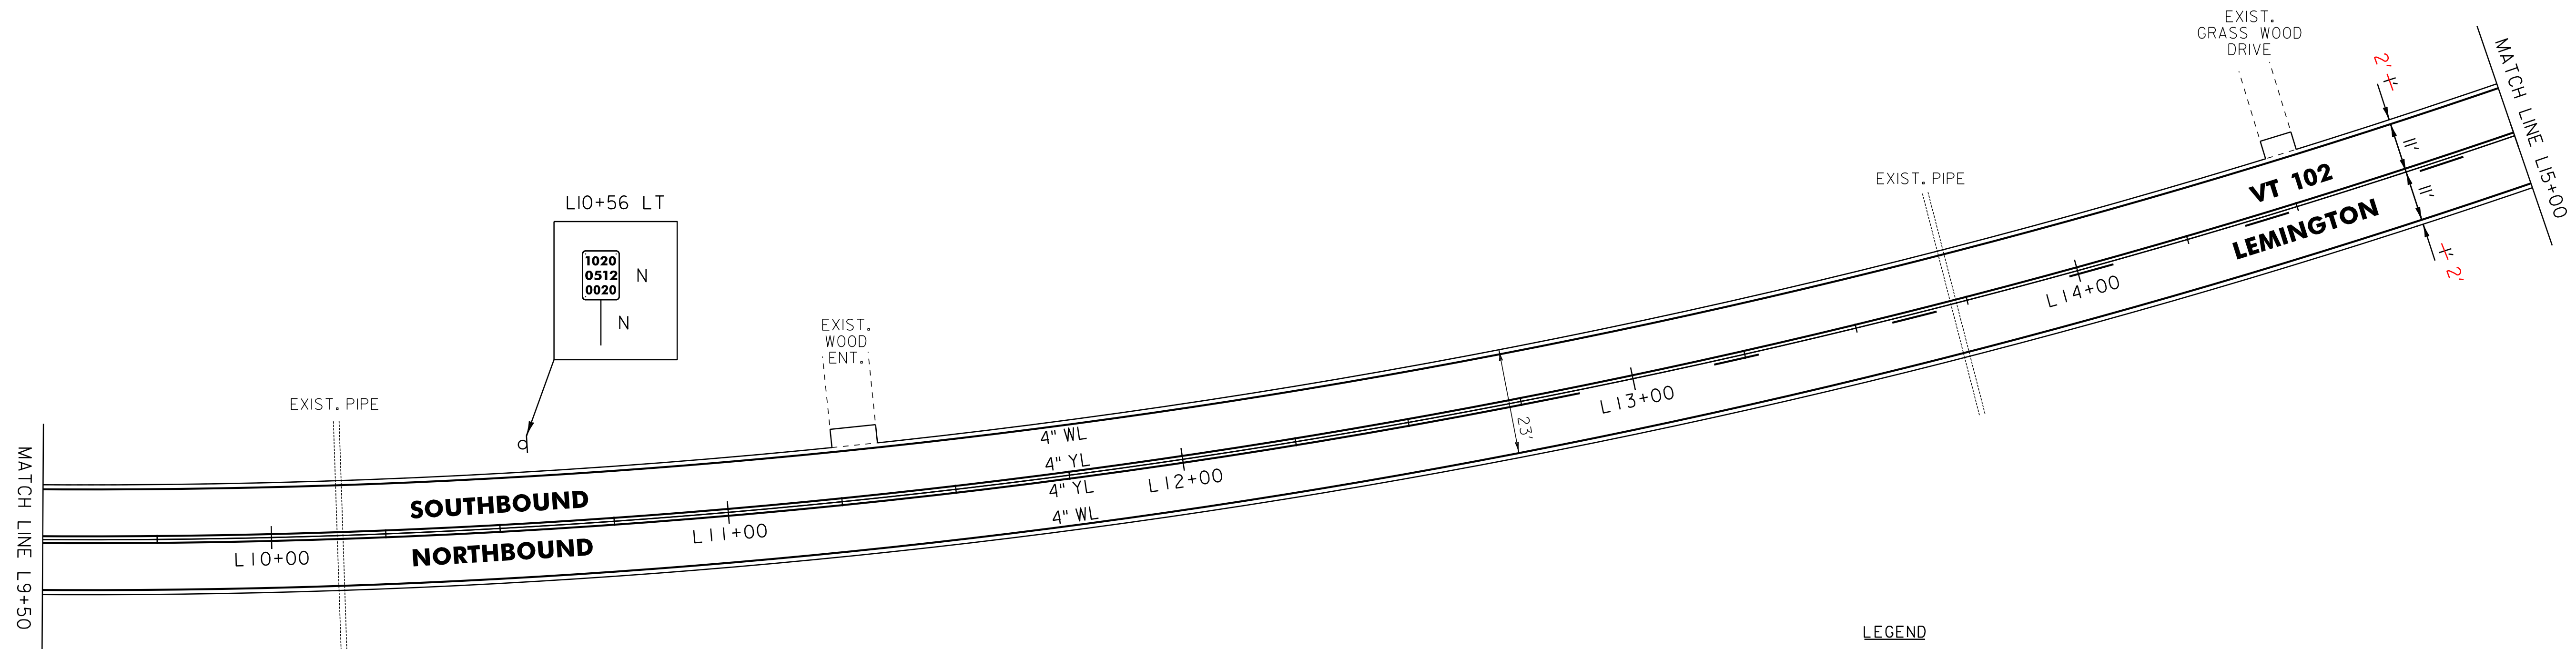


646.602 TEMPORARY 4" WHITE LINE, PAINT  
 646.402 DURABLE 4" WHITE LINE, THERMOPLASTIC OR  
 646.403 DURABLE 4" WHITE LINE, EPOXY PAINT OR  
 646.404 DURABLE 4" WHITE LINE, POLYUREA,  
 L4+00 TO L15+00 SOLID LT & RT

646.612 TEMPORARY 4" YELLOW LINE, PAINT  
 646.412 DURABLE 4" YELLOW LINE, THERMOPLASTIC OR  
 646.413 DURABLE 4" YELLOW LINE, EPOXY PAINT OR  
 646.414 DURABLE 4" YELLOW LINE, POLYUREA,  
 L4+00 TO L12+88 SOLID LT & RT  
 L12+88 TO L15+00 SOLID LT, DASHED RT

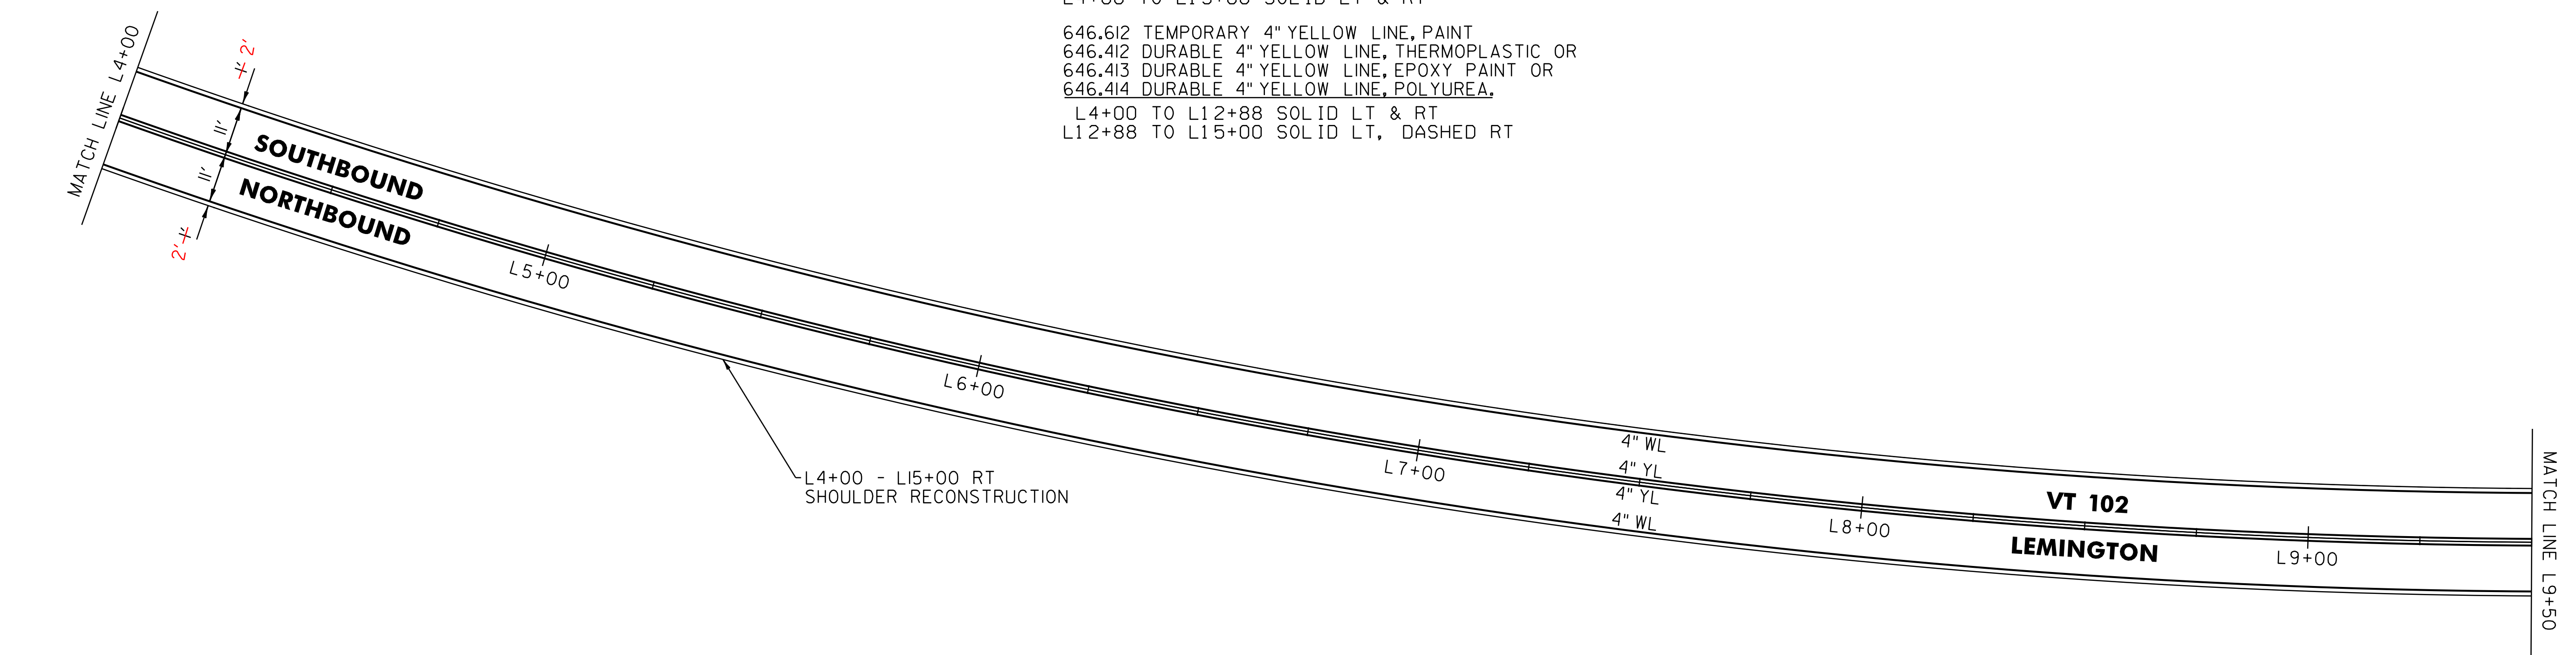

**LEGEND**

R	=	REMOVE EXISTING
S	=	SALVAGE
R&S	=	REMOVE AND SALVAGE
N	=	NEW
RET	=	RETAIN
B-B	=	BACK TO BACK
	=	EXISTING GUARDRAIL
	=	PROPOSED GUARDRAIL
YL	=	YELLOW LINE
WL	=	WHITE LINE
	=	DELINEATOR

**ROADWAY LAYOUT 36**

PROJECT NAME:	BLOOMFIELD-LEMINGTON	FILE NAME:	/pave/06c052/pc052	PLOT DATE:	19-JUN-2013 17:00
PROJECT NUMBER:	STP 2610(I)	PROJECT LEADER:	PTS	DRAWN BY:	SNG
		DESIGNED BY:	NLL	CHECKED BY:	PTS
		IPARM FILE NAME:	06C052.50	SHEET	50 OF 82

NOT TO SCALE