

646.602 TEMPORARY 4" WHITE LINE, PAINT
 646.402 DURABLE 4" WHITE LINE, THERMOPLASTIC OR
 646.403 DURABLE 4" WHITE LINE, EPOXY PAINT OR
 646.404 DURABLE 4" WHITE LINE, POLYUREA,
 L15+00 TO L26+00 SOLID LT & RT

646.612 TEMPORARY 4" YELLOW LINE, PAINT
 646.412 DURABLE 4" YELLOW LINE, THERMOPLASTIC OR
 646.413 DURABLE 4" YELLOW LINE, EPOXY PAINT OR
 646.414 DURABLE 4" YELLOW LINE, POLYUREA,
 L15+00 TO L20+80 SOLID LT, DASHED RT
 L20+80 TO L26+00 DASHED CL



621.20 STEEL BEAM GUARDRAIL, GALVANIZED
 L21+17 TO L26+00 RT

621.50 MANUFACTURED
 TERMINAL SECTION, FLARED
 L20+79.5 TO L21+17 RT

621.80 REMOVAL AND DISPOSAL OF GUARDRAIL
 L21+17 TO L26+00 RT

900.620 SPECIAL PROVISION
 (DELINEATOR WITH STEEL POST)
 L20+79.5 RT

675.50 REMOVING SIGNS
 AS SHOWN - 1

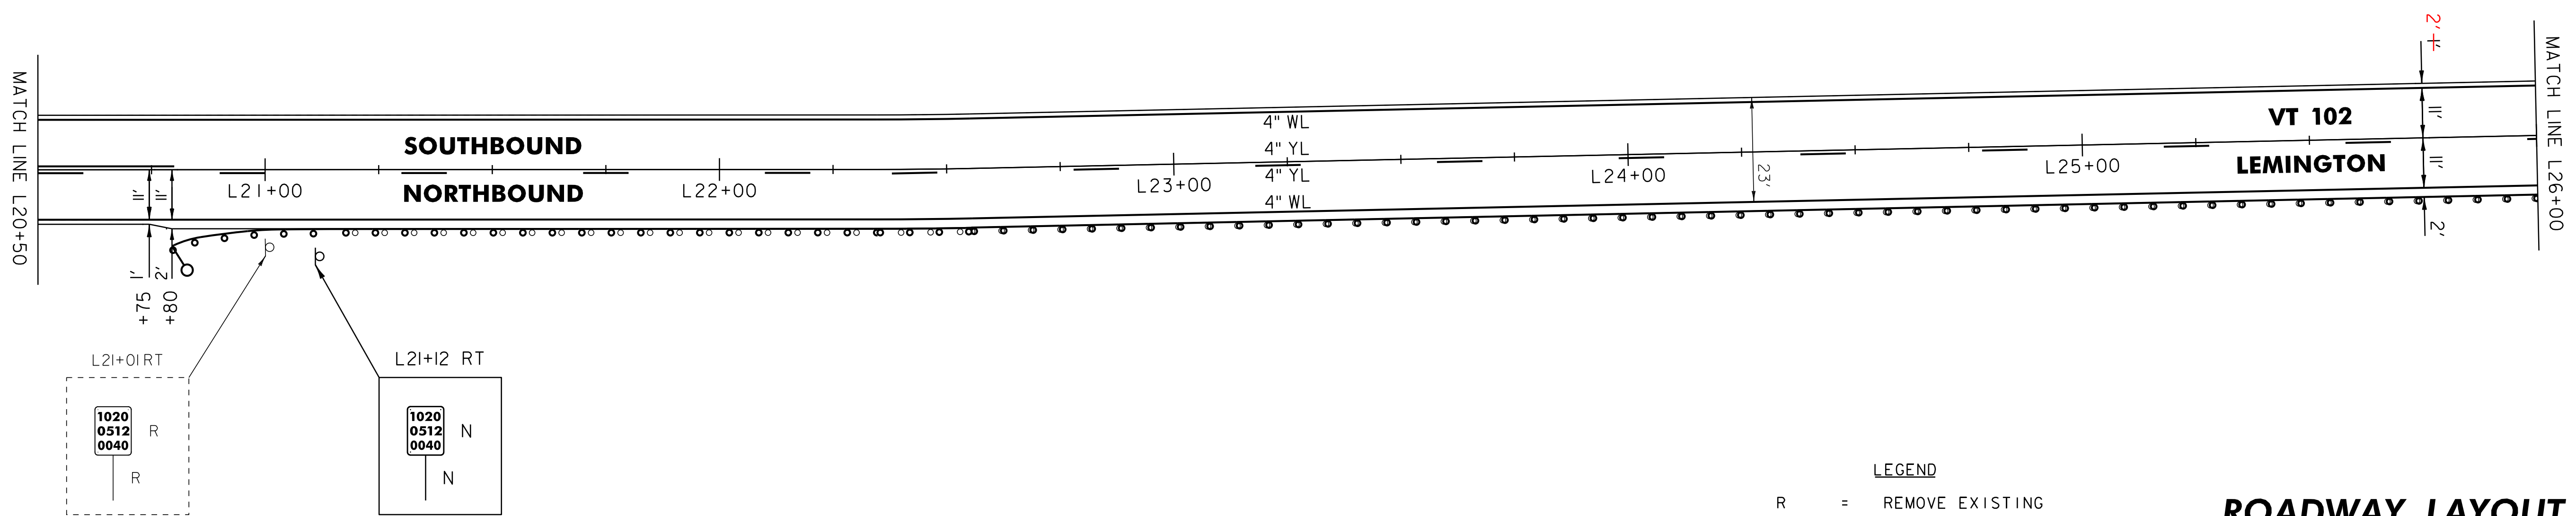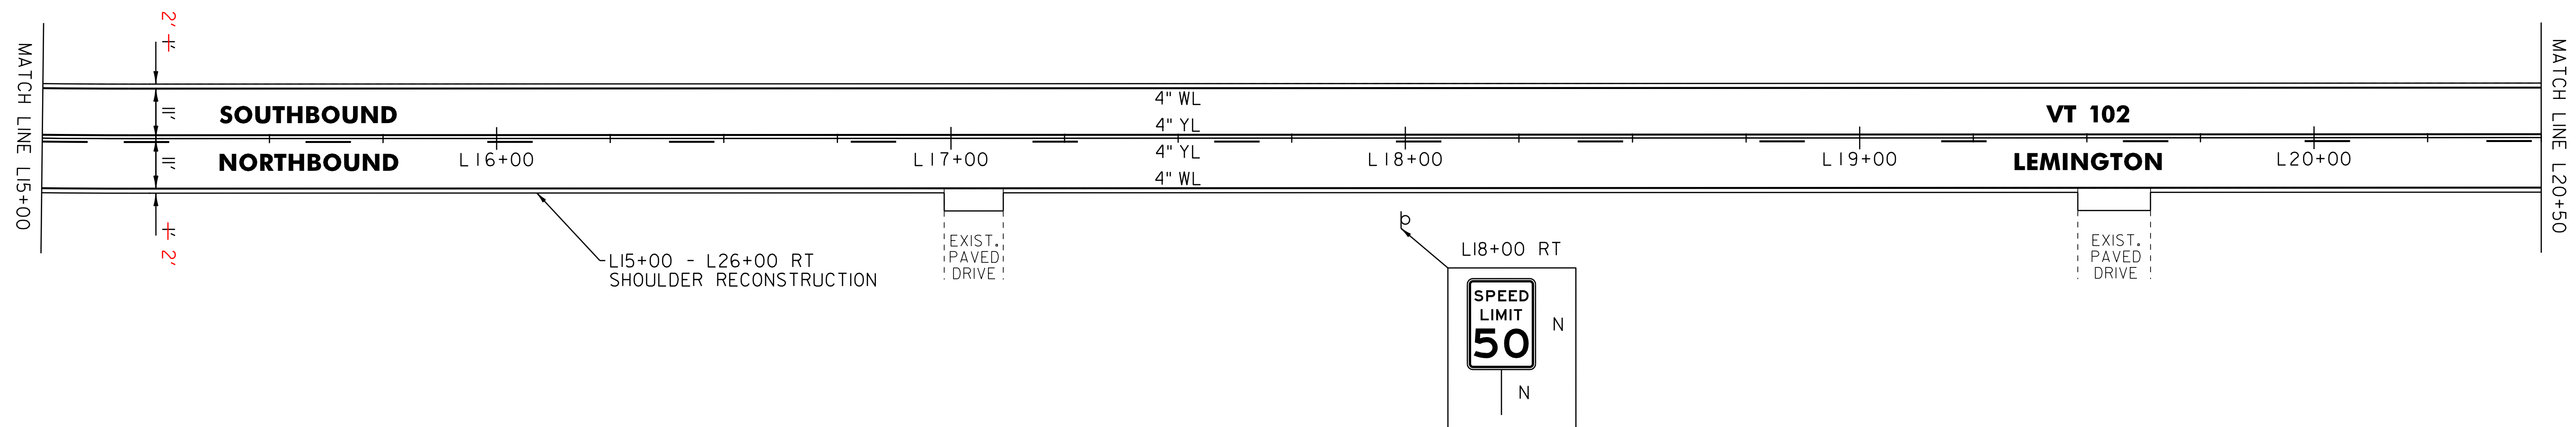

- LEGEND**
- R = REMOVE EXISTING
 - S = SALVAGE
 - R&S = REMOVE AND SALVAGE
 - N = NEW
 - RET = RETAIN
 - B-B = BACK TO BACK
 - ⊖ = EXISTING GUARDRAIL
 - ⊕ = PROPOSED GUARDRAIL
 - YL = YELLOW LINE
 - WL = WHITE LINE
 - = DELINEATOR

ROADWAY LAYOUT 37

PROJECT NAME: BLOOMFIELD-LEMINGTON
 PROJECT NUMBER: STP 2610(I)
 FILE NAME: /pave/06c052/pc052 PLOT DATE: 19-JUN-2013 17:00
 PROJECT LEADER: PTS DRAWN BY: SNG
 DESIGNED BY: NULL CHECKED BY: PTS
 IPARM FILE NAME: 06C052.5I SHEET 51 OF 82

NOT TO SCALE