
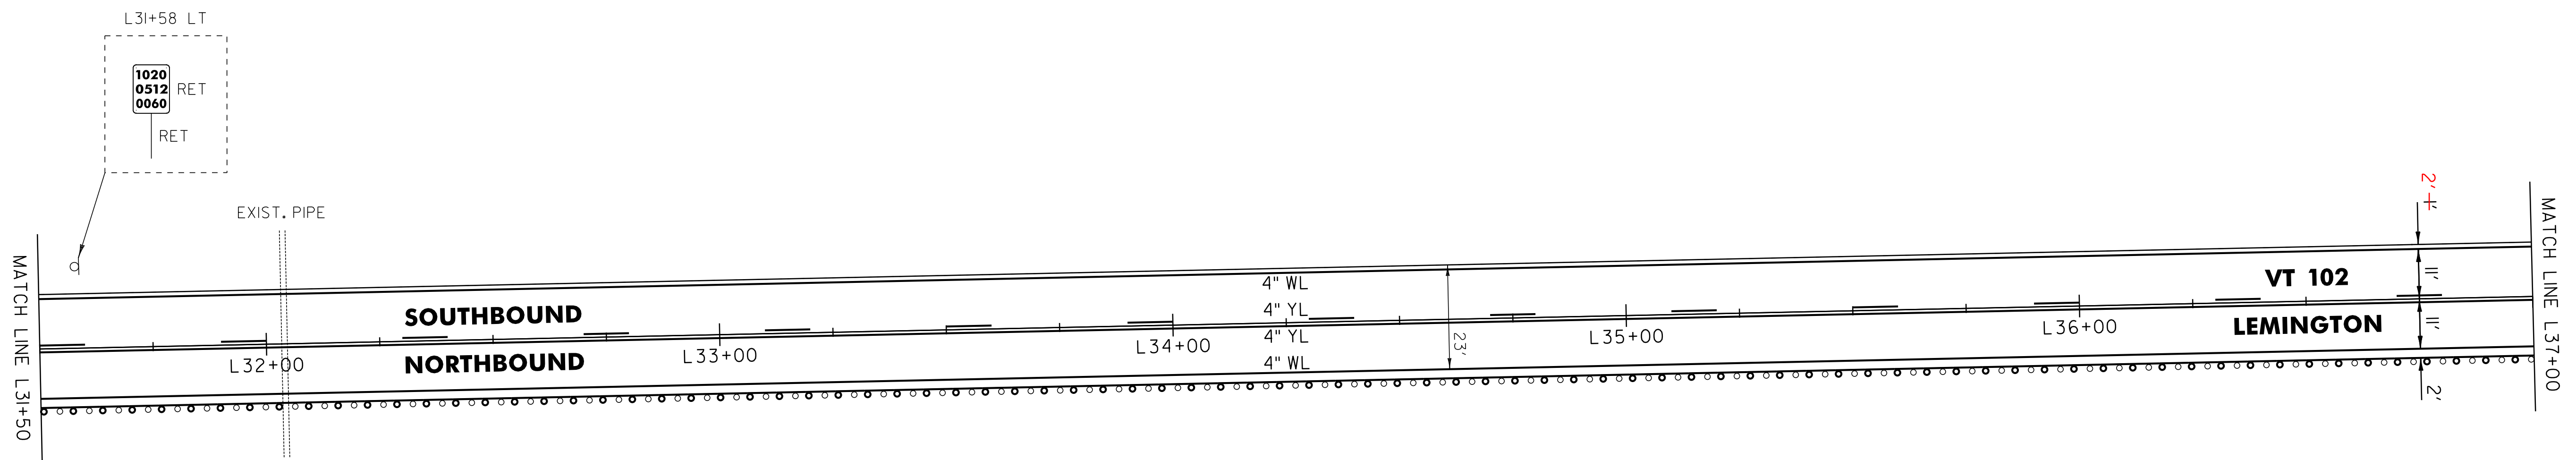


646.602 TEMPORARY 4" WHITE LINE, PAINT
 646.402 DURABLE 4" WHITE LINE, THERMOPLASTIC OR
 646.403 DURABLE 4" WHITE LINE, EPOXY PAINT OR
 646.404 DURABLE 4" WHITE LINE, POLYUREA.
 L26+00 TO L37+00 SOLID LT & RT

646.612 TEMPORARY 4" YELLOW LINE, PAINT
 646.412 DURABLE 4" YELLOW LINE, THERMOPLASTIC OR
 646.413 DURABLE 4" YELLOW LINE, EPOXY PAINT OR
 646.414 DURABLE 4" YELLOW LINE, POLYUREA.
 L26+00 TO L30+10 DASHED CL
 L30+10 TO L37+00 DASHED LT, SOLID RT

621.20 STEEL BEAM GUARDRAIL, GALVANIZED
 L26+00 TO L37+00 RT

621.80 REMOVAL AND DISPOSAL OF GUARDRAIL
 L26+00 TO L37+00 RT

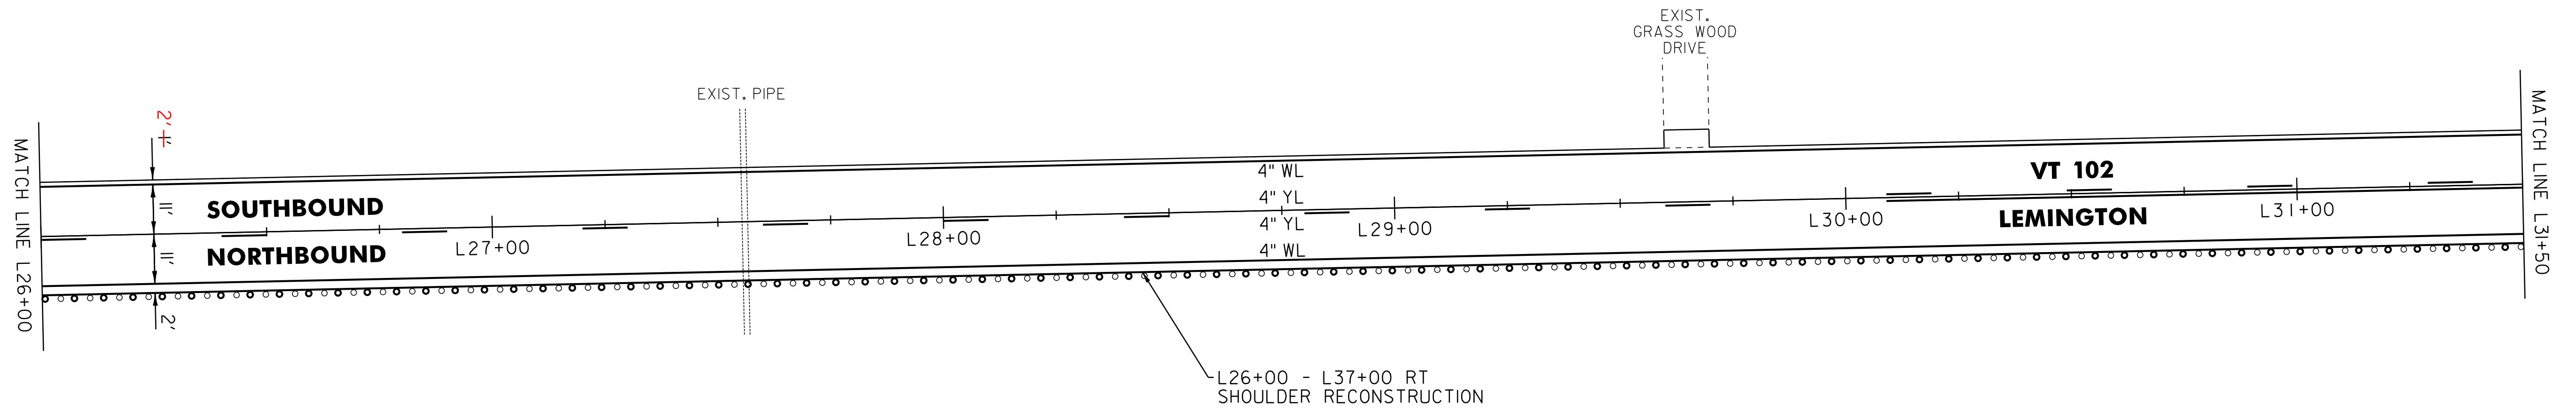

NOT TO SCALE

LEGEND

- R = REMOVE EXISTING
- S = SALVAGE
- R&S = REMOVE AND SALVAGE
- N = NEW
- RET = RETAIN
- B-B = BACK TO BACK
- = EXISTING GUARDRAIL
- |— = PROPOSED GUARDRAIL
- YL = YELLOW LINE
- WL = WHITE LINE
- = DELINEATOR

ROADWAY LAYOUT 38

PROJECT NAME: BLOOMFIELD-LEMINGTON

PROJECT NUMBER: STP 2610(I)

FILE NAME: /pave/06c052/pc052

PROJECT LEADER: PTS

DESIGNED BY: NULL

IPARM FILE NAME: 06C052.52

PLOT DATE: 19-JUN-2013 17:00

DRAWN BY: SNG

CHECKED BY: PTS

SHEET 52 OF 82