

646.602 TEMPORARY 4" WHITE LINE, PAINT
 646.402 DURABLE 4" WHITE LINE, THERMOPLASTIC OR
 646.403 DURABLE 4" WHITE LINE, EPOXY PAINT OR
 646.404 DURABLE 4" WHITE LINE, POLYUREA,
 L37+00 TO L47+50 SOLID LT & RT

646.612 TEMPORARY 4" YELLOW LINE, PAINT
 646.412 DURABLE 4" YELLOW LINE, THERMOPLASTIC OR
 646.413 DURABLE 4" YELLOW LINE, EPOXY PAINT OR
 646.414 DURABLE 4" YELLOW LINE, POLYUREA,
 L37+00 TO L38+00 DASHED LT, SOLID RT
 L38+00 TO L47+50 SOLID LT & RT

621.20 STEEL BEAM GUARDRAIL, GALVANIZED
 L37+00 TO L37+54.5 RT
 L46+11 TO L47+50 RT

621.205 STEEL BEAM GUARDRAIL,
 GALVANIZED W/8' POSTS
 L37+54.5 TO L44+92 RT

621.50 MANUFACTURED
 TERMINAL SECTION, FLARED
 L44+92 TO L45+29.5 RT

621.51 MANUFACTURED
 TERMINAL SECTION, TANGENT
 L45+61 TO L46+11 RT



621.80 REMOVAL AND DISPOSAL OF GUARDRAIL
 L37+00 TO L44+99 RT
 L45+61 TO L47+50 RT

621.81 REMOVAL AND
 DISPOSAL OF GUIDE POSTS
 L44+99 TO L45+38 RT (5 POSTS)

676.12 REMOVAL OF EXISTING DELINEATOR
 L42+57 LT


900.620 SPECIAL PROVISION
 (DELINEATOR WITH STEEL POST)
 L45+29.5 RT
 L45+61 RT

L37+10 LT

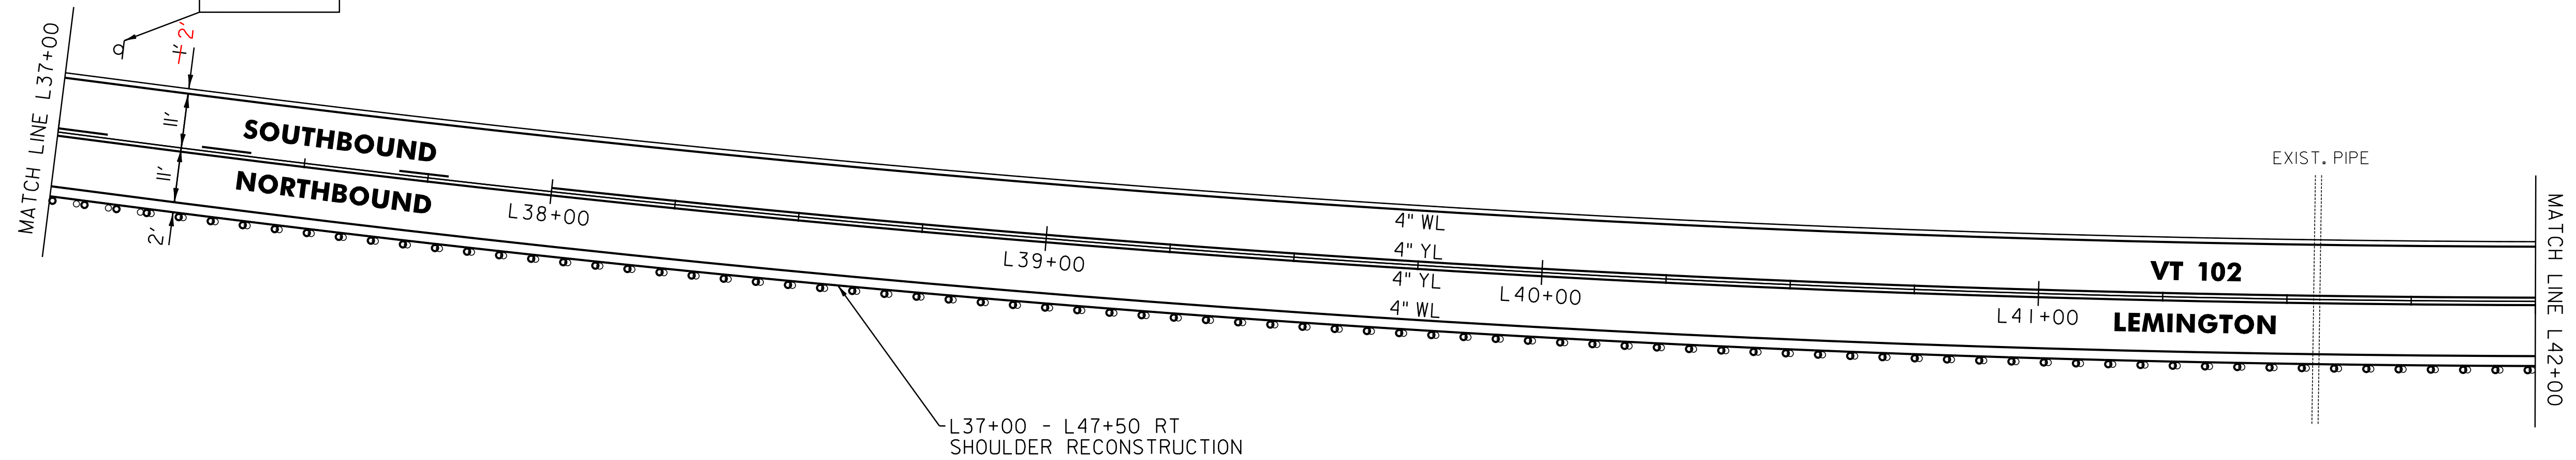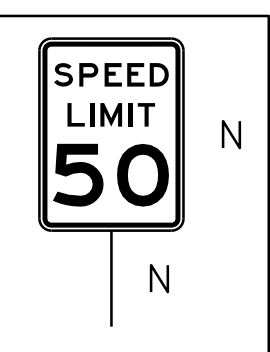


L37+00 - L47+50 RT
 SHOULDER RECONSTRUCTION

L42+57 LT SIGN MISSING
 IPOST TO BE REMOVED
 USING REMOVAL OF EXISTING
 DELINEATOR

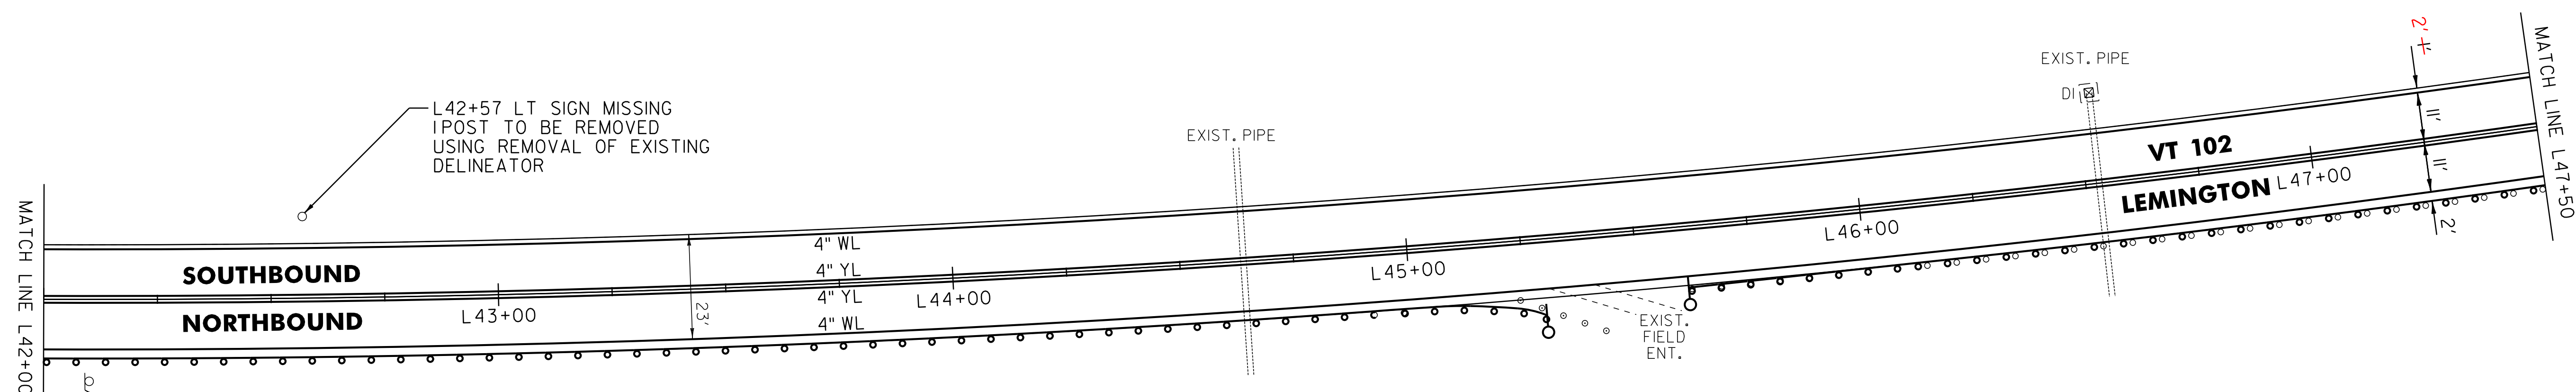

L42+10 RT

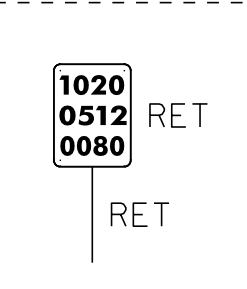

LEGEND

- R = REMOVE EXISTING
- S = SALVAGE
- R&S = REMOVE AND SALVAGE
- N = NEW
- RET = RETAIN
- B-B = BACK TO BACK
- = EXISTING GUARDRAIL
- |— = PROPOSED GUARDRAIL
- YL = YELLOW LINE
- WL = WHITE LINE
- = DELINEATOR

ROADWAY LAYOUT 39

PROJECT NAME:	BLOOMFIELD-LEMINGTON	FILE NAME:	/pave/06c052/pc052	PLOT DATE:	19-JUN-2013 17:00
PROJECT NUMBER:	STP 2610(I)	PROJECT LEADER:	PTS	DRAWN BY:	SNG
		DESIGNED BY:	NLL	CHECKED BY:	PTS
		IPARM FILE NAME:	06C052.53	SHEET	53 OF 82

NOT TO SCALE