

646.602 TEMPORARY 4" WHITE LINE, PAINT
 646.402 DURABLE 4" WHITE LINE, THERMOPLASTIC OR
 646.403 DURABLE 4" WHITE LINE, EPOXY PAINT OR
 646.404 DURABLE 4" WHITE LINE, POLYUREA,
 L69+50 TO L80+50 SOLID LT & RT

646.612 TEMPORARY 4" YELLOW LINE, PAINT
 646.412 DURABLE 4" YELLOW LINE, THERMOPLASTIC OR
 646.413 DURABLE 4" YELLOW LINE, EPOXY PAINT OR
 646.414 DURABLE 4" YELLOW LINE, POLYUREA,
 L69+50 TO L70+50 DASHED LT, SOLID RT
 L70+50 TO L78+15 SOLID LT, DASHED RT
 L78+15 TO L80+50 DASHED CL

621.20 STEEL BEAM GUARDRAIL, GALVANIZED
 L70+45.5 TO L76+45.5 RT


621.50 MANUFACTURED
 TERMINAL SECTION, FLARED
 L70+08 TO L70+45.5 RT
 L76+45.5 TO L76+83 RT

621.81 REMOVAL AND
 DISPOSAL OF GUIDE POSTS
 L71+41 TO L75+18 RT (43 POSTS)

900.620 SPECIAL PROVISION
 (DELINEATOR WITH STEEL POST)
 L70+08 RT
 L76+83 RT

676.12 REMOVAL OF EXISTING DELINEATOR
 L71+06 LT

675.50 REMOVING SIGNS
 AS SHOWN - 1

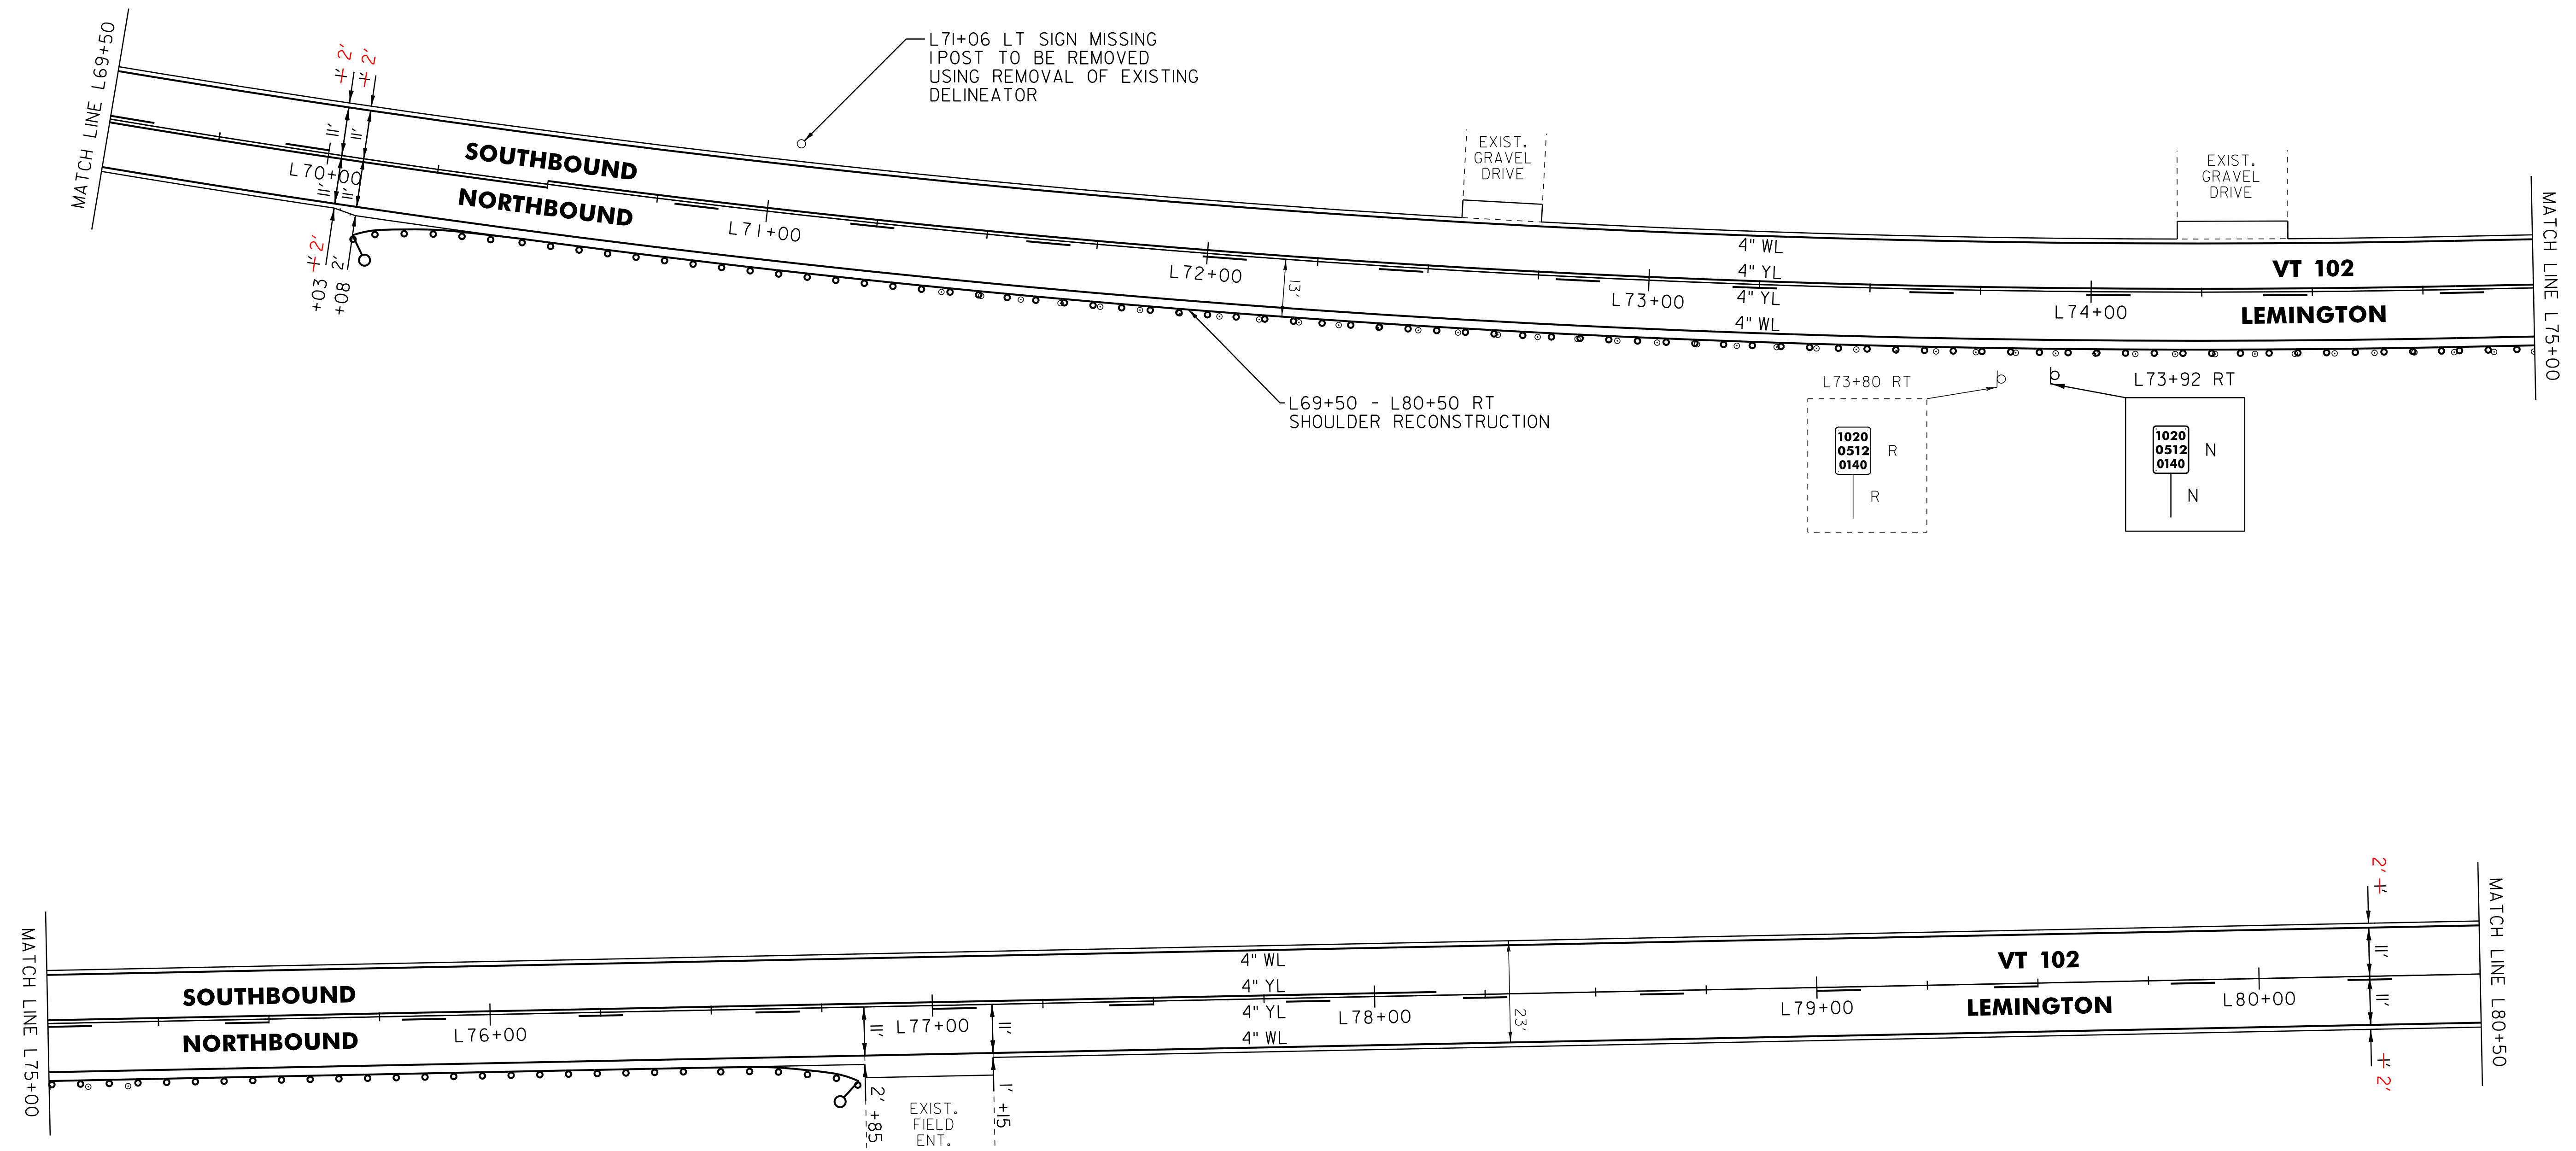

NOT TO SCALE

LEGEND

R	=	REMOVE EXISTING
S	=	SALVAGE
R&S	=	REMOVE AND SALVAGE
N	=	NEW
RET	=	RETAIN
B-B	=	BACK TO BACK
	=	EXISTING GUARDRAIL
	=	PROPOSED GUARDRAIL
YL	=	YELLOW LINE
WL	=	WHITE LINE
	=	DELINEATOR

ROADWAY LAYOUT 42

PROJECT NAME: BLOOMFIELD-LEMINGTON
 PROJECT NUMBER: STP 2610(I)

FILE NAME: /pave/06c052/pc052	PLOT DATE: 19-JUN-2013 17:00
PROJECT LEADER: PTS	DRAWN BY: SNG
DESIGNED BY: NLL	CHECKED BY: PTS
IPARM FILE NAME: 06C052.56	SHEET 56 OF 82