

646.602 TEMPORARY 4" WHITE LINE, PAINT
 646.402 DURABLE 4" WHITE LINE, THERMOPLASTIC OR
 646.403 DURABLE 4" WHITE LINE, EPOXY PAINT OR
 646.404 DURABLE 4" WHITE LINE, POLYUREA,
 L116+00 TO L127+00 SOLID LT & RT

646.612 TEMPORARY 4" YELLOW LINE, PAINT
 646.412 DURABLE 4" YELLOW LINE, THERMOPLASTIC OR
 646.413 DURABLE 4" YELLOW LINE, EPOXY PAINT OR
 646.414 DURABLE 4" YELLOW LINE, POLYUREA,
 L116+00 TO L127+00 SOLID LT & RT

621.20 STEEL BEAM GUARDRAIL, GALVANIZED
 L117+01 TO L117+38.5 RT
 L118+93 TO L119+05.5 RT


621.50 MANUFACTURED
 TERMINAL SECTION, FLARED
 L116+63.5 TO L117+01 RT
 L119+05.5 TO L119+43 RT

621.79 ADJUST HEIGHT OF GUARDRAIL
 L117+38.5 TO L118+93 RT

621.80 REMOVAL AND DISPOSAL OF GUARDRAIL
 L117+01 TO L117+38.5 RT
 L118+93 TO L119+43 RT

900.620 SPECIAL PROVISION
 (DELINEATOR WITH STEEL POST)
 L116.63.5 RT
 L119+43 RT

676.12 REMOVAL OF EXISTING DELINEATOR
 L124+64 RT

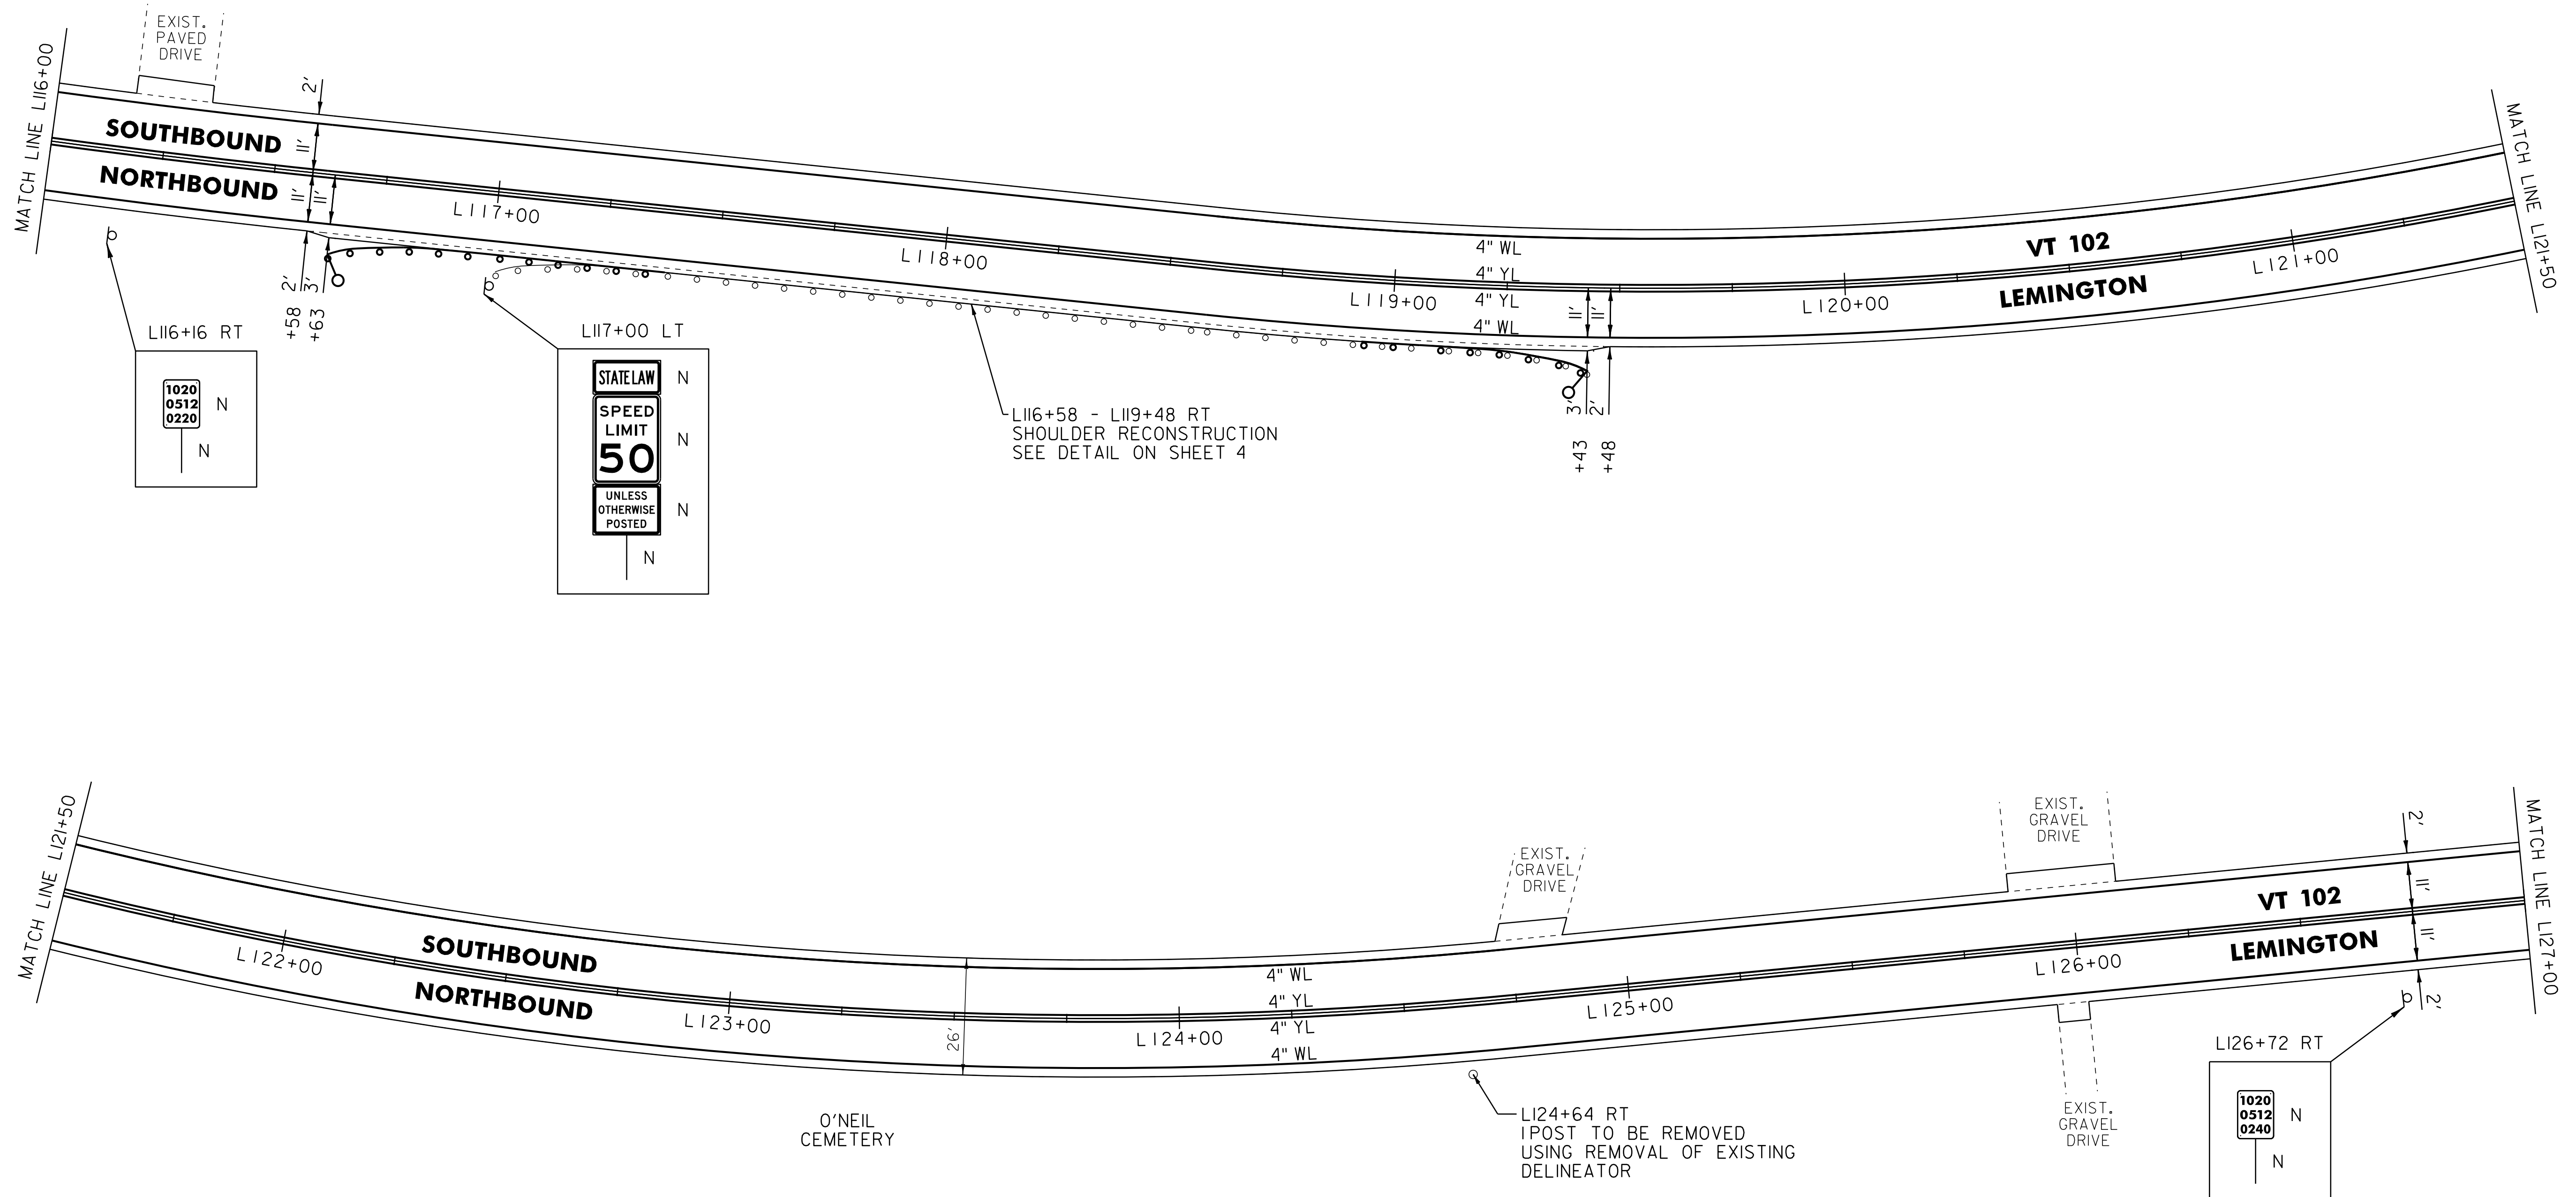

LEGEND

- R = REMOVE EXISTING
- S = SALVAGE
- R&S = REMOVE AND SALVAGE
- N = NEW
- RET = RETAIN
- B-B = BACK TO BACK
- = EXISTING GUARDRAIL
- = PROPOSED GUARDRAIL
- YL = YELLOW LINE
- WL = WHITE LINE
- = DELINEATOR

ROADWAY LAYOUT 48

PROJECT NAME: BLOOMFIELD-LEMINGTON

PROJECT NUMBER: STP 2610(I)

FILE NAME: /pave/06c052/pc052

PROJECT LEADER: PTS

DESIGNED BY: NLL

IPARM FILE NAME: 06C052.62

PLOT DATE: 19-JUN-2013 17:00

DRAWN BY: SNG

CHECKED BY: PTS

SHEET 62 OF 82

NOT TO SCALE