


646.602 TEMPORARY 4" WHITE LINE, PAINT
 646.402 DURABLE 4" WHITE LINE, THERMOPLASTIC OR
 646.403 DURABLE 4" WHITE LINE, EPOXY PAINT OR
 646.404 DURABLE 4" WHITE LINE, POLYUREA,
 L138+00 TO L148+50 SOLID LT & RT
 646.612 TEMPORARY 4" YELLOW LINE, PAINT
 646.412 DURABLE 4" YELLOW LINE, THERMOPLASTIC OR
 646.413 DURABLE 4" YELLOW LINE, EPOXY PAINT OR
 646.414 DURABLE 4" YELLOW LINE, POLYUREA,
 L138+00 TO L140+18 SOLID LT & RT
 L140+18 TO L147+84 SOLID LT, DASHED RT
 L147+84 TO L148+50 DASHED CL

621.20 STEEL BEAM GUARDRAIL, GALVANIZED
 L146+86.5 TO L147+11.5 RT
 621.50 MANUFACTURED
 TERMINAL SECTION, FLARED
 L146+49 TO L146+86.5 RT
 621.80 REMOVAL AND DISPOSAL OF GUARDRAIL
 L146+74 TO L147+11.5 RT
 900.620 SPECIAL PROVISION
 (DELINEATOR WITH STEEL POST)
 L146+49 RT

675.50 REMOVING SIGNS
 AS SHOWN - 4
 675.60 ERECTING SALVAGED SIGNS
 AS SHOWN - 1

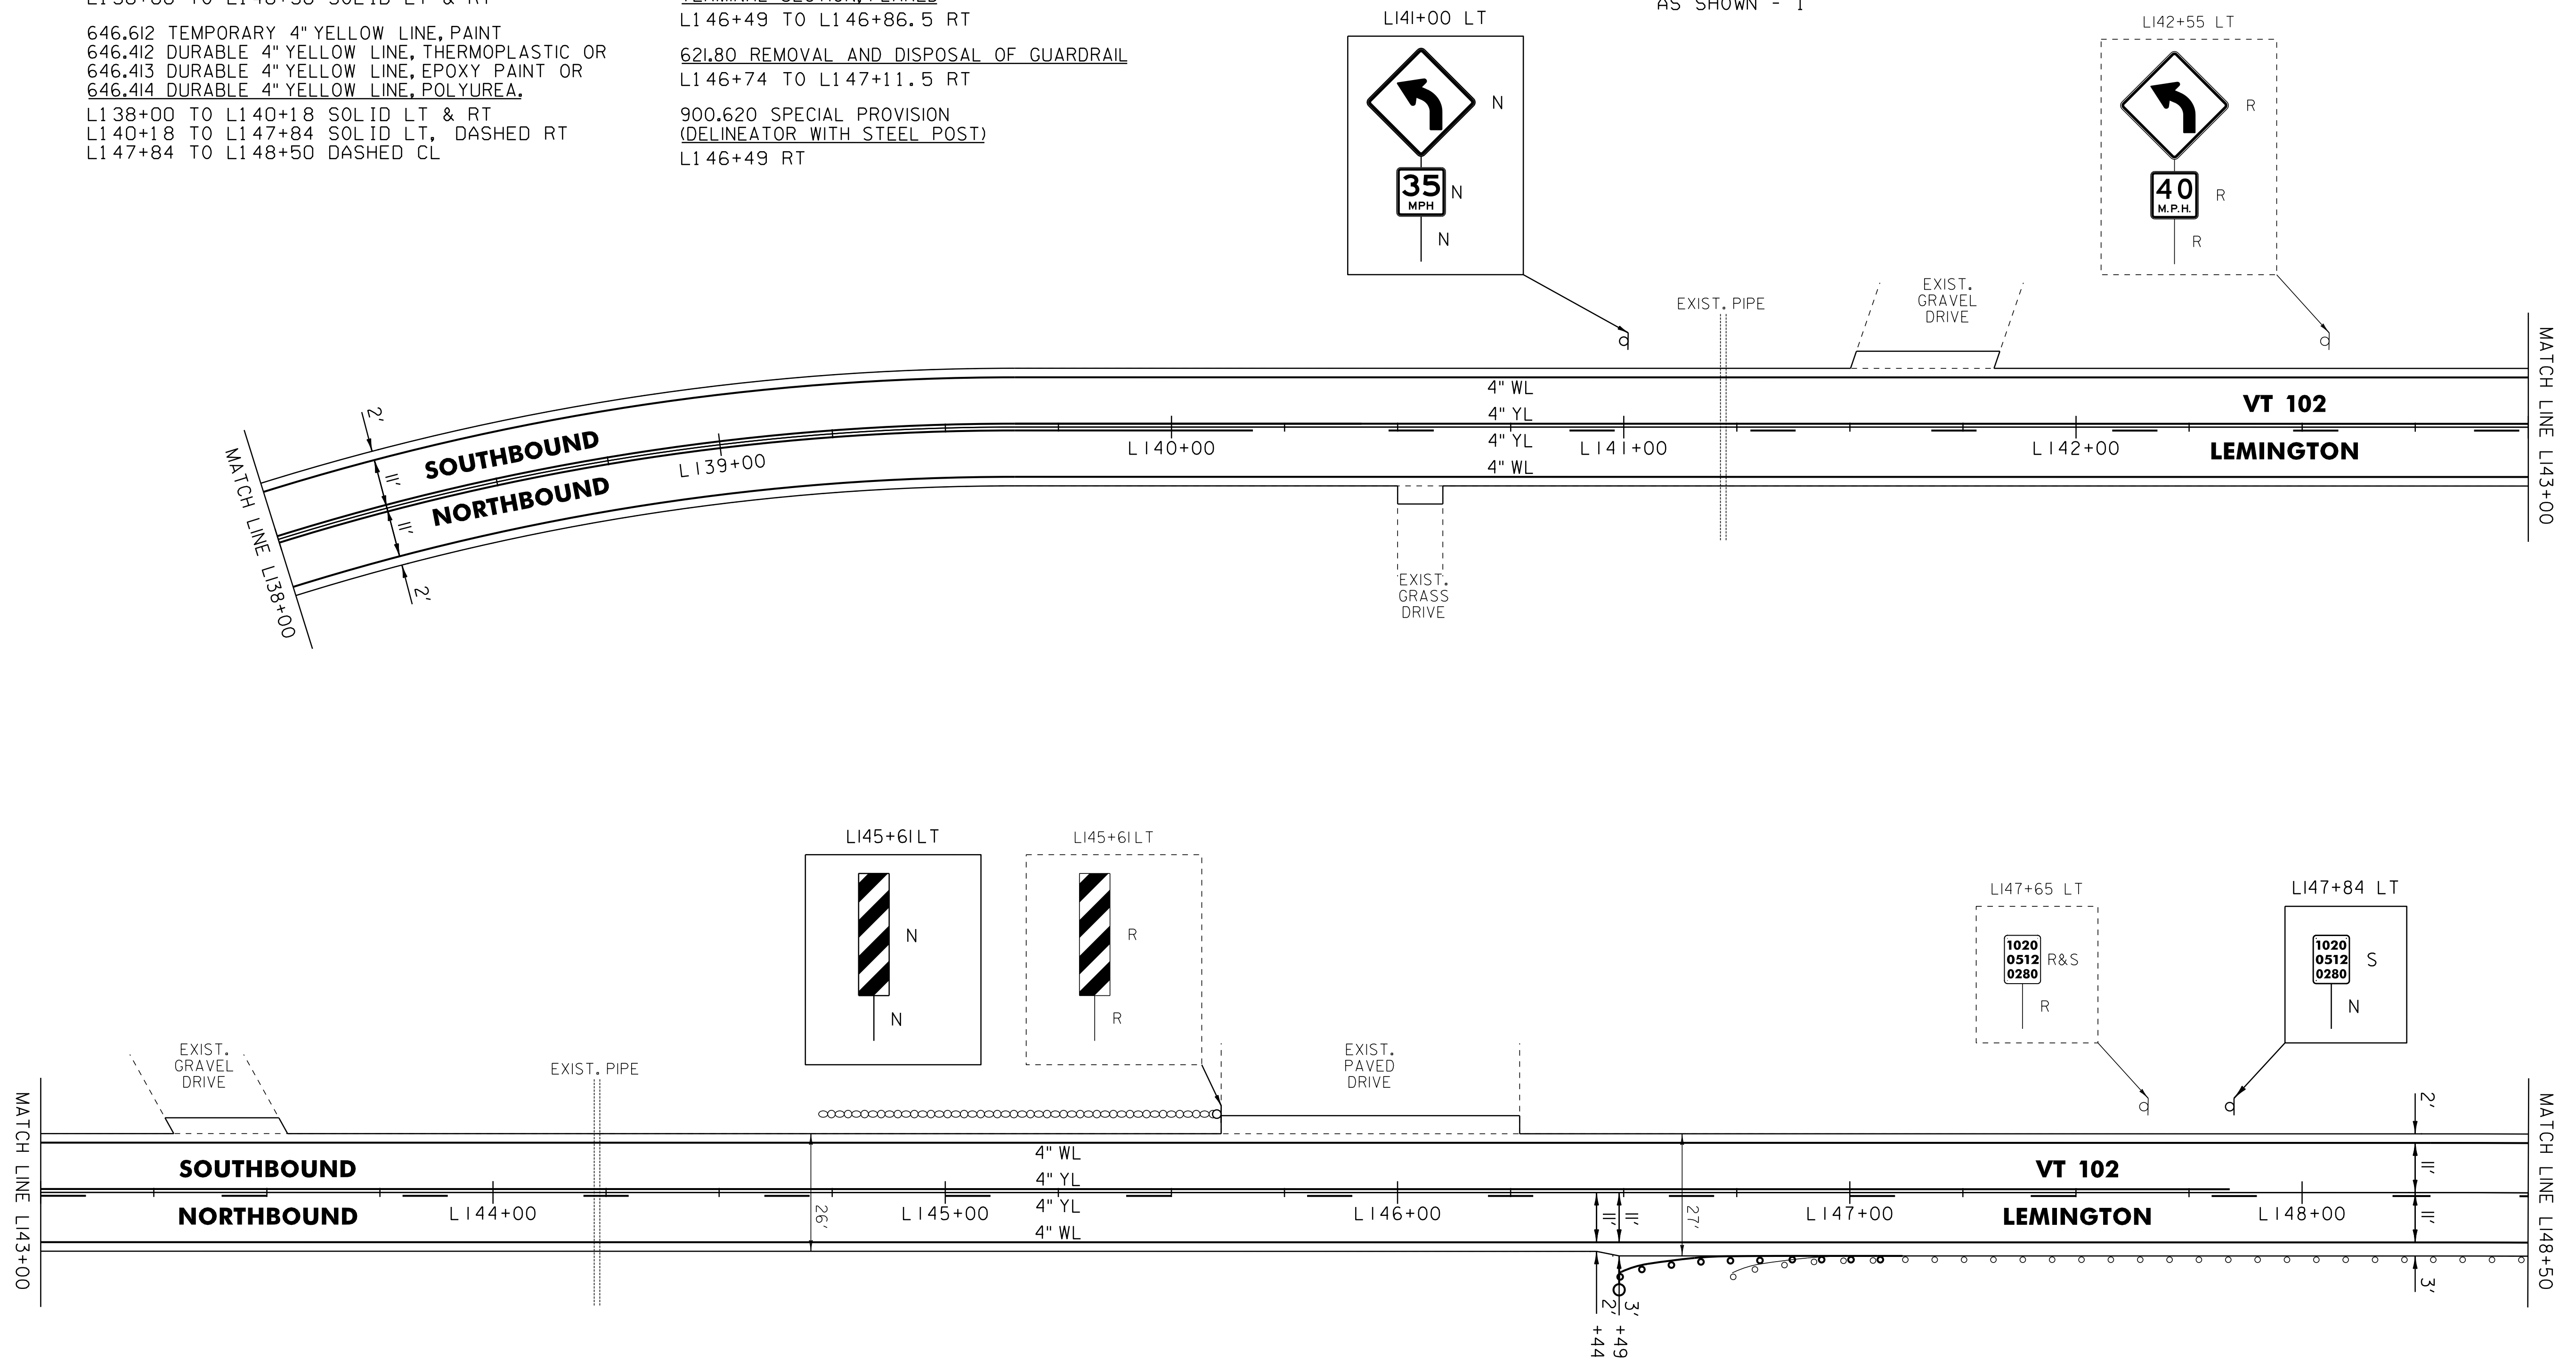

NOT TO SCALE

- LEGEND**
- R = REMOVE EXISTING
 - S = SALVAGE
 - R&S = REMOVE AND SALVAGE
 - N = NEW
 - RET = RETAIN
 - B-B = BACK TO BACK
 - = EXISTING GUARDRAIL
 - |— = PROPOSED GUARDRAIL
 - YL = YELLOW LINE
 - WL = WHITE LINE
 - = DELINEATOR

ROADWAY LAYOUT 51

PROJECT NAME: BLOOMFIELD-LEMINGTON
 PROJECT NUMBER: STP 2610(I)

FILE NAME: /pave/06c052/pc052
 PROJECT LEADER: PTS
 DESIGNED BY: NULL
 IPARM FILE NAME: 06C052.65

PLOT DATE: 19-JUN-2013 17:00
 DRAWN BY: SNG
 CHECKED BY: PTS
 SHEET 65 OF 82