

STATE OF VERMONT  
AGENCY OF TRANSPORTATION




PROPOSED IMPROVEMENT  
TOWNS OF CHESTER AND SPRINGFIELD  
COUNTY OF WINDSOR  
VERMONT ROUTE 11

BEGINNING AT MM 5,222 AT THE INTERSECTION OF VT ROUTE 11 AND  
VT ROUTE 103, IN THE TOWN OF CHESTER AND EXTENDING 6.643 MILES  
EAST TO MM 3,528 IN THE TOWN OF SPRINGFIELD.

LENGTH OF PROJECT = 6.643 MILES  
LENGTH OF ROADWAY = 6.643 MILES

WORK TO BE PERFORMED UNDER THIS PROJECT INCLUDES COLD PLANING, RESURFACING OF  
THE EXISTING HIGHWAY WITH A LEVELING COURSE, WEARING COURSE, NEW PAVEMENT  
MARKINGS AND INCIDENTAL ITEMS AS SHOWN IN THE PROJECT QUANTITIES.

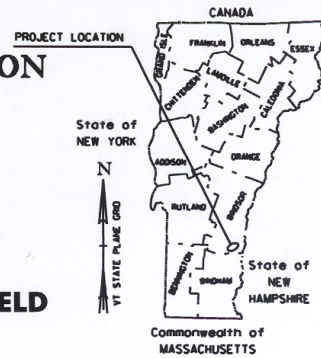

**RECORD PLANS**

CONTRACTOR: THE LANE CONSTRUCTION CORP.  
MERIDAN, CT  
RESIDENT ENGINEER: GERALD COLBY  
CONSTRUCTION BEGAN: SEPTEMBER 3, 2008  
CONSTRUCTION COMPLETED: OCTOBER 17, 2008  
RECORD PLANS BY: G. COLBY & C. PIERCE

I HEREBY CERTIFY THAT ALL THE CONSTRUCTION REQUIRED BY  
THIS SET OF DRAWINGS HAS BEEN ACCOMPLISHED AS INDICATED  
HEREIN.

BY: *[Signature]*, RESIDENT ENGINEER

DATE: 4/30/09

NOTE: ANY FURTHER INFORMATION CONCERNING FINAL QUANTITIES,  
AMOUNTS OR OTHER DETAILS RELATIVE TO THIS PROJECT MAY BE  
FOUND IN ELECTRONIC ARCHIVE AT VAOT CENTRAL FILES.

**SUPERPAVE BITUMINOUS CONCRETE PAVEMENT  
MIXTURE DESIGN CRITERIA**

DESIGN LIFE/DESIGN LANE ESAL	1,460,000
DESIGN NUMBER OF GYRATIONS	65
PERFORMANCE GRADED ASPHALT BINDER	58-28

THESE PLANS ARE SUBJECT TO SUCH ENGINEERING  
CHANGES AS MAY BE REQUIRED BY THE FEDERAL HIGHWAY  
ADMINISTRATION OR THE DIRECTOR OF PROGRAM DEVELOPMENT.  
CONSTRUCTION IS TO BE CARRIED ON IN ACCORDANCE  
WITH THESE PLANS AND THE STANDARD SPECIFICATIONS  
FOR CONSTRUCTION DATED 2006, AS APPROVED BY THE  
FEDERAL HIGHWAY ADMINISTRATION ON JANUARY 15, 2006  
FOR USE ON THIS PROJECT, INCLUDING ALL SUBSEQUENT  
REVISIONS AND SUCH REVISED SPECIFICATIONS AND  
SPECIAL PROVISIONS AS ARE INCORPORATED IN THESE PLANS.

**DISTRICT PLANS**

DIRECTOR OF PROGRAM DEVELOPMENT

APPROVED \_\_\_\_\_ DATE \_\_\_\_\_

PROJECT MANAGER: TED DOMEY

PROJECT CHESTER - SPRINGFIELD  
ST 2612(1)

SHEET  OF  SHEETS

**TRAFFIC DATA**

VT ROUTE 11	AADT		ESALS	
	2008	2018	2008-2018	2008-2028
SECTION #1 (BEGIN PROJECT TO MM 1,457)	4100	4600	906,000	2,108,000
SECTION #2 (MM 1,457 TO MM 2,666)	5300	5800	842,000	1,936,000
SECTION #2 (MM 2,666 TO END PROJECT)	5800	6400	1,125,000	2,920,000