


CHESTER

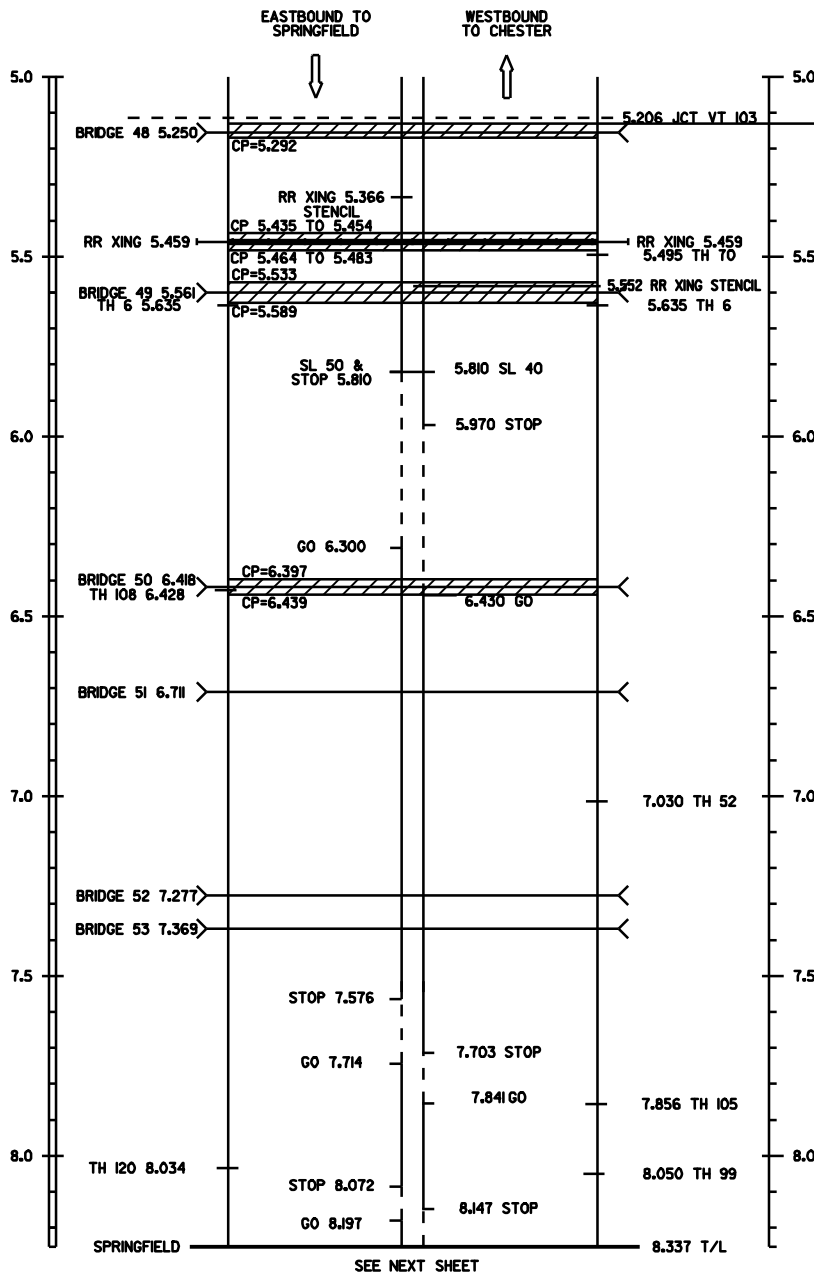

BEGIN ST 2612(I)
MM 5.222

646.21 4 INCH YELLOW LINE
646.612 TEMPORARY 4 INCH YELLOW LINE, PAINT
 MM 5.222 TO MM 5.810 RT, SOLID
 MM 5.222 TO MM 5.970 LT, SOLID
 MM 5.810 TO MM 6.300 RT, DASHED
 MM 5.970 TO MM 6.430 LT, DASHED
 MM 6.300 TO MM 7.576 RT, SOLID
 MM 6.430 TO MM 7.703 LT, SOLID
 MM 7.576 TO MM 7.714 RT, DASHED
 MM 7.703 TO MM 7.841 LT, DASHED
 MM 7.714 TO MM 8.072 RT, SOLID
 MM 7.841 TO MM 8.147 LT, SOLID
 MM 8.072 TO MM 8.197 RT, DASHED
 MM 8.147 TO MM 8.252-MM 0.000 LT, DASHED
 MM 8.197 TO MM 8.252-MM 0.000 RT, SOLID

646.20 4 INCH WHITE LINE
646.602 TEMPORARY 4 INCH WHITE LINE, PAINT
 MM 5.222 TO MM 8.252-MM 0.000 LT & RT, SOLID

646.26 24 INCH STOP BAR
646.682 TEMPORARY 24 INCH STOP BAR, PAINT
 MM 5.208 LT
 MM 5.361 RT
 MM 5.371 RT
 MM 5.456 RT
 MM 5.462 LT
 MM 5.547 LT
 MM 5.557 LT

646.31 CROSSWALK MARKING
646.702 TEMPORARY CROSSWALK MARKING, PAINT
 MM 5.208 LT & RT

646.32 RAILROAD CROSSING SYMBOL
 MM 5.377 RT
 MM 5.563 LT

604.412 REHAB. DROP INLETS, CATCH BASINS, OR MANHOLES, CLASS I
604.415 REHAB. DROP INLETS, CATCH BASINS, OR MANHOLES, CLASS II
604.418 REHAB. DROP INLETS, CATCH BASINS, OR MANHOLES, CLASS III
 MM 5.211 RT I * EACH LOCATION SHALL BE INSPECTED BY THE
 MM 5.211 LT I RESIDENT ENGINEER, WHO WILL THEN DETERMINE
 MM 6.437 LT I WHICH LOCATION REQUIRES WHICH TREATMENT.
 MM 6.500 LT II
 MM 6.612 LT II
 MM 7.029 RT I
 MM 7.482 RT I
 MM 7.730 RT I
 MM 7.825 RT II

604.42 CHANGING ELEVATION OF SEWER MANHOLES
 MM 5.203 LT
 MM 5.225 LT
 MM 5.243 LT
 MM 5.282 LT
 MM 5.326 LT } BY TOWN OF CHESTER

FOR HOT MIX(AIR VOID) TEST FAILURES.
SEE BOTTOM OF SHEET 8 OF 12.

LEGEND

COLD PLANE AREAS

ONE DAY OF CORES TAKEN FOR ENTIRE PROJECT (EB LANE)

CORE #	MM	OFFSET
1	5.315	7.08 RT
2	5.460	7.80 RT
3	5.629	1.87 RT
4	5.806	2.03 RT
5	5.893	3.55 RT
6	6.155	9.95 RT

PROJECT LAYOUT SHEET #1	PROJECT NAME: CHESTER - SPRINGFIELD
	PROJECT NUMBER: ST 2612 (I)
	FILE NAME: ...06C054\...06C054.dgn
	PROJECT MANAGER: T. DOMEY
DESIGNED BY: HUNT	PLOT DATE: 18-MAY-2009 10:4
IPARM FILE NAME: 06C054pl1.l	DRAWN BY: HUNT
	CHECKED BY: PAVT MGMT
	SHEET 10 OF 12