


SPRINGFIELD

EASTBOUND TO SPRINGFIELD WESTBOUND TO CHESTER



SEE PREVIOUS SHEET

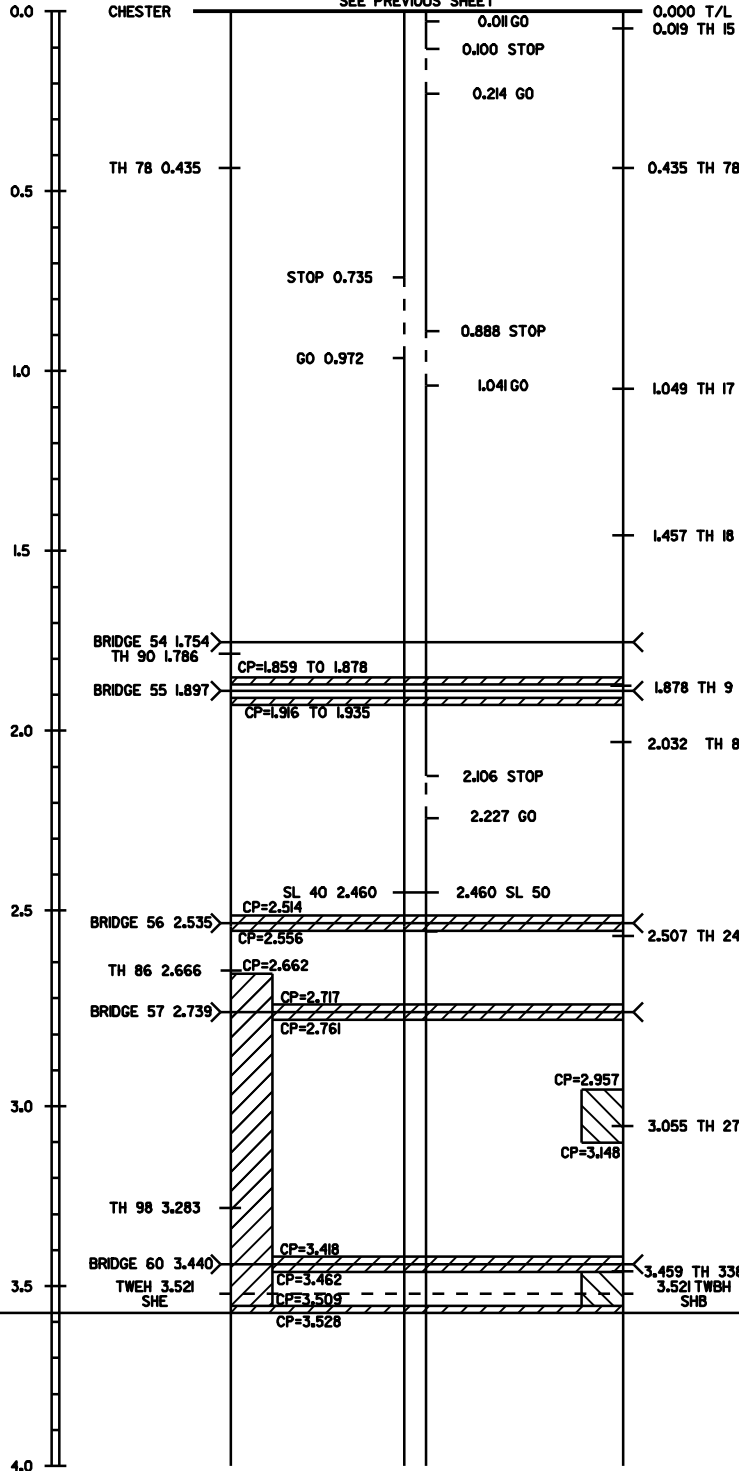

646.21 4 INCH YELLOW LINE
646.612 TEMPORARY 4 INCH YELLOW LINE PAINT
 MM 0.000 TO MM 0.011 LT, DASHED
 MM 0.000 TO MM 0.735 RT, SOLID
 MM 0.011 TO MM 0.100 LT, SOLID
 MM 0.100 TO MM 0.214 LT, DASHED
 MM 0.214 TO MM 0.888 LT, SOLID
 MM 0.735 TO MM 0.972 RT, DASHED
 MM 0.888 TO MM 1.041 LT, DASHED
 MM 0.972 TO MM 3.528 RT, SOLID
 MM 1.041 TO MM 2.106 LT, SOLID
 MM 2.106 TO MM 2.227 LT, DASHED
 MM 2.227 TO MM 3.528 LT, SOLID

646.20 4 INCH WHITE LINE
646.602 TEMPORARY 4 INCH WHITE LINE PAINT
 MM 0.000 TO MM 3.528 LT&RT, SOLID

604.412 REHAB. DROP INLETS, CATCH BASINS, OR MANHOLES, CLASS I
604.415 REHAB. DROP INLETS, CATCH BASINS, OR MANHOLES, CLASS II
604.418 REHAB. DROP INLETS, CATCH BASINS, OR MANHOLES, CLASS III

MM 1.381 RT II * EACH LOCATION SHALL BE
 MM 1.648 LT II INSPECTED BY THE
 MM 1.716 LT II RESIDENT ENGINEER, WHO
 MM 1.779 LT II WILL THEN DETERMINE
 MM 2.653 LT I WHICH LOCATION REQUIRES
 MM 2.661 RT I WHICH TREATMENT.
 MM 2.778 RT I
 MM 2.900 RT I
 MM 2.957 RT I
 MM 3.029 LT II
 MM 3.033 RT I
 MM 3.063 LT I
 MM 3.078 LT I
 MM 3.108 RT I
 MM 3.108 LT I
 MM 3.403 RT I
 MM 3.440 RT I
 MM 3.477 LT I
 FAIRGROUND RD LT I

629.20 ADJUST ELEVATION OF VALVE BOX
 MM 2.908 (3 EA) RT
 MM 3.059 (3 EA) RT

604.42 CHANGING ELEVATION OF SEWER MANHOLES
 MM 2.534 LT
 MM 2.598 LT
 MM 3.371 LT
 MM 2.50 LT
 MM 2.52 LT

****FOR HOT MIX (AIR VOIDS) TEST FAILURES. SEE BOTTOM OF PAGE 8 OF 12.**

END ST 2612(I)
 MM 3.528

LEGEND

COLD PLANE AREAS

PROJECT LAYOUT SHEET #2

PROJECT NAME: CHESTER - SPRINGFIELD
 PROJECT NUMBER: ST 2612 (I)

FILE NAME: ...06C054\...06C054.dgn PLOT DATE: 18-MAY-2009 10:4
 PROJECT MANAGER: T. DOMEY DRAWN BY: HUNT
 DESIGNED BY: HUNT CHECKED BY: PAVT MGMT
 IPARM FILE NAME: 06C054pl2.1 SHEET II OF 12