

646.402 DURABLE 4 INCH WHITE LINE, THERMOPLASTIC
 (ALL LINES WILL INCLUDE EDGE LINE BREAKS AND
 RADIUS FOR TOWN HIGHWAYS)
 FAIR HAVEN:
 STA 2+15.00 - STA 5+00.00 LT & RT


646.602 TEMPORARY 4 INCH WHITE LINE, PAINT
 (ALL LINES WILL INCLUDE EDGE LINE BREAKS AND
 RADIUS FOR TOWN HIGHWAYS)
 FAIR HAVEN:
 STA 2+15.00 - STA 5+00.00 LT & RT

646.452 DURABLE 8 INCH YELLOW LINE, THERMOPLASTIC
 (ALL LINES WILL INCLUDE EDGE LINE BREAKS AND
 RADIUS FOR TOWN HIGHWAYS)
 FAIR HAVEN:
 STA 3+95.00 - STA 5+00.00 LT & RT HATCHED MEDIAN

675.50 REMOVING SIGNS
 AS SHOWN - 6

646.412 DURABLE 4 INCH YELLOW LINE, THERMOPLASTIC
 (ALL LINES WILL INCLUDE C/L BREAKS FOR
 TOWN HIGHWAYS) S=SOLID, D=DASHED
 FAIR HAVEN:
 STA 2+15.00 - STA 3+95.0 LT & RT RAISED MEDIAN
 STA 3+95.00 - STA 5+00.00 DOUBLE SOLID MEDIAN LT & RT

646.612 TEMPORARY 4 INCH YELLOW LINE, PAINT
 (ALL LINES WILL INCLUDE C/L BREAKS FOR
 TOWN HIGHWAYS) S=SOLID, D=DASHED
 FAIR HAVEN:
 STA 2+15.00 - STA 3+95.0 LT & RT RAISED MEDIAN
 STA 3+95.00 - STA 5+00.00 DOUBLE SOLID MEDIAN LT & RT

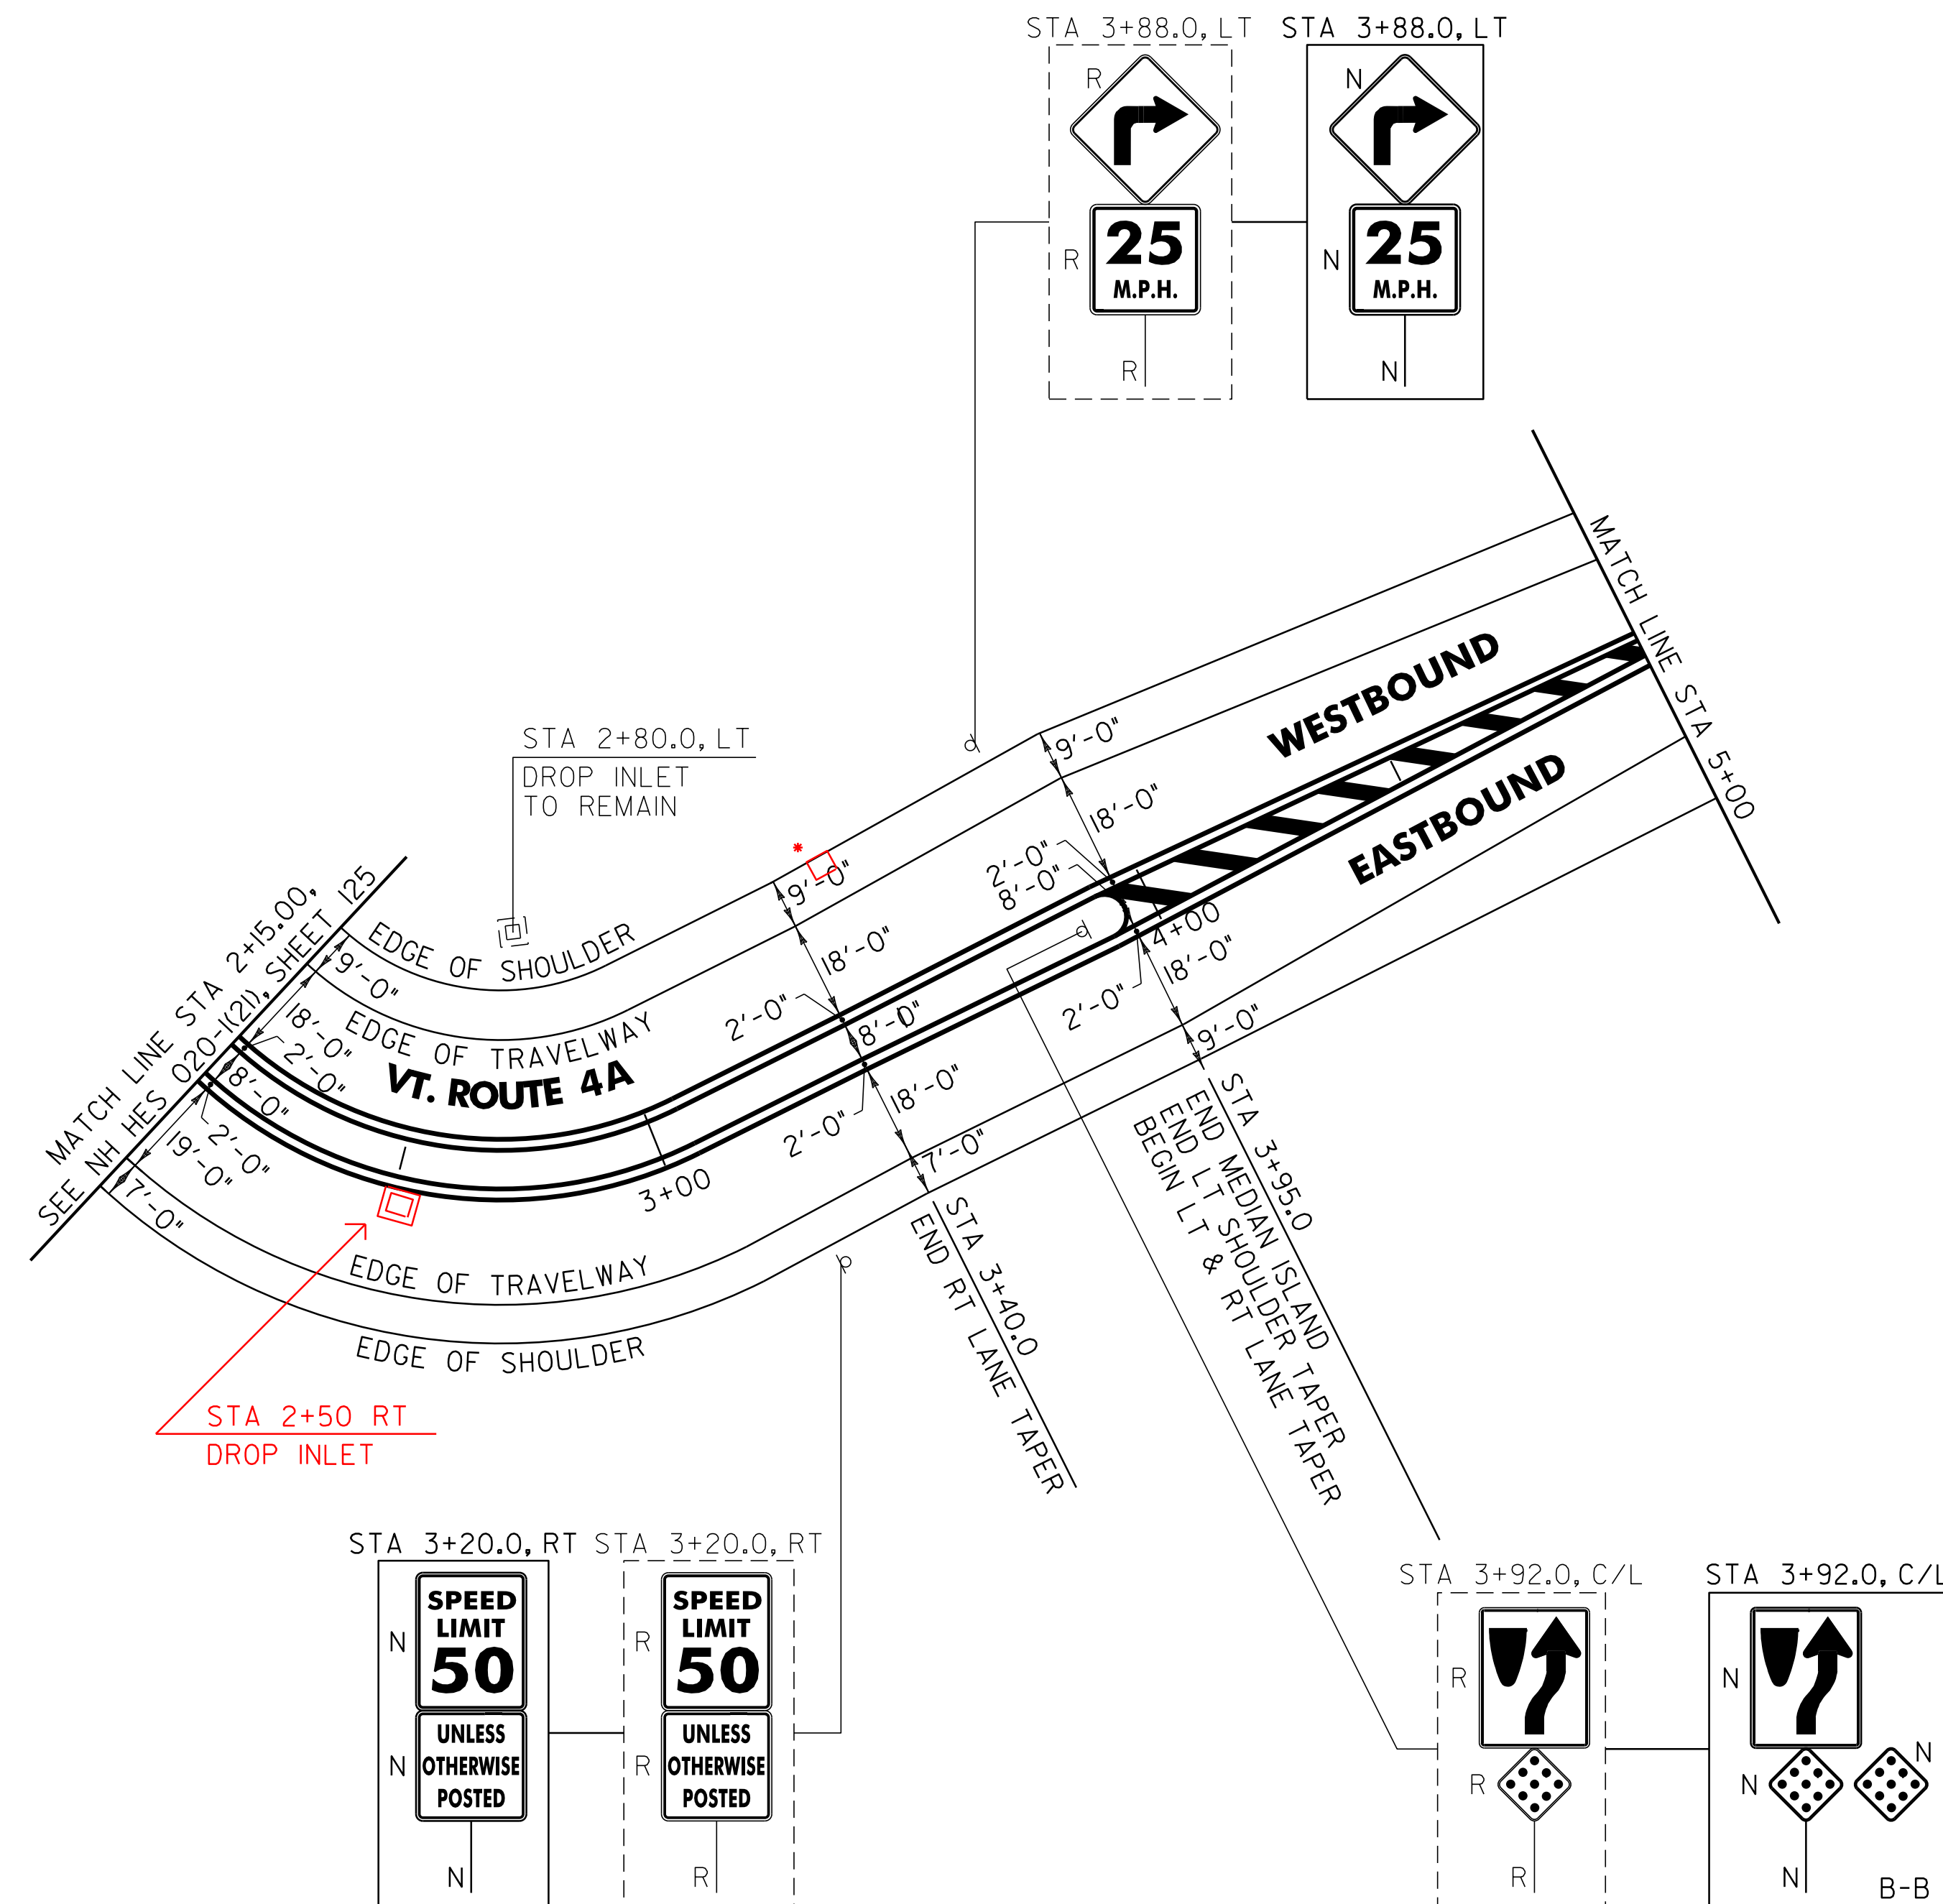

• LIVE ELECTRICAL VAULT NOT ON PLANS DISCOVERED DURING COLD PLANING OPERATION. ASSUMED TO BE SERVICING RTE 4 TRAFFIC LIGHT SYSTEM.

604.412 REHAB DI, CB, OR MH
 STA 2+50 RT
 STA 3+50 RT

SIGN LEGEND
 R = REMOVE
 S = SALVAGE
 N = NEW
 RET = RETAIN
 B-B = BACK TO BACK
 EXISTING = _____
 NEW = _____

NOT TO SCALE

PROJECT LAYOUT SHEET #1

PROJECT NAME: FAIR HAVEN - CASTLETON	FILE NAME: p06c058.dgn	PLOT DATE: 22-FEB-2012 12:4
PROJECT NUMBER: STP 2614(1)S & HES STP 2614(1)S	PROJECT LEADER: D.E.G.	DRAWN BY: C.A.K.
DESIGNED BY: M.J.M.	CHECKED BY: D.E.G.	SHEET 22 OF 157
IPARM FILE: p06c058101.dgn		