


646.402 DURABLE 4 INCH WHITE LINE, THERMOPLASTIC
 (ALL LINES WILL INCLUDE EDGE LINE BREAKS AND
 RADIUS FOR TOWN HIGHWAYS)
 FAIR HAVEN
 STA 12+50.00 - STA 25+00.00 LT & RT

646.412 DURABLE 4 INCH YELLOW LINE, THERMOPLASTIC
 (ALL LINES WILL INCLUDE C/L BREAKS FOR
 TOWN HIGHWAYS) S=SOLID, D=DASHED
 FAIR HAVEN:
 STA 12+50.00 - STA 25+00.00 LT C RT S - S

675.50 REMOVING SIGNS
 AS SHOWN - 8

646.602 TEMPORARY 4 INCH WHITE LINE, PAINT
 (ALL LINES WILL INCLUDE EDGE LINE BREAKS AND
 RADIUS FOR TOWN HIGHWAYS)
 FAIR HAVEN
 STA 12+50.00 - STA 25+00.00 LT & RT

646.612 TEMPORARY 4 INCH YELLOW LINE, PAINT
 (ALL LINES WILL INCLUDE C/L BREAKS FOR
 TOWN HIGHWAYS) S=SOLID, D=DASHED
 FAIR HAVEN:
 STA 12+50.00 - STA 25+00.00 LT C RT S - S

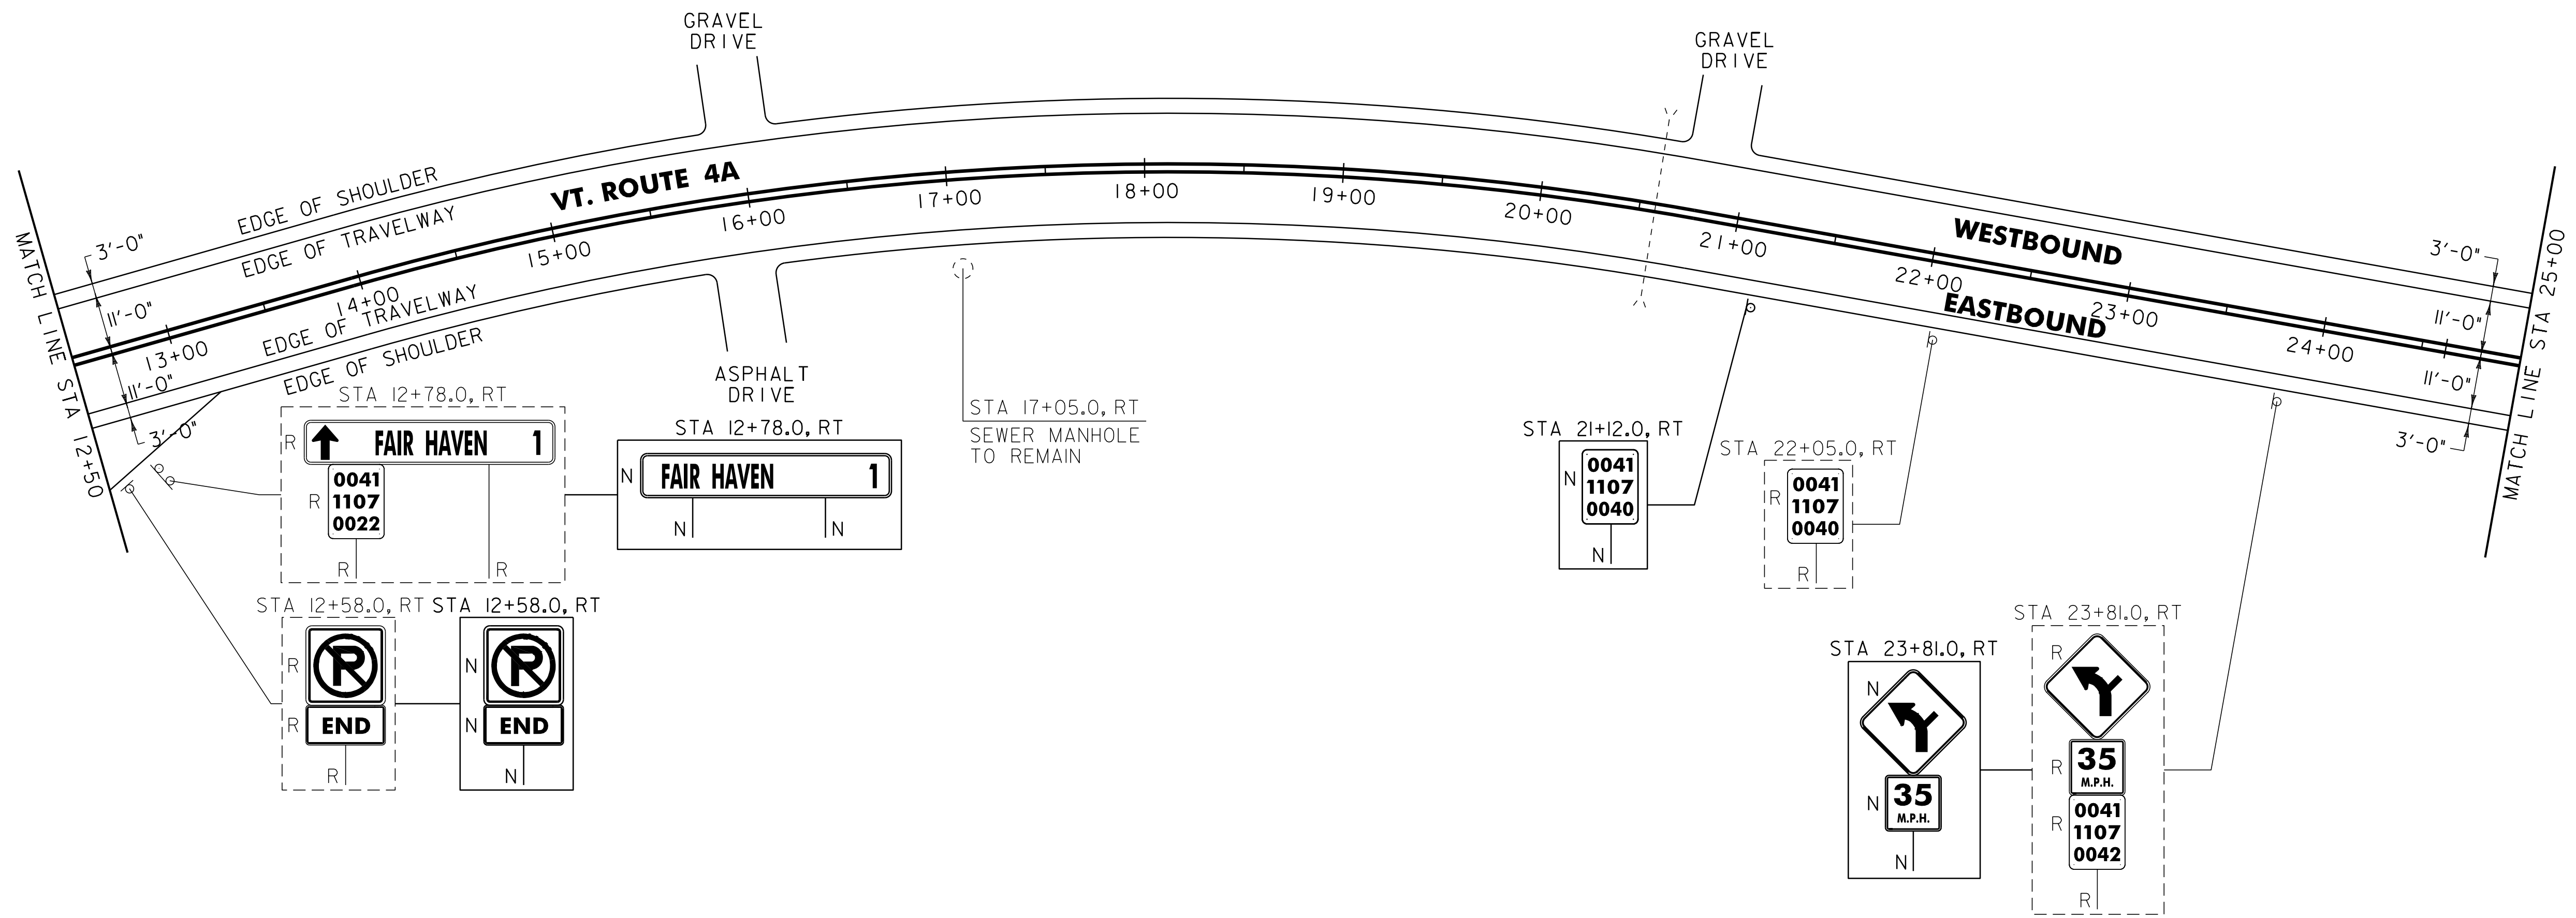

NOTES:
 1. PAVE 2" OF TYPE IVS ASPHALT IN EXISTING WEIGH STATION AREA.
 ANY REQUIRED EXCAVATION OR GRADING SHALL BE PERFORMED
 AS DIRECTED BY THE RESIDENT ENGINEER AND PAID FOR UNDER
 THE APPLICABLE RENTAL ITEM(S).

SIGN LEGEND
 R = REMOVE
 S = SALVAGE
 N = NEW
 RET = RETAIN
 B-B = BACK TO BACK
 EXISTING = - - - - -
 NEW = _____

PROJECT LAYOUT SHEET #3	NOT TO SCALE	
	PROJECT NAME: FAIR HAVEN - CASTLETON	
	PROJECT NUMBER: STP HES 2614(1)S	
	FILE NAME: p06c058.dgn	PLOT DATE: 22-FEB-2012 12:4
DESIGNED BY: M.J.M.	DRAWN BY: C.A.K.	
IPARM FILE: p06c058103.i	CHECKED BY: D.E.G.	
	SHEET 24 OF 157	