

646.402 DURABLE 4 INCH WHITE LINE, THERMOPLASTIC  
 (ALL LINES WILL INCLUDE EDGE LINE BREAKS AND  
 RADIUS FOR TOWN HIGHWAYS)  
 FAIR HAVEN:  
 STA 37+50.00 - STA 49+36.80 LT & RT

646.602 TEMPORARY 4 INCH WHITE LINE, PAINT  
 (ALL LINES WILL INCLUDE EDGE LINE BREAKS AND  
 RADIUS FOR TOWN HIGHWAYS)  
 FAIR HAVEN:  
 STA 37+50.00 - STA 49+36.80 LT & RT


646.412 DURABLE 4 INCH YELLOW LINE, THERMOPLASTIC  
 (ALL LINES WILL INCLUDE C/L BREAKS FOR  
 TOWN HIGHWAYS) S=SOLID, D=DASHED  
 FAIR HAVEN:  
 STA 37+50.00 - STA 49+36.80 LT C RT  
 S - S

646.612 TEMPORARY 4 INCH YELLOW LINE, PAINT  
 (ALL LINES WILL INCLUDE C/L BREAKS FOR  
 TOWN HIGHWAYS) S=SOLID, D=DASHED  
 FAIR HAVEN:  
 STA 37+50.00 - STA 49+36.80 LT C RT  
 S - S

646.512 DURABLE RAILROAD CROSSING SYMBOL, THERMOPLASTIC  
 FAIR HAVEN:  
 STA 46+60.0 LT

646.712 TEMPORARY RAILROAD CROSSING SYMBOL, PAINT  
 FAIR HAVEN:  
 STA 46+60.0 LT

675.50 REMOVING SIGNS  
 AS SHOWN - 10

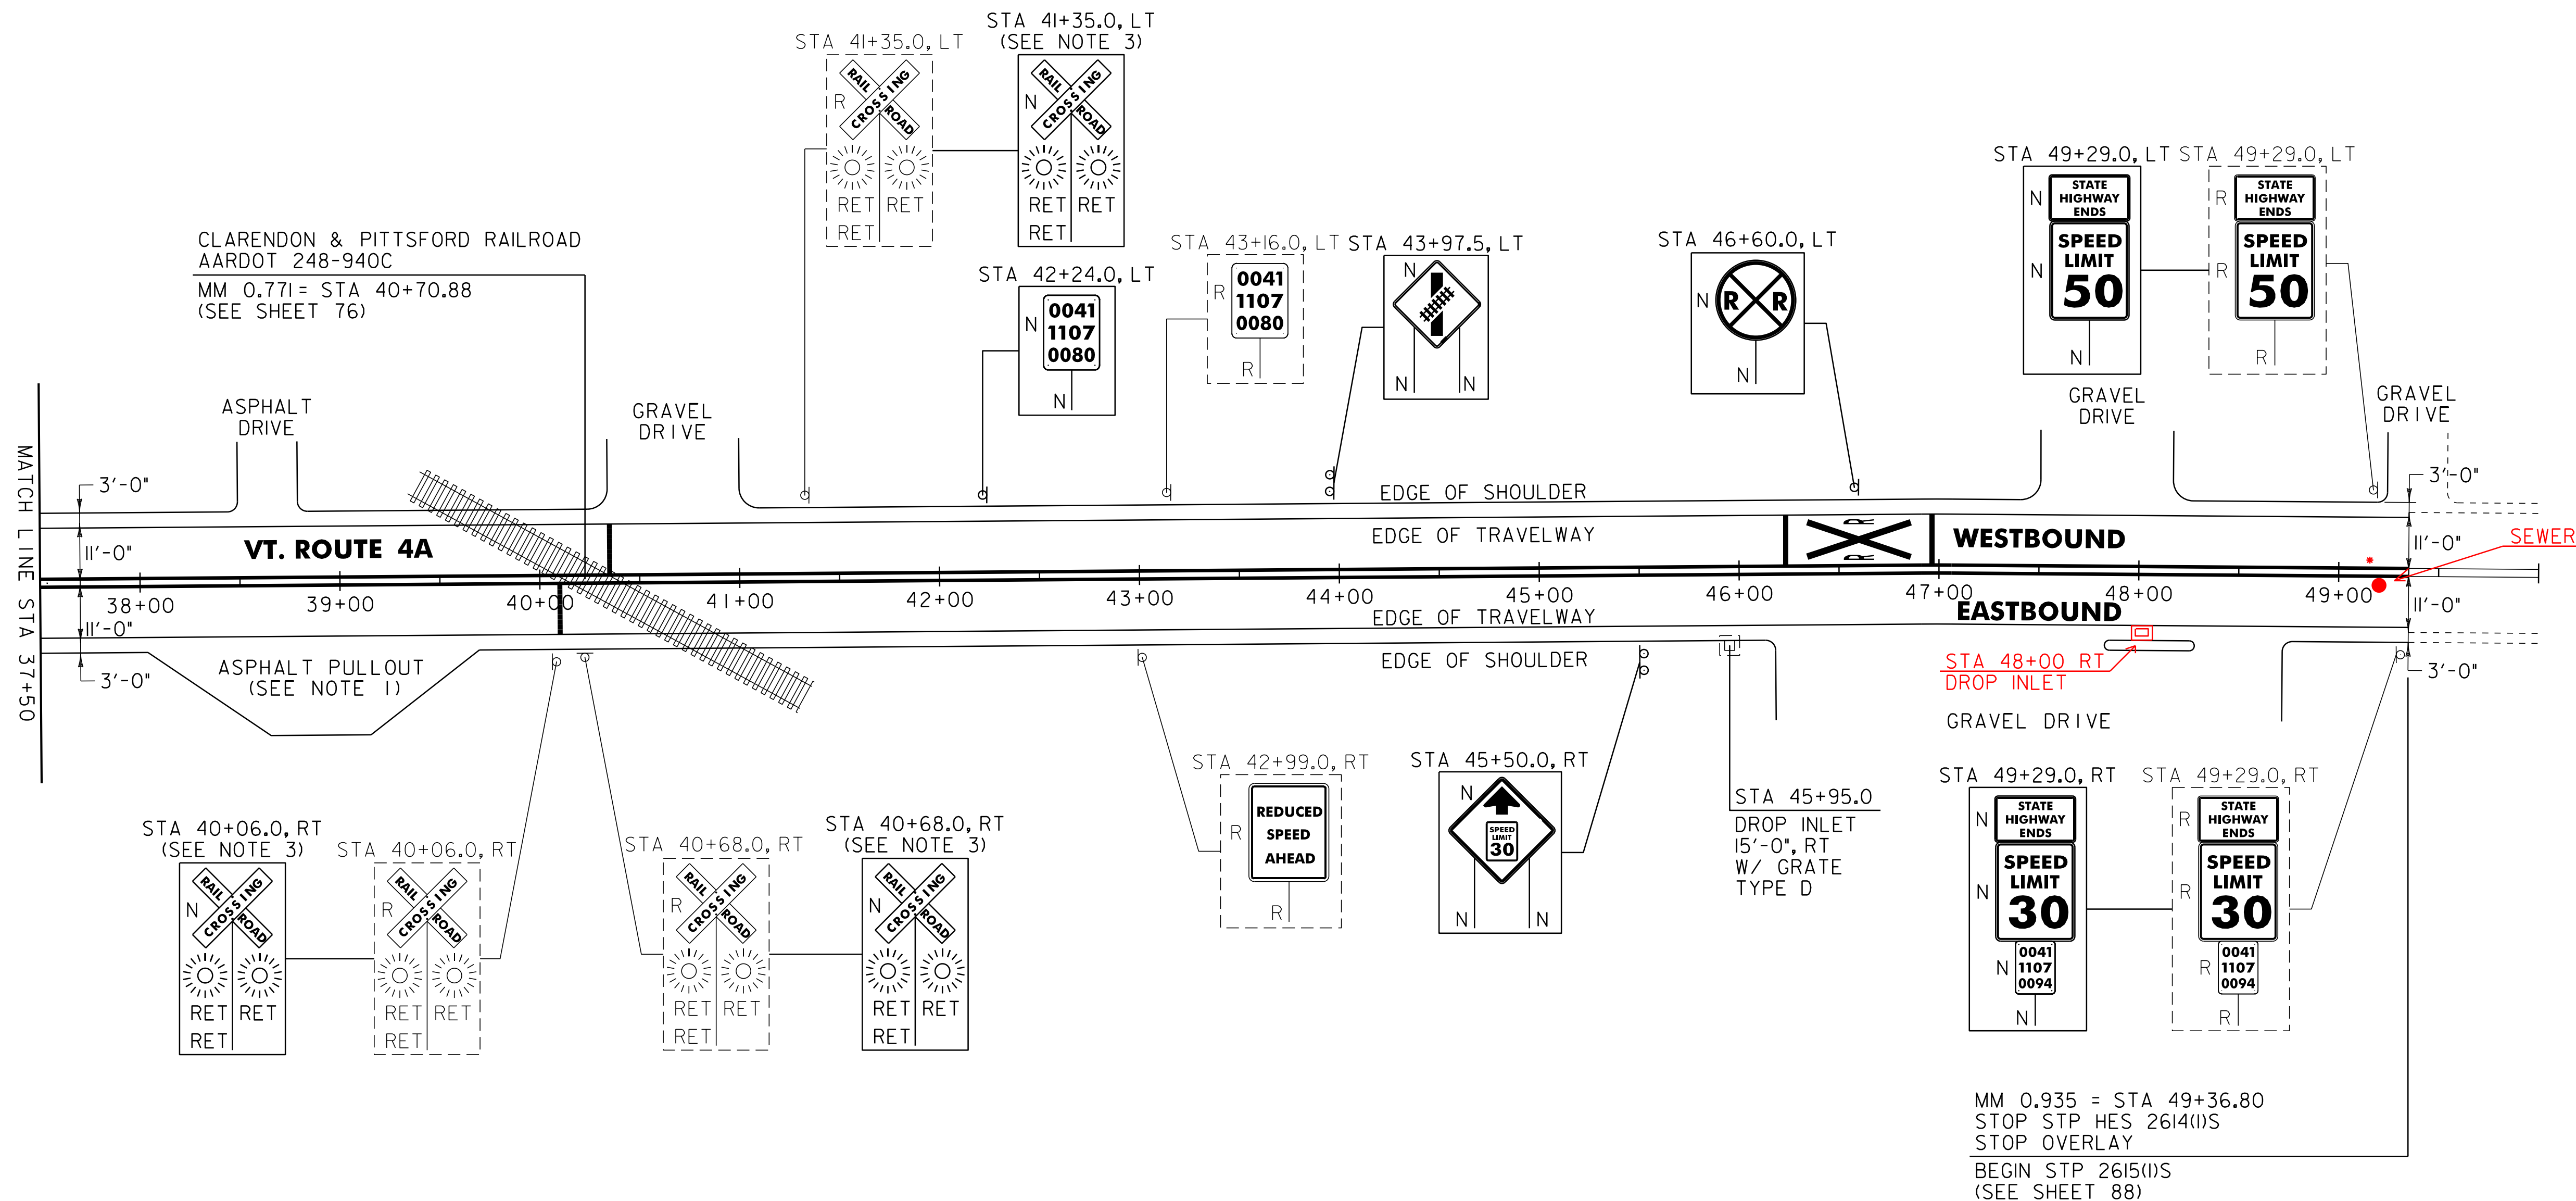

NOTES:

1. THE EXISTING ASPHALT PULLOUT SHALL BE PAVED WITH A 1 1/2" TYPE IVS WEARING COURSE. ANY REQUIRED EXCAVATION OR GRADING SHALL BE PERFORMED AS DIRECTED BY THE RESIDENT ENGINEER AND PAID FOR UNDER THE APPLICABLE RENTAL ITEM(S).
2. THE CONTRACTOR SHALL REHAB. THE EXISTING DROP INLETS, CATCH BASINS OR MANHOLES TO A DEPTH AS DIRECTED BY THE RESIDENT ENGINEER. ALL REHAB. WORK WILL BE PAID FOR UNDER THE APPLICABLE REHAB. ITEM AS DIRECTED BY THE RESIDENT ENGINEER. ALL EXISTING UTILITIES MARKED "TO REMAIN" SHALL NOT BE ALTERED OR REHABILITATED UNLESS DIRECTED OTHERWISE BY THE RESIDENT ENGINEER.
3. THE CONTRACTOR SHALL INSTALL THE NEW RAILROAD CROSSING SIGNS ON THE EXISTING RAILROAD SIGNAL POSTS.

\* 604.42 CHANGING ELEVATION OF S.M.H.  
 STA 49+28 RT

604.412, 604.415 OR 604.418  
 REHAB. DROP INLETS, CATCH BASINS, OR MANHOLES, (SEE NOTE 2)  
 FAIR HAVEN:  
 STA 45+95.0 RT

SIGN LEGEND  
 R = REMOVE  
 S = SALVAGE  
 N = NEW  
 RET = RETAIN  
 B-B = BACK TO BACK  
 EXISTING = - - - - -  
 NEW = \_\_\_\_\_

NOT TO SCALE

<b>PROJECT LAYOUT SHEET #5</b>	PROJECT NAME: FAIR HAVEN - CASTLETON
	PROJECT NUMBER: STP HES 2614(1)S
	FILE NAME: p06c058.dgn
	PLOT DATE: 22-FEB-2012 12:47
	PROJECT LEADER: D.E.G.
	DESIGNED BY: M.J.M.
	IPARM FILE: p06c058i05.i
	DRAWN BY: C.A.K.
	CHECKED BY: D.E.G.
	SHEET 26 OF 157