


646.402 DURABLE 4 INCH WHITE LINE, THERMOPLASTIC
 (ALL LINES WILL INCLUDE EDGE LINE BREAKS AND
 RADIUS FOR TOWN HIGHWAYS)
 CASTLETON:
 STA 1+00.00 - STA 15+00.00 LT & RT

646.412 DURABLE 4 INCH YELLOW LINE, THERMOPLASTIC
 (ALL LINES WILL INCLUDE C/L BREAKS FOR
 TOWN HIGHWAYS) S=SOLID, D=DASHED
 CASTLETON:
 STA 1+00.00 - STA 15+00.00 LT C RT
 S - S

675.50 REMOVING SIGNS
 AS SHOWN - 10

646.602 TEMPORARY 4 INCH WHITE LINE, PAINT
 (ALL LINES WILL INCLUDE EDGE LINE BREAKS AND
 RADIUS FOR TOWN HIGHWAYS)
 CASTLETON:
 STA 1+00.00 - STA 15+00.00 LT & RT

646.612 TEMPORARY 4 INCH YELLOW LINE, PAINT
 (ALL LINES WILL INCLUDE C/L BREAKS FOR
 TOWN HIGHWAYS) S=SOLID, D=DASHED
 CASTLETON:
 STA 1+00.00 - STA 15+00.00 LT C RT
 S - S

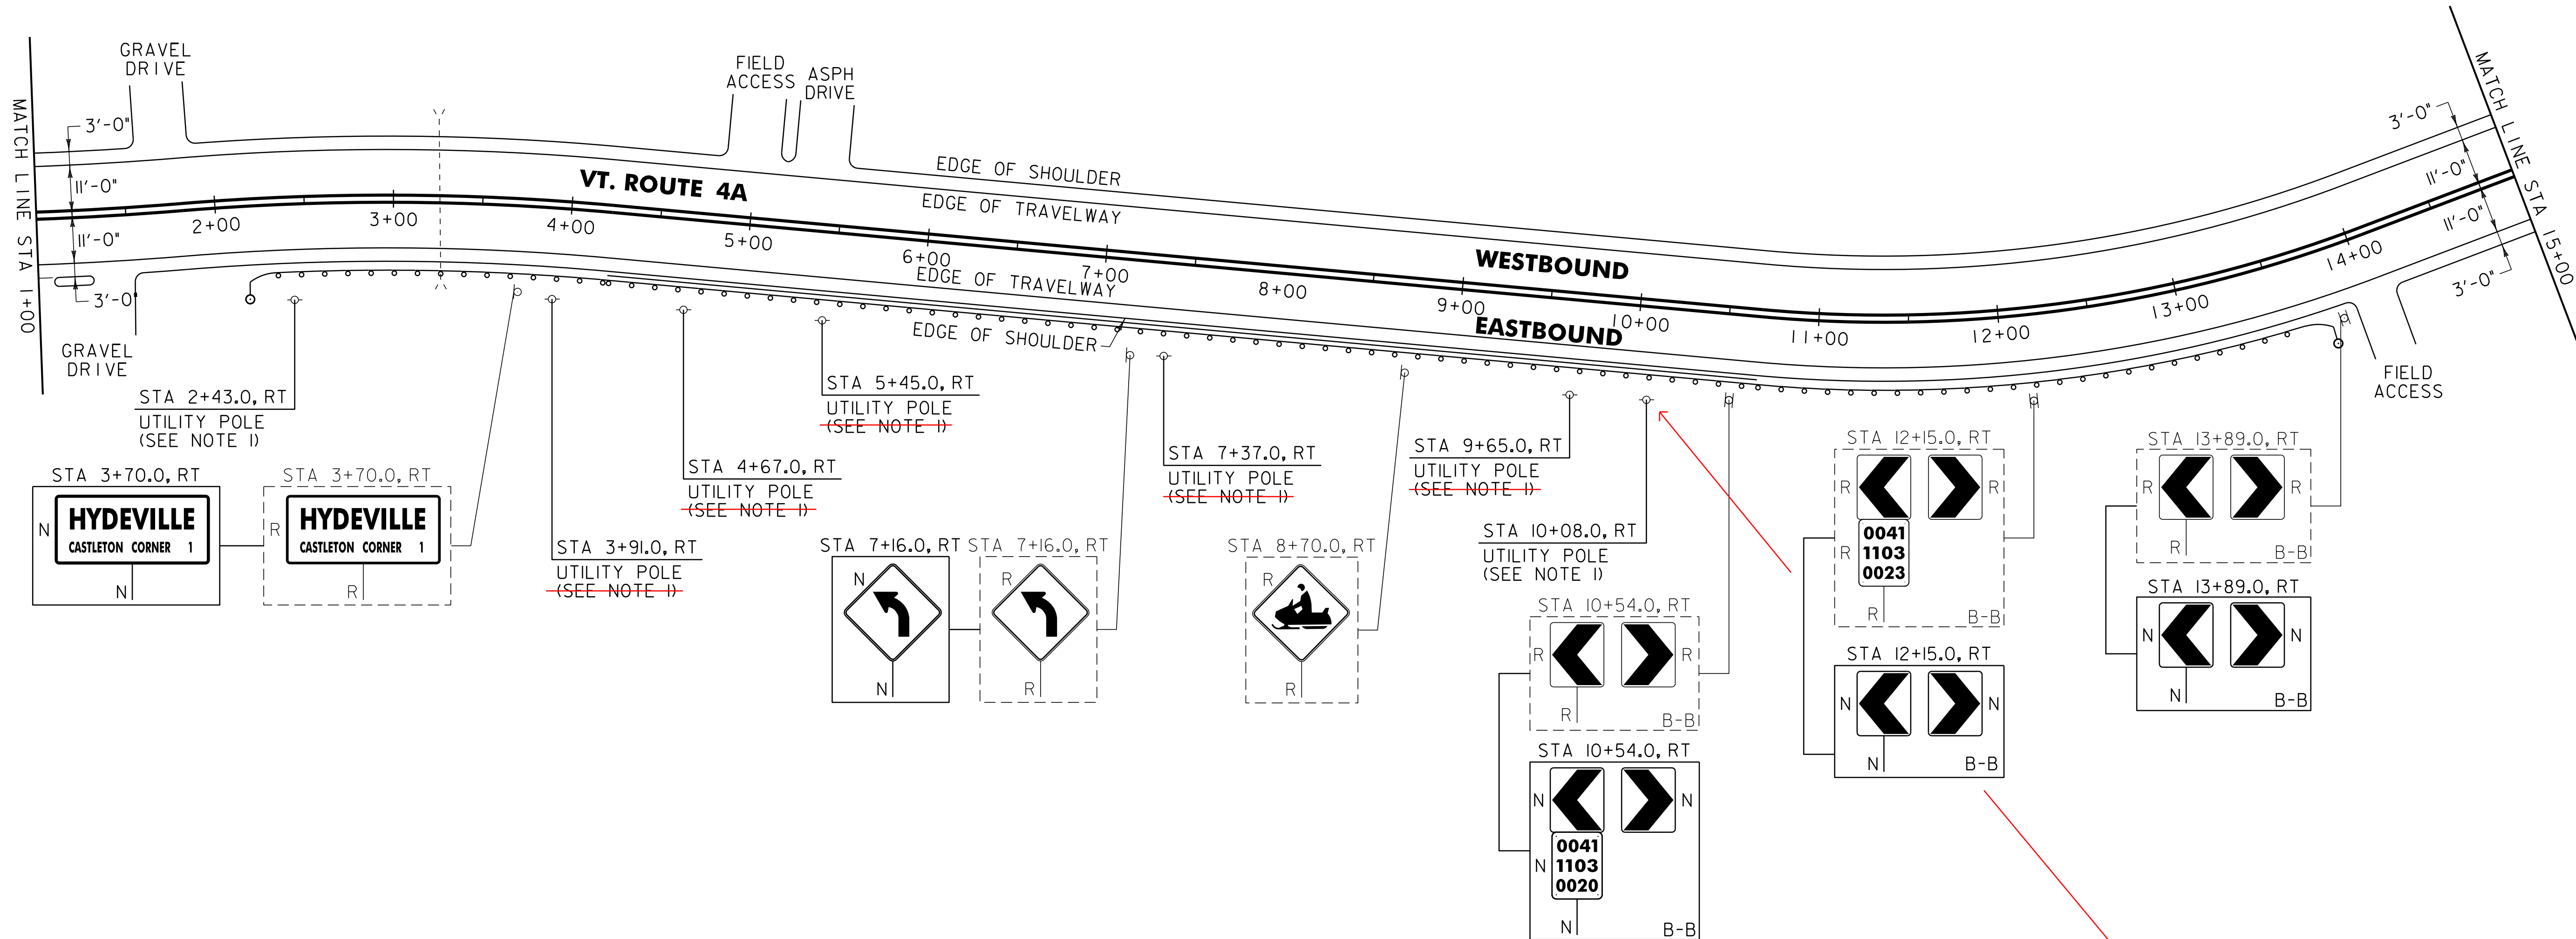

621.20 STEEL BEAM GUARDRAIL, GALVANIZED
 CASTLETON:
 STA 2+41.5 - STA 13+41.5 RT (1240.0 LF)

621.80 REMOVAL AND DISPOSAL OF GUARDRAIL
 CASTLETON:
 STA 2+16.0 - STA 13+79.0 RT (1163.0 LF)

621.50 MANUFACTURED TERMINAL SECTION, FLARED
 CASTLETON:
 STA 2+04.0 - STA 2+41.5 RT
 STA 13+41.5 - STA 13+79.0 RT

676.10 DELINEATOR WITH STEEL POST
 ♀ TYPE 1 WHITE
 CASTLETON:
 STA 2+04.0 RT
 STA 13+79.0 RT

SIGN LEGEND
 R = REMOVE
 S = SALVAGE
 N = NEW
 RET = RETAIN
 B-B = BACK TO BACK
 EXISTING = - - - - -
 NEW = _____

NOT TO SCALE

PROJECT LAYOUT SHEET #9

PROJECT NAME:	FAIR HAVEN - CASTLETON
PROJECT NUMBER:	STP HES 2614(1)S
FILE NAME:	p06c058.dgn
PLOT DATE:	22-FEB-2012 12:47
PROJECT LEADER:	D.E.G.
DRAWN BY:	C.A.K.
DESIGNED BY:	M.J.M.
CHECKED BY:	D.E.G.
IPARM FILE:	p06c058109.i
	SHEET 30 OF 157

NOTE:
 I. SEE SHEET 79 FOR REDUCED STEEL BEAM GUARDRAIL POST SPACING AT UTILITY POLE DETAIL.