

646.402 DURABLE 4 INCH WHITE LINE, THERMOPLASTIC
 (ALL LINES WILL INCLUDE EDGE LINE BREAKS AND
 RADIUS FOR TOWN HIGHWAYS)
 CASTLETON:
 STA 43+00.00 - STA 57+00.00 LT & RT

646.602 TEMPORARY 4 INCH WHITE LINE, PAINT
 (ALL LINES WILL INCLUDE EDGE LINE BREAKS AND
 RADIUS FOR TOWN HIGHWAYS)
 CASTLETON:
 STA 43+00.00 - STA 57+00.00 LT & RT

646.412 DURABLE 4 INCH YELLOW LINE, THERMOPLASTIC
 (ALL LINES WILL INCLUDE C/L BREAKS FOR
 TOWN HIGHWAYS) S=SOLID, D=DASHED
 CASTLETON:
 STA 43+00.00 - STA 57+00.00 LT ☉ RT
 S - S


646.612 TEMPORARY 4 INCH YELLOW LINE, PAINT
 (ALL LINES WILL INCLUDE C/L BREAKS FOR
 TOWN HIGHWAYS) S=SOLID, D=DASHED
 CASTLETON:
 STA 43+00.00 - STA 57+00.00 LT ☉ RT
 S - S

646.442 DURABLE 8 INCH WHITE LINE, THERMOPLASTIC

CASTLETON:
 STA 46+19.00 - STA 46+31.00 FIRE HYDRANT NO PARKING ZONE, RT
 STA 50+72.00 - STA 50+84.00 FIRE HYDRANT NO PARKING ZONE, RT
 STA 55+45.00 - STA 55+57.00 FIRE HYDRANT NO PARKING ZONE, RT

675.50 REMOVING SIGNS

AS SHOWN - 4

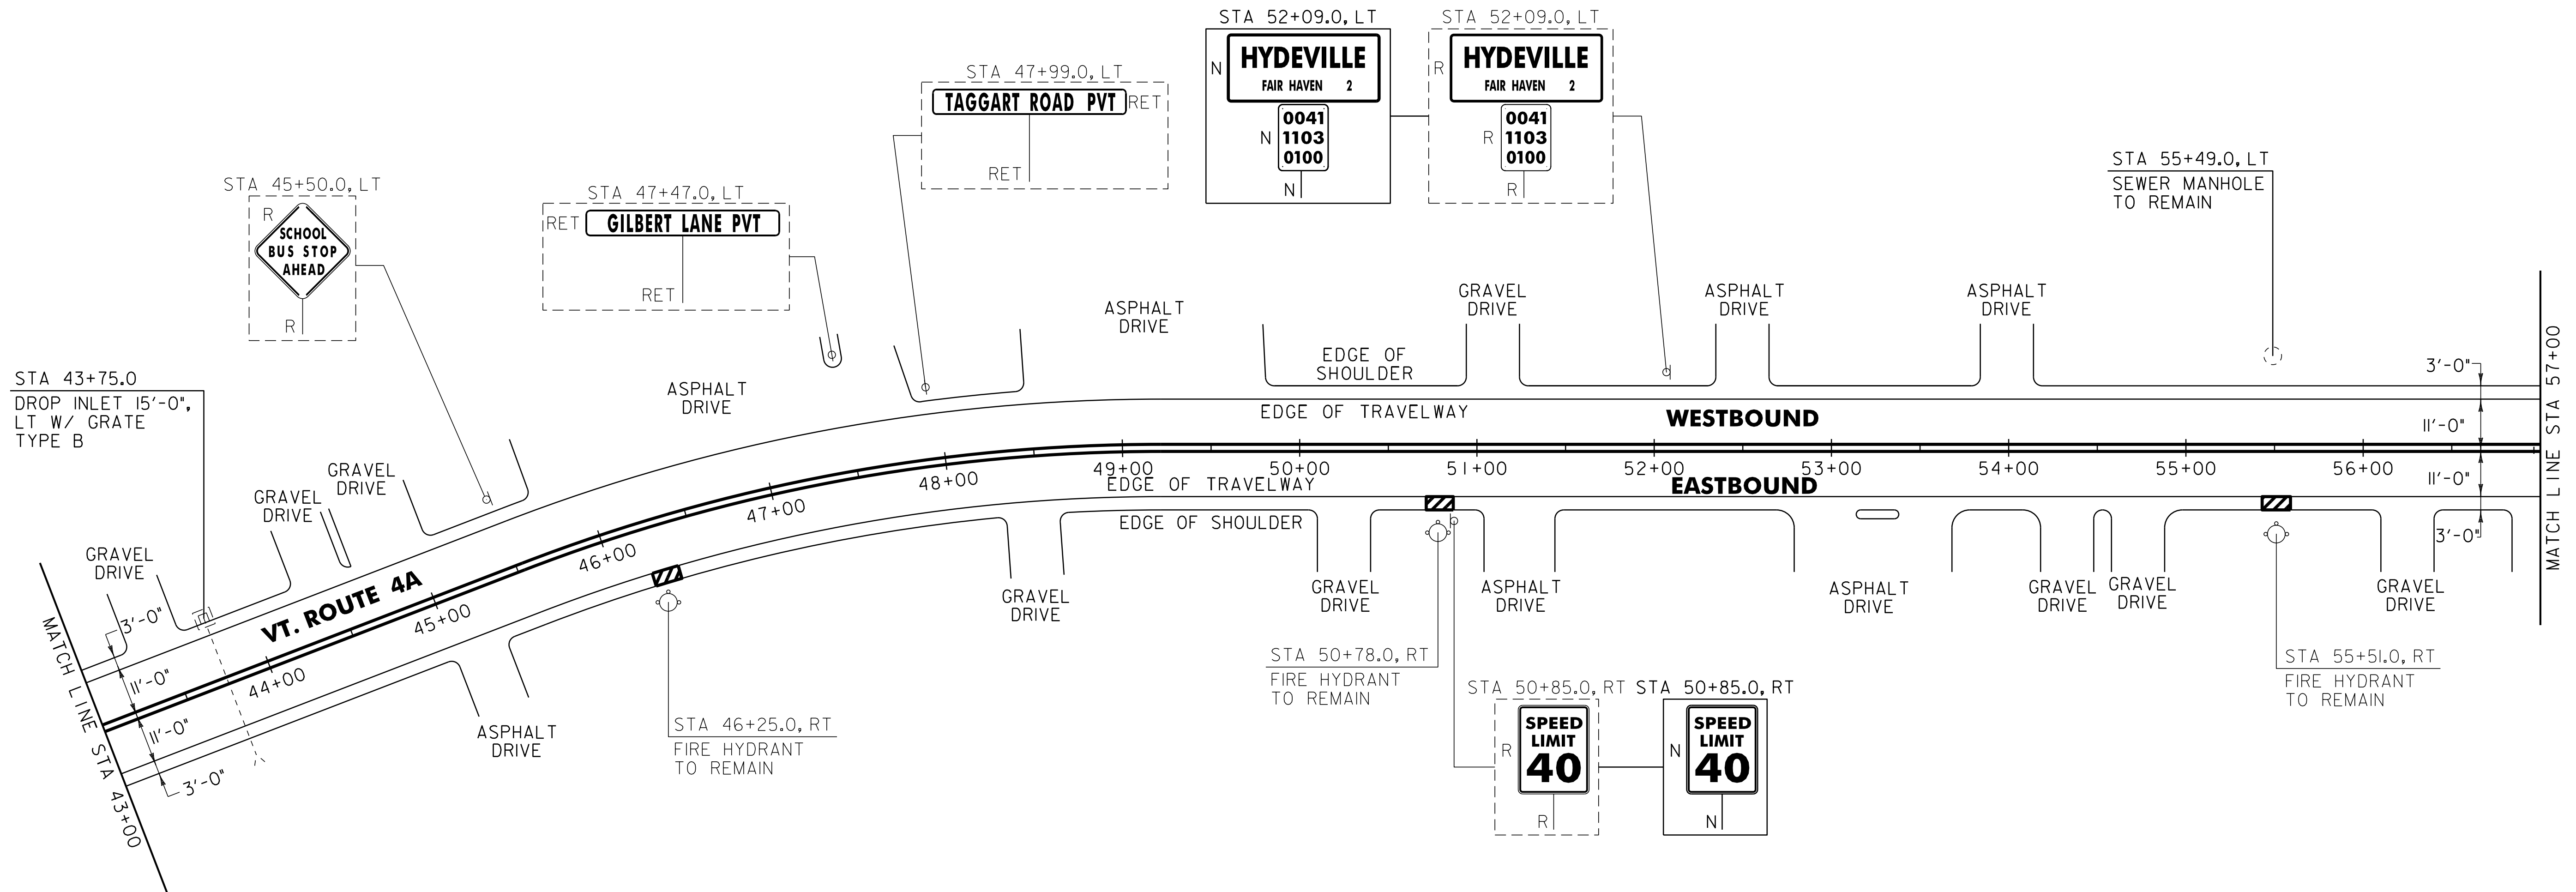

604.412, 604.415 OR 604.418
 REHAB. DROP INLETS, CATCH BASINS, OR MANHOLES, (SEE NOTE 1)

CASTLETON:
 STA 43+75.0 LT **DID NOT TOUCH**

NOTES:

- THE CONTRACTOR SHALL REHAB. THE EXISTING DROP INLETS, CATCH BASINS OR MANHOLES TO A DEPTH AS DIRECTED BY THE RESIDENT ENGINEER. ALL REHAB. WORK WILL BE PAID FOR UNDER THE APPLICABLE REHAB. ITEM AS DIRECTED BY THE RESIDENT ENGINEER. ALL EXISTING UTILITIES MARKED "TO REMAIN" SHALL NOT BE ALTERED OR REHABILITATED UNLESS DIRECTED OTHERWISE BY THE RESIDENT ENGINEER.
- SEE SHEET 10 FOR FIRE HYDRANT PAVING MARKING DETAIL.

SIGN LEGEND
 R = REMOVE
 S = SALVAGE
 N = NEW
 RET = RETAIN
 B-B = BACK TO BACK
 EXISTING = - - - - -
 NEW = _____

NOT TO SCALE

PROJECT LAYOUT SHEET #12

PROJECT NAME: FAIR HAVEN - CASTLETON

PROJECT NUMBER: STP HES 261411S

FILE NAME: p06c058.dgn
 PROJECT LEADER: D.E.G.
 DESIGNED BY: M.J.M.
 IPARM FILE: p06c058112.i

PLOT DATE: 22-FEB-2012 12:48
 DRAWN BY: C.A.K.
 CHECKED BY: D.E.G.
 SHEET 33 OF 157