

646.402 DURABLE 4 INCH WHITE LINE, THERMOPLASTIC
 (ALL LINES WILL INCLUDE EDGE LINE BREAKS AND RADIUS FOR TOWN HIGHWAYS)
 CASTLETON:
 STA 71+00.00 - STA 85+00.00 LT & RT

646.412 DURABLE 4 INCH YELLOW LINE, THERMOPLASTIC
 (ALL LINES WILL INCLUDE C/L BREAKS FOR TOWN HIGHWAYS) S=SOLID, D=DASHED
 CASTLETON:
 STA 71+00.00 - STA 85+00.00 LT C RT
 STA 84+48.00 DOUBLE SOLID LT, TH-24 S - S

646.442 DURABLE 8 INCH WHITE LINE, THERMOPLASTIC
 CASTLETON:
 STA 73+98.00 - STA 74+10.00 FIRE HYDRANT NO PARKING ZONE, LT
 STA 79+01.00 - STA 79+13.00 FIRE HYDRANT NO PARKING ZONE, LT
 STA 84+03.00 - STA 84+15.00 FIRE HYDRANT NO PARKING ZONE, LT

646.602 TEMPORARY 4 INCH WHITE LINE, PAINT
 (ALL LINES WILL INCLUDE EDGE LINE BREAKS AND RADIUS FOR TOWN HIGHWAYS)
 CASTLETON:
 STA 71+00.00 - STA 85+00.00 LT & RT

646.612 TEMPORARY 4 INCH YELLOW LINE, PAINT
 (ALL LINES WILL INCLUDE C/L BREAKS FOR TOWN HIGHWAYS) S=SOLID, D=DASHED
 CASTLETON:
 STA 71+00.00 - STA 85+00.00 LT C RT
 STA 84+48.00 DOUBLE SOLID LT, TH-24 S - S

646.482 DURABLE 24 INCH STOP BAR, THERMOPLASTIC
 CASTLETON:
 STA 84+48.00 LT, TH-24


646.682 TEMPORARY 24 INCH STOP BAR, PAINT

646.492 DURABLE LETTER OR SYMBOL, THERMOPLASTIC
 CASTLETON:
 STA 84+48.00 LT, TH-24 "S,T,O,P" (4 EA)

646.692 TEMPORARY LETTER OR SYMBOL, PAINT
 CASTLETON:
 STA 84+48.00 LT, TH-24 "S,T,O,P" (8 EA)

675.50 REMOVING SIGNS
 AS SHOWN - 9

675.60 ERECTING SALVAGED SIGNS
 AS SHOWN - 1

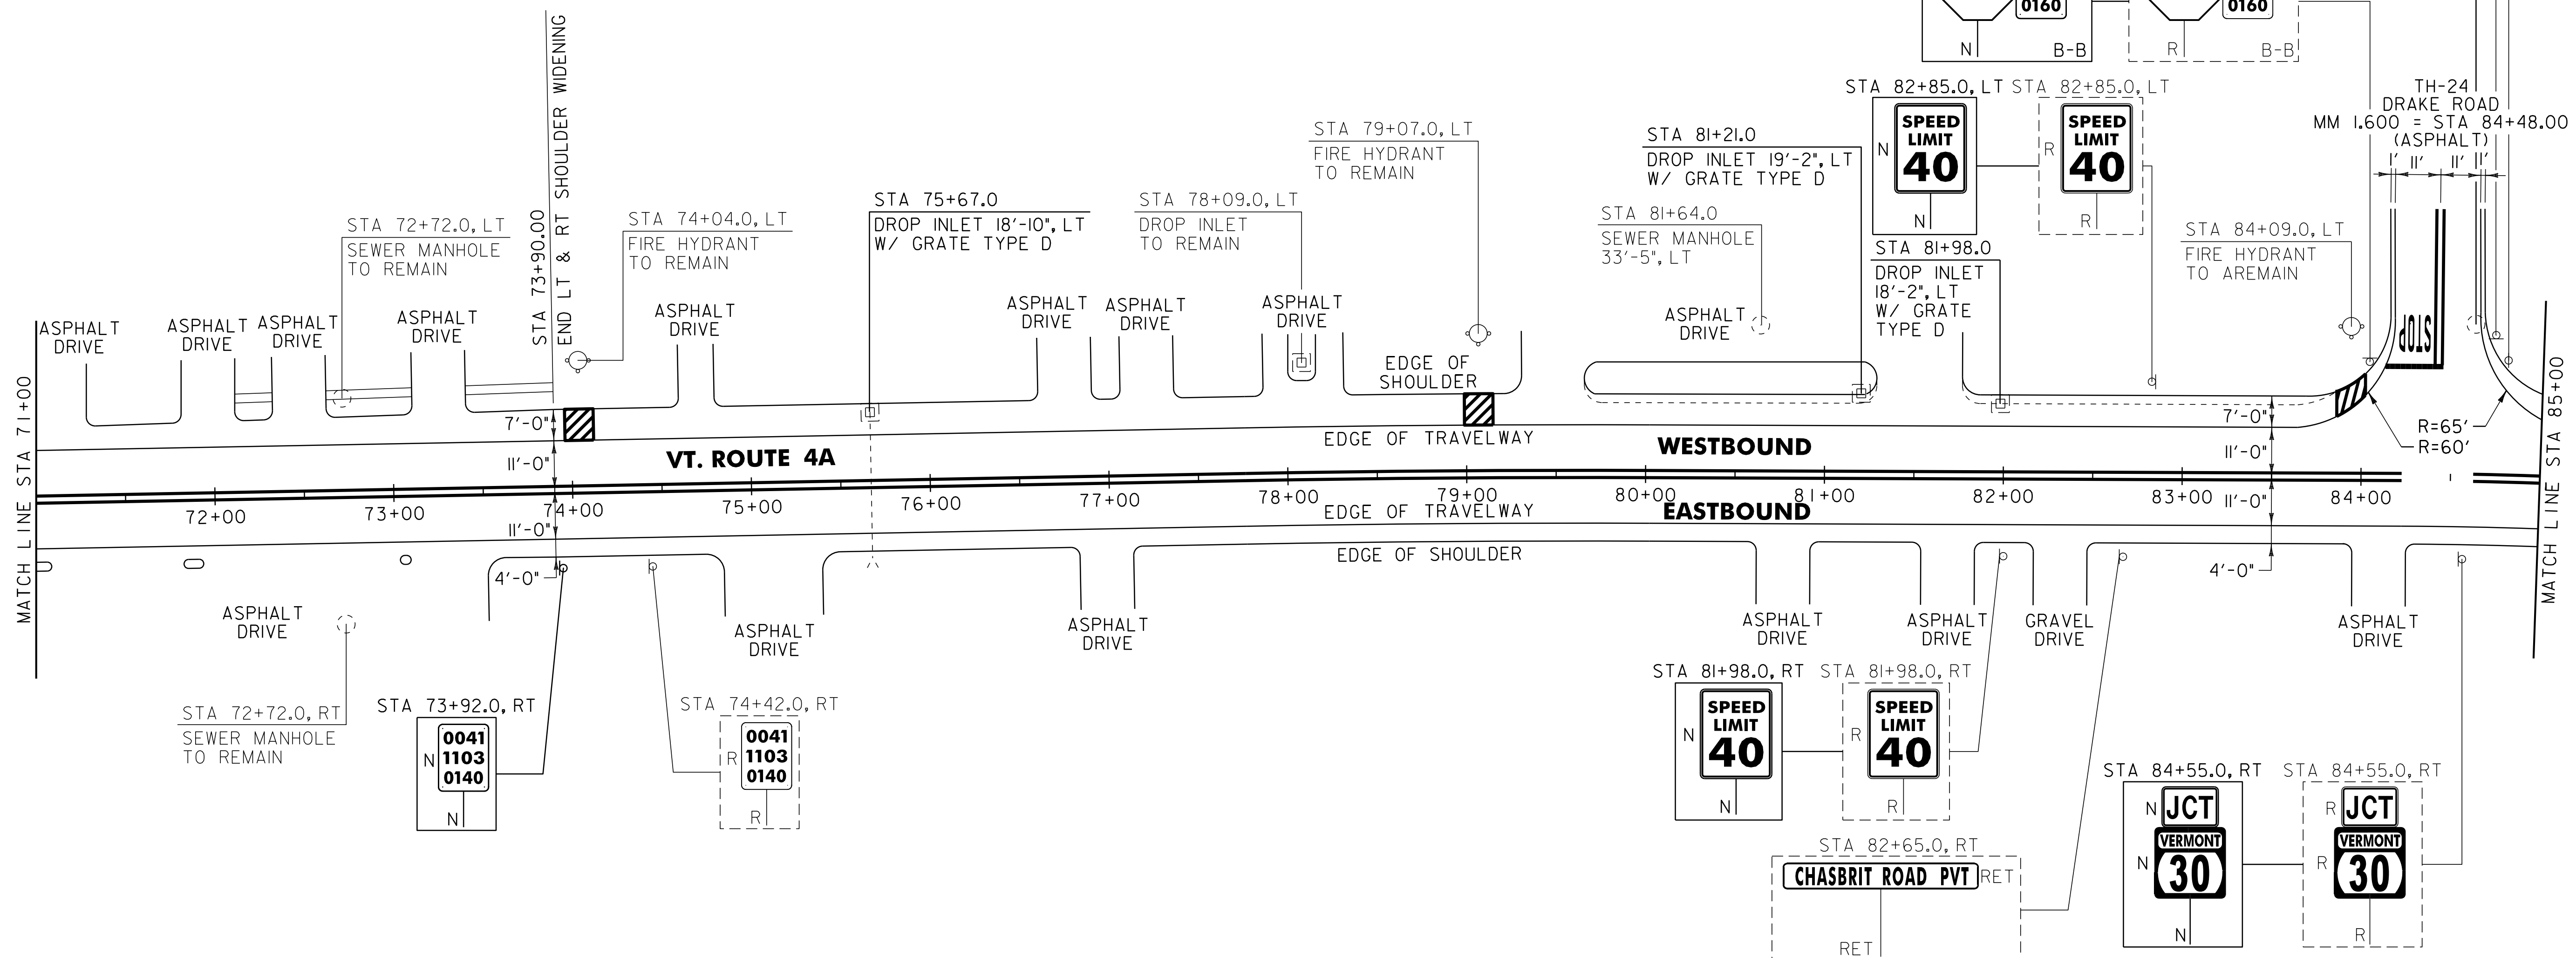

- NOTES:
- PAVING LIMIT ON ALL TOWN HIGHWAYS SHALL BE MEASURED 25 FT BACK FROM VT. ROUTE 4A EDGE OF SHOULDER UNLESS DENOTED OTHERWISE ON THE PLANS OR AS DIRECTED BY THE RESIDENT ENGINEER.
 - SEE SHEET 10 FOR FIRE HYDRANT PAVEMENT MARKING DETAIL.
 - THE CONTRACTOR SHALL REHAB. THE EXISTING DROP INLETS, CATCH BASINS OR MANHOLES TO A DEPTH AS DIRECTED BY THE RESIDENT ENGINEER. ALL REHAB. WORK WILL BE PAID FOR UNDER THE APPLICABLE REHAB. ITEM AS DIRECTED BY THE RESIDENT ENGINEER. ALL EXISTING UTILITIES MARKED "TO REMAIN" SHALL NOT BE ALTERED OR REHABILITATED UNLESS DIRECTED OTHERWISE BY THE RESIDENT ENGINEER.

~~604.412, 604.415 OR 604.418~~
 REHAB. DROP INLETS, CATCH BASINS, OR MANHOLES, (SEE NOTE 3)

CASTLETON:
 STA 75+67.0 LT
 STA 81+21.0 LT
 STA 81+98.0 LT

604.42 CHANGING ELEVATION OF SEWER MANHOLES

CASTLETON:
 STA 84+64.0 LT

SIGN LEGEND
 R = REMOVE
 S = SALVAGE
 N = NEW
 RET = RETAIN
 B-B = BACK TO BACK
 EXISTING = _____
 NEW = _____

NOT TO SCALE

PROJECT LAYOUT SHEET #14	PROJECT NAME: FAIR HAVEN - CASTLETON	PLOT DATE: 22-FEB-2012 12:48
	PROJECT NUMBER: STP HES 2614(1)S	DRAWN BY: C.A.K.
	FILE NAME: p06c058.dgn	CHECKED BY: D.E.G.
	PROJECT LEADER: D.E.G. DESIGNED BY: M.J.M. IPARM FILE: p06c058(1).i	SHEET 35 OF 157