

646.402 DURABLE 4 INCH WHITE LINE, THERMOPLASTIC
(ALL LINES WILL INCLUDE EDGE LINE BREAKS AND RADIUS FOR TOWN HIGHWAYS)

CASTLETON:
STA 99+00.00 - STA 113+00.00 LT & RT

646.602 TEMPORARY 4 INCH WHITE LINE, PAINT
(ALL LINES WILL INCLUDE EDGE LINE BREAKS AND RADIUS FOR TOWN HIGHWAYS)

CASTLETON:
STA 99+00.00 - STA 113+00.00 LT & RT

646.412 DURABLE 4 INCH YELLOW LINE, THERMOPLASTIC
(ALL LINES WILL INCLUDE C/L BREAKS FOR TOWN HIGHWAYS) S=SOLID, D=DASHED

CASTLETON:
STA 99+20.00 - STA 113+00.00 LT & RT
STA 99+00.00 - STA 99+20.00 DOUBLE SOLID MEDIAN LT & RT
STA 105+70.56 DOUBLE SOLID LT, TH-72

646.612 TEMPORARY 4 INCH YELLOW LINE, PAINT
(ALL LINES WILL INCLUDE C/L BREAKS FOR TOWN HIGHWAYS) S=SOLID, D=DASHED

CASTLETON:
STA 99+20.00 - STA 113+00.00 LT & RT
STA 99+00.00 - STA 99+20.00 DOUBLE SOLID MEDIAN LT & RT
STA 105+70.56 DOUBLE SOLID LT, TH-72

646.442 DURABLE 8 INCH WHITE, THERMOPLASTIC

CASTLETON:
STA 101+27.00 - STA 101+39.00 FIRE HYDRANT NO PARKING ZONE, LT
STA 107+82.00 - STA 107+94.00 FIRE HYDRANT NO PARKING ZONE, RT

646.452 DURABLE 8 INCH YELLOW, THERMOPLASTIC

CASTLETON:
STA 99+00.00 - STA 99+20.00 HATCHED MEDIAN LT & RT

646.482 DURABLE 24 INCH STOP BAR, THERMOPLASTIC

CASTLETON:
STA 105+70.56 LT, TH-72

646.682 TEMPORARY 24 INCH STOP BAR, PAINT

CASTLETON:
STA 105+70.56 LT, TH-72

646.492 DURABLE LETTER OR SYMBOL, THERMOPLASTIC

CASTLETON:
STA 105+70.56 LT, TH-72 "S,T,O,P" (4 EA)

646.692 TEMPORARY LETTER OR SYMBOL, PAINT


CASTLETON:
STA 105+70.56 LT, TH-72 "S,T,O,P" (8 EA)

675.50 REMOVING SIGNS

AS SHOWN - 25

675.60 ERECTING SALVAGED SIGNS

AS SHOWN - 1

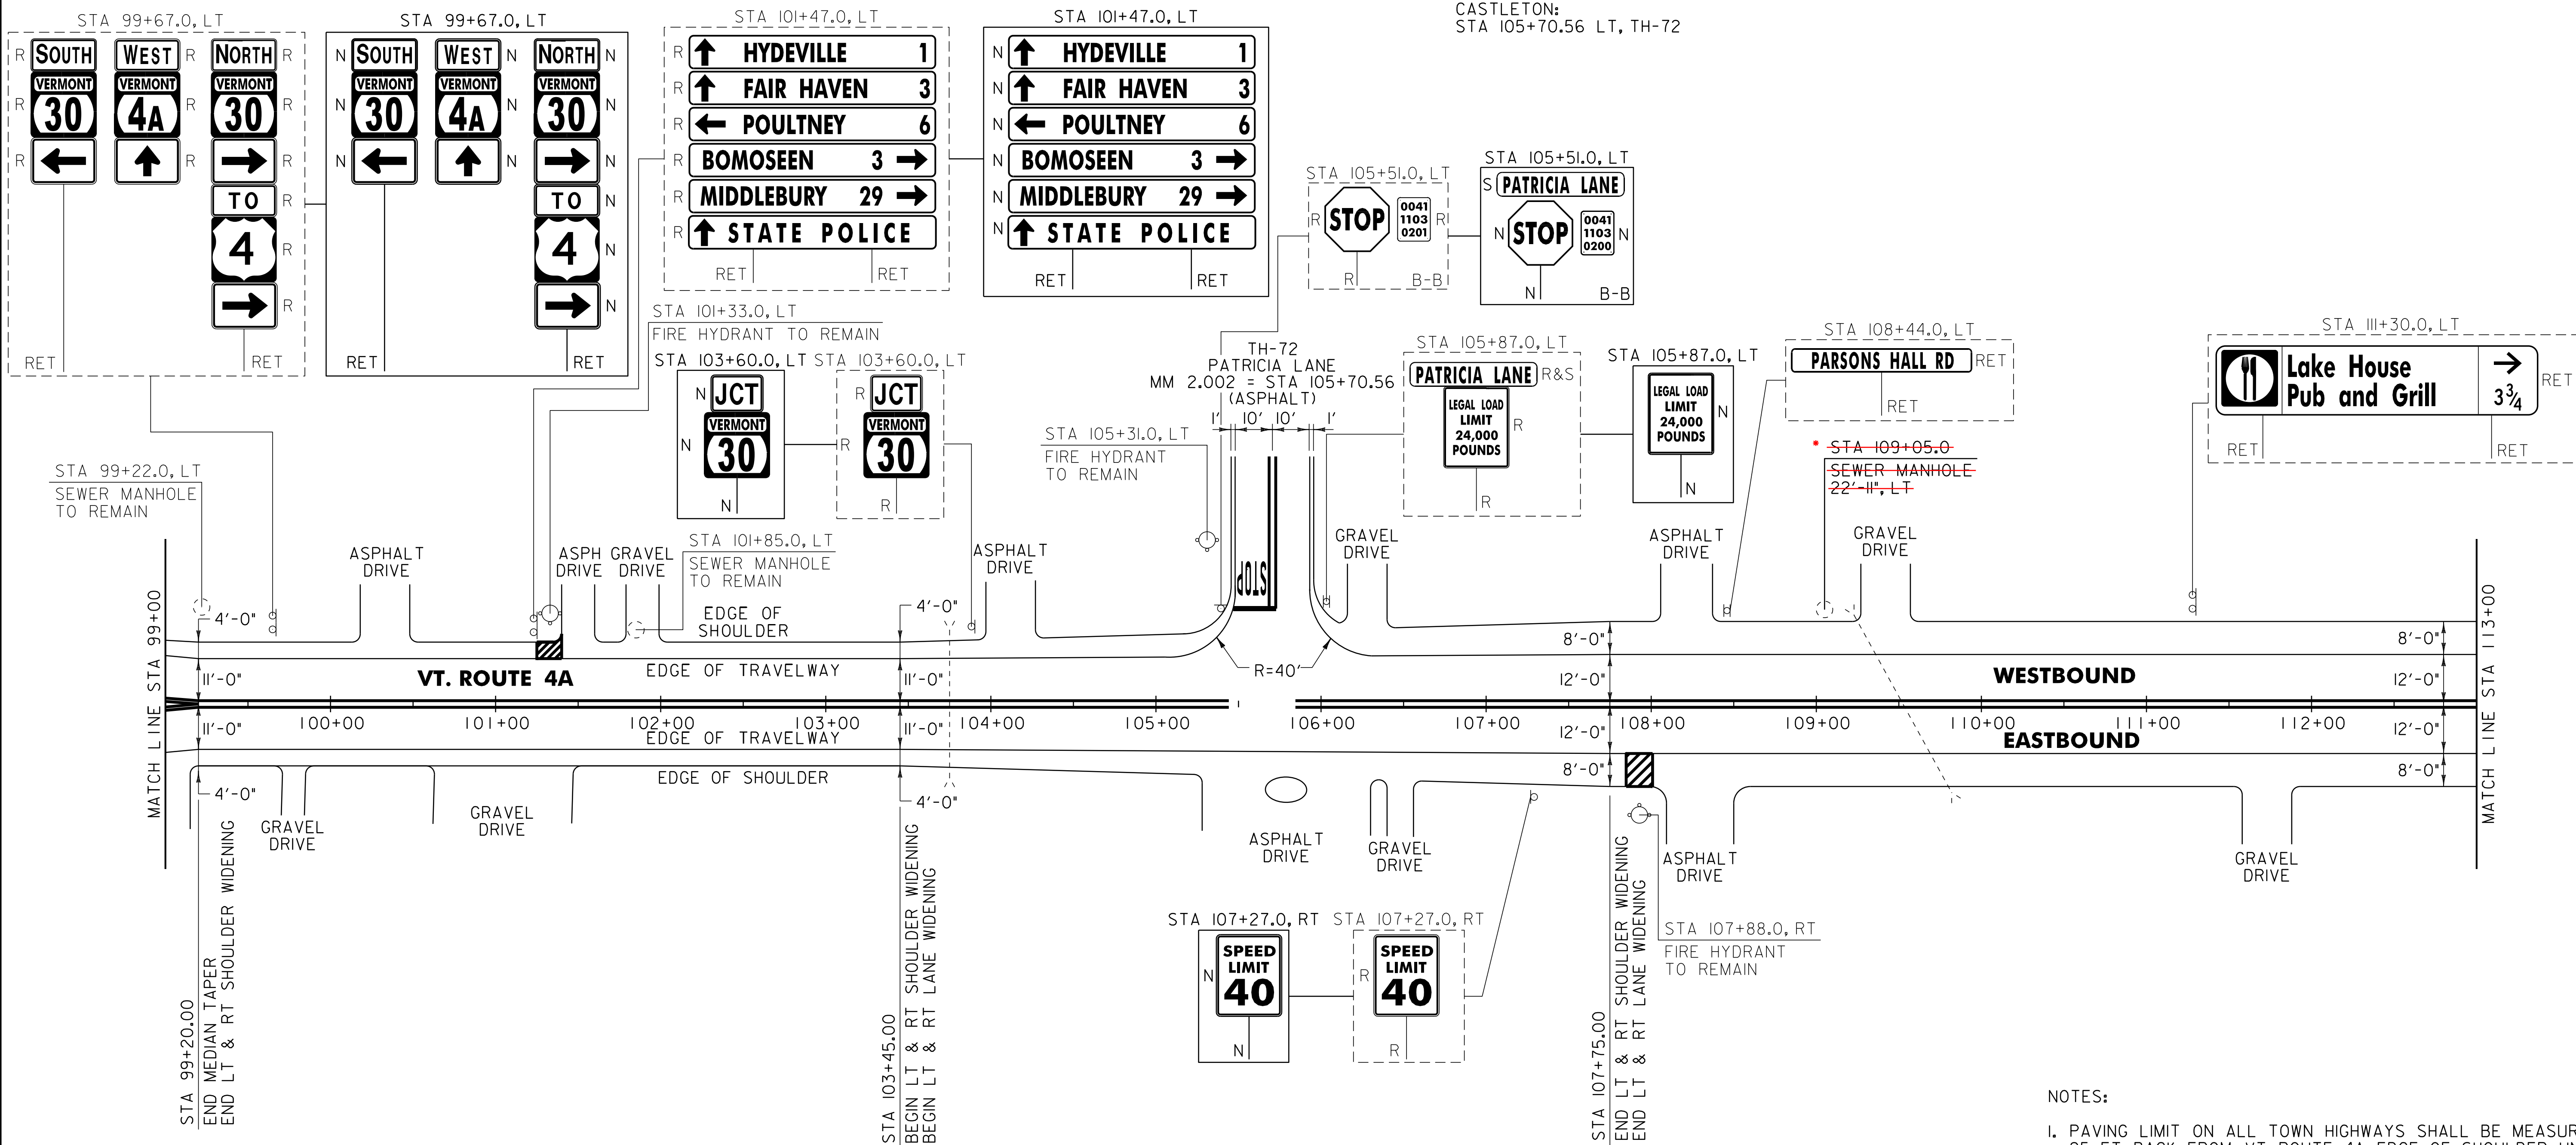

- NOTES:
- PAVING LIMIT ON ALL TOWN HIGHWAYS SHALL BE MEASURED 25 FT BACK FROM VT. ROUTE 4A EDGE OF SHOULDER UNLESS DENOTED OTHERWISE ON THE PLANS OR AS DIRECTED BY THE RESIDENT ENGINEER.
 - SEE SHEET 10 FOR FIRE HYDRANT PAVEMENT MARKING DETAIL.

NOT TO SCALE

PROJECT LAYOUT SHEET #17	PROJECT NAME: FAIR HAVEN - CASTLETON
	PROJECT NUMBER: STP HES 2614(1)S
	FILE NAME: p06c058.dgn
	PLOT DATE: 22-FEB-2012 12:48
	PROJECT LEADER: D.E.G.
	DESIGNED BY: M.J.M.
	IPARM FILE: p06c058(1)7.i
	DRAWN BY: C.A.K.
	CHECKED BY: D.E.G.
	SHEET 38 OF 157

SIGN LEGEND
R = REMOVE
S = SALVAGE
N = NEW
RET = RETAIN
B-B = BACK TO BACK
EXISTING = - - - - -
NEW = _____

* EXISTING STRUCTURE IN CONCRETE PAD - NO ELEVATION CHANGE REQUIRED

~~604.42 CHANGING ELEVATION OF SEWER MANHOLES~~

~~CASTLETON:~~

~~STA 109+05.0 LT~~