


646.402 DURABLE 4 INCH WHITE LINE, THERMOPLASTIC
 (ALL LINES WILL INCLUDE EDGE LINE BREAKS AND RADIUS FOR TOWN HIGHWAYS)
 FAIR HAVEN:
 STA 11+50.00 - STA 23+00.00 LT & RT

646.602 TEMPORARY 4 INCH WHITE LINE, PAINT
 (ALL LINES WILL INCLUDE EDGE LINE BREAKS AND RADIUS FOR TOWN HIGHWAYS)
 FAIR HAVEN:
 STA 11+50.00 - STA 23+00.00 LT & RT

646.412 DURABLE 4 INCH YELLOW LINE, THERMOPLASTIC
 (ALL LINES WILL INCLUDE C/L BREAKS FOR TOWN HIGHWAYS) S=SOLID, D=DASHED
 FAIR HAVEN: LT C RT
 STA 11+50.00 - STA 23+00.00 S - S

646.612 TEMPORARY 4 INCH YELLOW LINE, PAINT
 (ALL LINES WILL INCLUDE C/L BREAKS FOR TOWN HIGHWAYS) S=SOLID, D=DASHED
 FAIR HAVEN: LT C RT
 STA 11+50.00 - STA 23+00.00 S - S

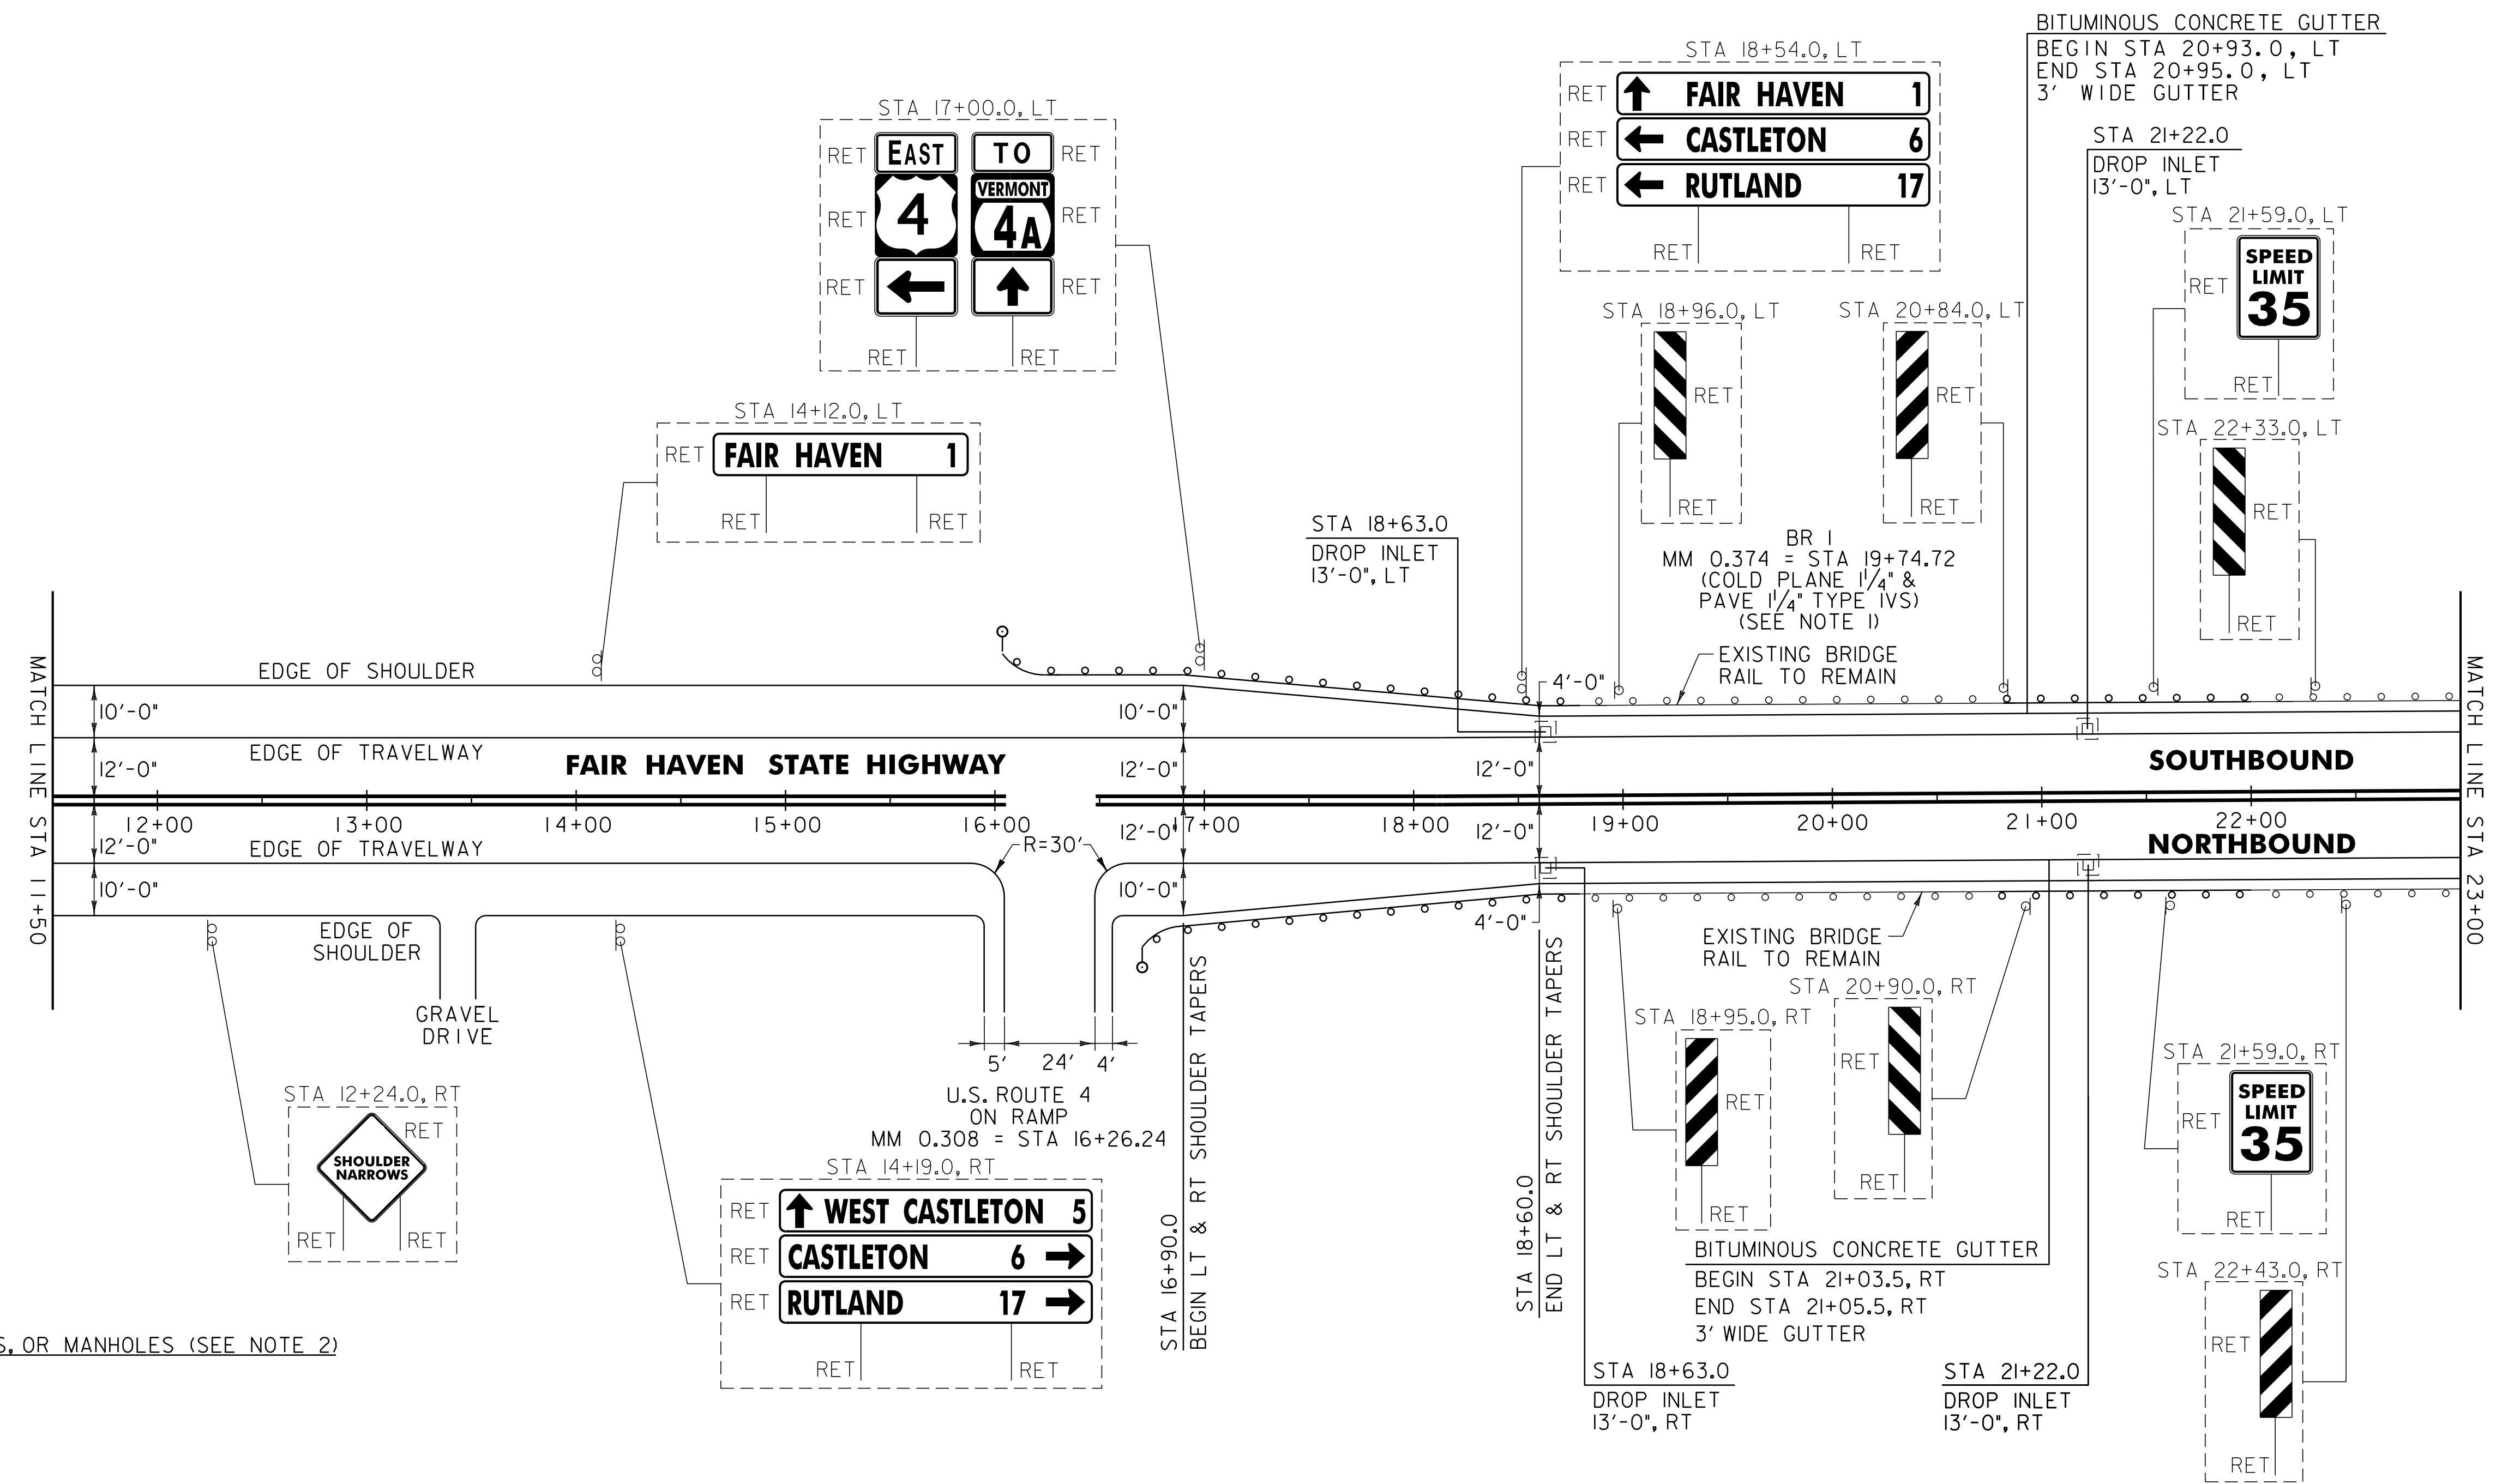

604.412, 604.415 OR 604.418
 REHAB. DROP INLETS, CATCH BASINS, OR MANHOLES (SEE NOTE 2)

FAIR HAVEN:
 STA 18+63.0 LT
 STA 18+63.0 RT
 STA 21+22.0 LT
 STA 21+22.0 RT

616.35 TREATED TIMBER CURB

FAIR HAVEN:
~~STA 18+61.0 - STA 18+86.0 LT (25.0 LF) 18+59 - 18+93.75 LT (34.75)~~
~~STA 18+70.0 - STA 18+95.0 RT (25.0 LF) 18+68 - 18+93.75 RT (25.75)~~
~~STA 20+95.5 - STA 22+33.0 LT (37.5 LF) 20+85.5 - 22+35.5 LT (45.0)~~
~~STA 21+05.5 - STA 22+43.0 RT (37.5 LF) 20+92.0 - 22+45.0 RT (45.3)~~

616.47 BITUMINOUS CONCRETE GUTTERS AND TRAFFIC ISLANDS

FAIR HAVEN:
 STA 20+93.0 - STA 20+95.0 LT (0.4 TON)
 STA 21+03.5 - STA 21+05.5 RT (0.4 TON)

621.20 STEEL BEAM GUARDRAIL, GALVANIZED

FAIR HAVEN:
 STA 16+41.0 - STA 18+91.0 LT (250.0 LF)
 STA 17+33.5 - STA 18+71.0 RT (137.5 LF)
 STA 20+82.0 - STA 22+07.0 LT (125.0 LF)
 STA 21+15.0 - STA 22+18.0 RT (103.0 LF)

621.50 MANUFACTURED TERMINAL SECTION, FLARED

FAIR HAVEN:
 STA 16+03.5 - STA 16+41.0 LT
 STA 16+96.0 - STA 17+33.5 RT

621.80 REMOVAL AND DISPOSAL OF GUARDRAIL

FAIR HAVEN:
 STA 16+14.0 - STA 18+91.0 LT (277.0 LF)
 STA 16+93.0 - STA 18+71.0 RT (178.0 LF)
 STA 20+82.0 - STA 22+07.0 LT (125.0 LF)
 STA 21+15.0 - STA 22+18.0 RT (103.0 LF)

676.10 DELINEATOR WITH STEEL POST

FAIR HAVEN:
 STA 16+03.5 LT
 STA 16+96.0 RT

NOTES:

- SEE SHEET 75 FOR BR 1 DETAIL.
- THE CONTRACTOR SHALL REHAB. THE EXISTING DROP INLETS, CATCH BASINS OR MANHOLES TO A DEPTH AS DIRECTED BY THE RESIDENT ENGINEER. ALL REHAB. WORK WILL BE PAID FOR UNDER THE APPLICABLE REHAB. ITEM AS DIRECTED BY THE RESIDENT ENGINEER. ALL EXISTING UTILITIES MARKED "TO REMAIN" SHALL NOT BE ALTERED OR REHABILITATED UNLESS DIRECTED OTHERWISE BY THE RESIDENT ENGINEER.
- PAVING LIMIT ON ALL TOWN HIGHWAYS SHALL BE MEASURED 25 FT BACK FROM FAIR HAVEN STATE HIGHWAY EDGE OF SHOULDER UNLESS DENOTED OTHERWISE ON THE PLANS OR AS DIRECTED BY THE RESIDENT ENGINEER.

SIGN LEGEND
 R = REMOVE
 S = SALVAGE
 N = NEW
 RET = RETAIN
 B-B = BACK TO BACK
 EXISTING = - - - - -
 NEW = _____

NOT TO SCALE

PROJECT LAYOUT SHEET #22	PROJECT NAME: FAIR HAVEN - CASTLETON	PLOT DATE: 22-FEB-2012 12:49
	PROJECT NUMBER: STP HES 2614(1)S	DRAWN BY: C.A.K.
	FILE NAME: p06c058.dgn	CHECKED BY: D.E.G.
	DESIGNED BY: M.J.M.	SHEET 43 OF 157