


BRIDGE TRANSITION AREA DETAIL

BR 1VT. ROUTE 4A FAIR HAVEN STA 79+76.00 TO FAIR HAVEN STA 80+30.00

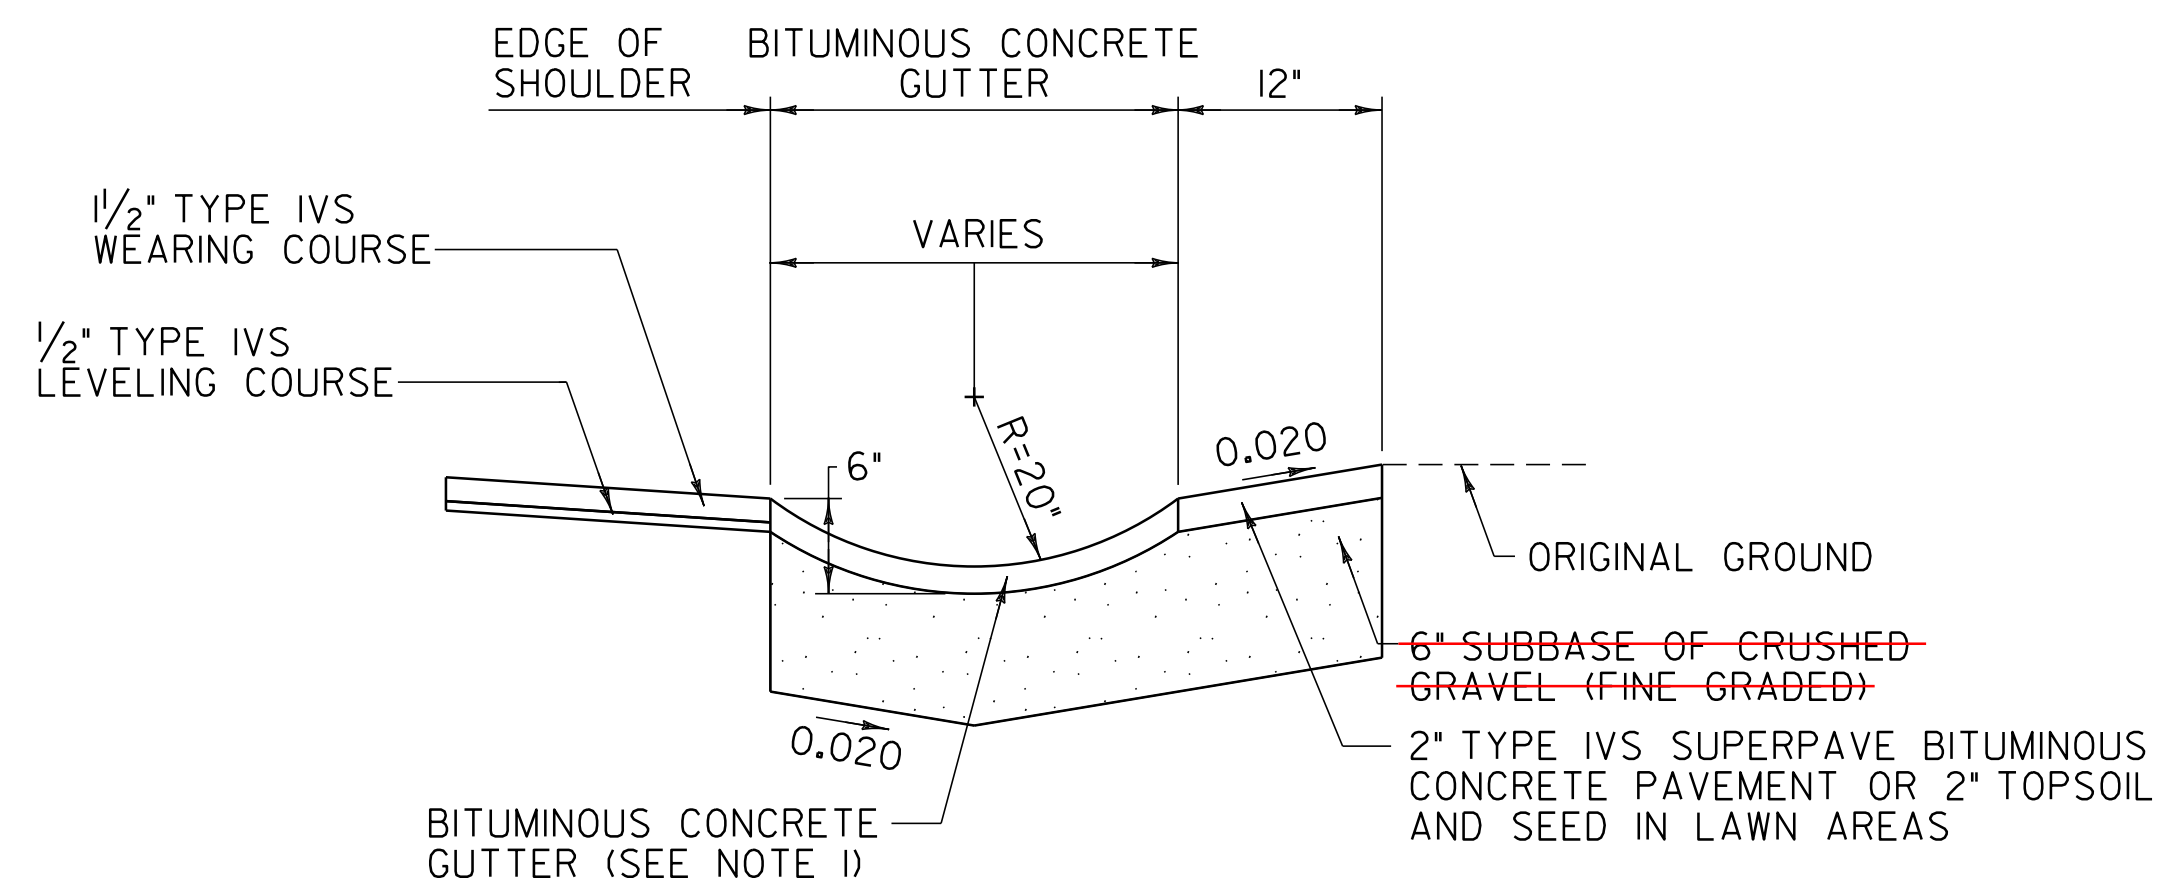


BITUMINOUS CONCRETE GUTTER DETAIL

FAIR HAVEN HIGHWAY

- STA 54+35.0 - STA 54+68.0 RT (4.9 TON)
- STA 65+00.0 - STA 78+80.0 RT (85.4 TON)
- STA 81+00.0 - STA 83+44.0 RT (12.7 TON)
- STA 83+34.0 - STA 84+55.0 LT (6.0 TON)
- STA 84+74.0 - STA 87+10.0 LT (20.4 TON)
- STA 85+26.0 - STA 87+42.0 RT (18.7 TON)

NOTE:

I. BITUMINOUS CONCRETE GUTTER TO BE CONSTRUCTED BY PLACING 1-2" TYPE IVS SUPERPAVE BITUMINOUS CONCRETE PAVEMENT LIFT AS DIRECTED BY THE RESIDENT ENGINEER. PAYMENT UNDER ITEM 616.47 BITUMINOUS CONCRETE GUTTERS AND TRAFFIC ISLANDS.

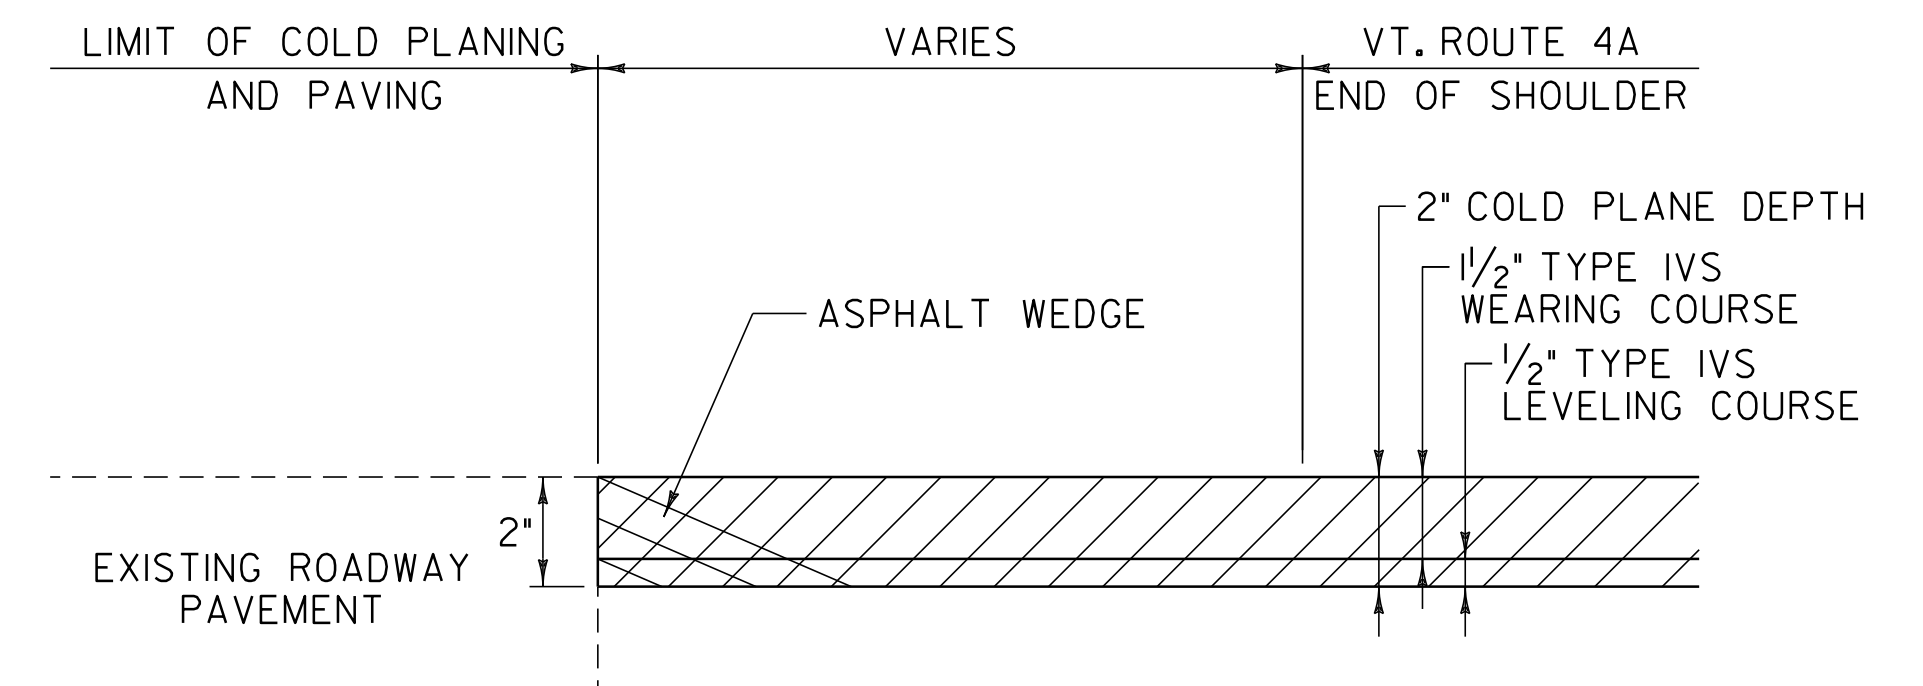

SIDE ROAD APPROACH AREA DETAIL

- TH-55
- TH-64
- TH-57
- TH-50
- VT. ROUTE 22A
- TH-54
- TH-8
- TH-44
- TH-53
- TH-43
- TH-3 (FORK)
- TH-3
- TH-41

NOT TO SCALE

PAVING DETAILS SHEET	PROJECT NAME: FAIR HAVEN	
	PROJECT NUMBER: STP 2615(1)S	
	FILE NAME: p06c058.dgn	PLOT DATE: 22-FEB-2012 12:53
	PROJECT LEADER: D.E.G.	DRAWN BY: C.A.K.
DESIGNED BY: M.J.M.	CHECKED BY: D.E.G.	
IPARM FILE: p06c060pds2.i	SHEET 83 OF 157	