


646.402 DURABLE 4 INCH WHITE LINE, THERMOPLASTIC  
 (ALL LINES WILL INCLUDE EDGE LINE BREAKS AND  
 RADIUS FOR TOWN HIGHWAYS)  
 FAIR HAVEN:  
 STA 49+36.80 - STA 53+00.00 LT & RT

646.602 TEMPORARY 4 INCH WHITE LINE, PAINT  
 (ALL LINES WILL INCLUDE EDGE LINE BREAKS AND  
 RADIUS FOR TOWN HIGHWAYS)  
 FAIR HAVEN:  
 STA 49+36.80 - STA 53+00.00 LT & RT

646.412 DURABLE 4 INCH YELLOW LINE, THERMOPLASTIC  
 (ALL LINES WILL INCLUDE C/L BREAKS FOR  
 TOWN HIGHWAYS) S=SOLID, D=DASHED  
 FAIR HAVEN: LT C RT  
 STA 49+36.80 - STA 53+00.00 S - S

646.612 TEMPORARY 4 INCH YELLOW LINE, PAINT  
 (ALL LINES WILL INCLUDE C/L BREAKS FOR  
 TOWN HIGHWAYS) S=SOLID, D=DASHED  
 FAIR HAVEN: LT C RT  
 STA 49+36.80 - STA 53+00.00 S - S

646.442 DURABLE 8 INCH WHITE LINE, THERMOPLASTIC  
 FAIR HAVEN:  
 STA 50+15.00 - STA 50+27.00 FIRE HYDRANT NO PARKING ZONE, RT

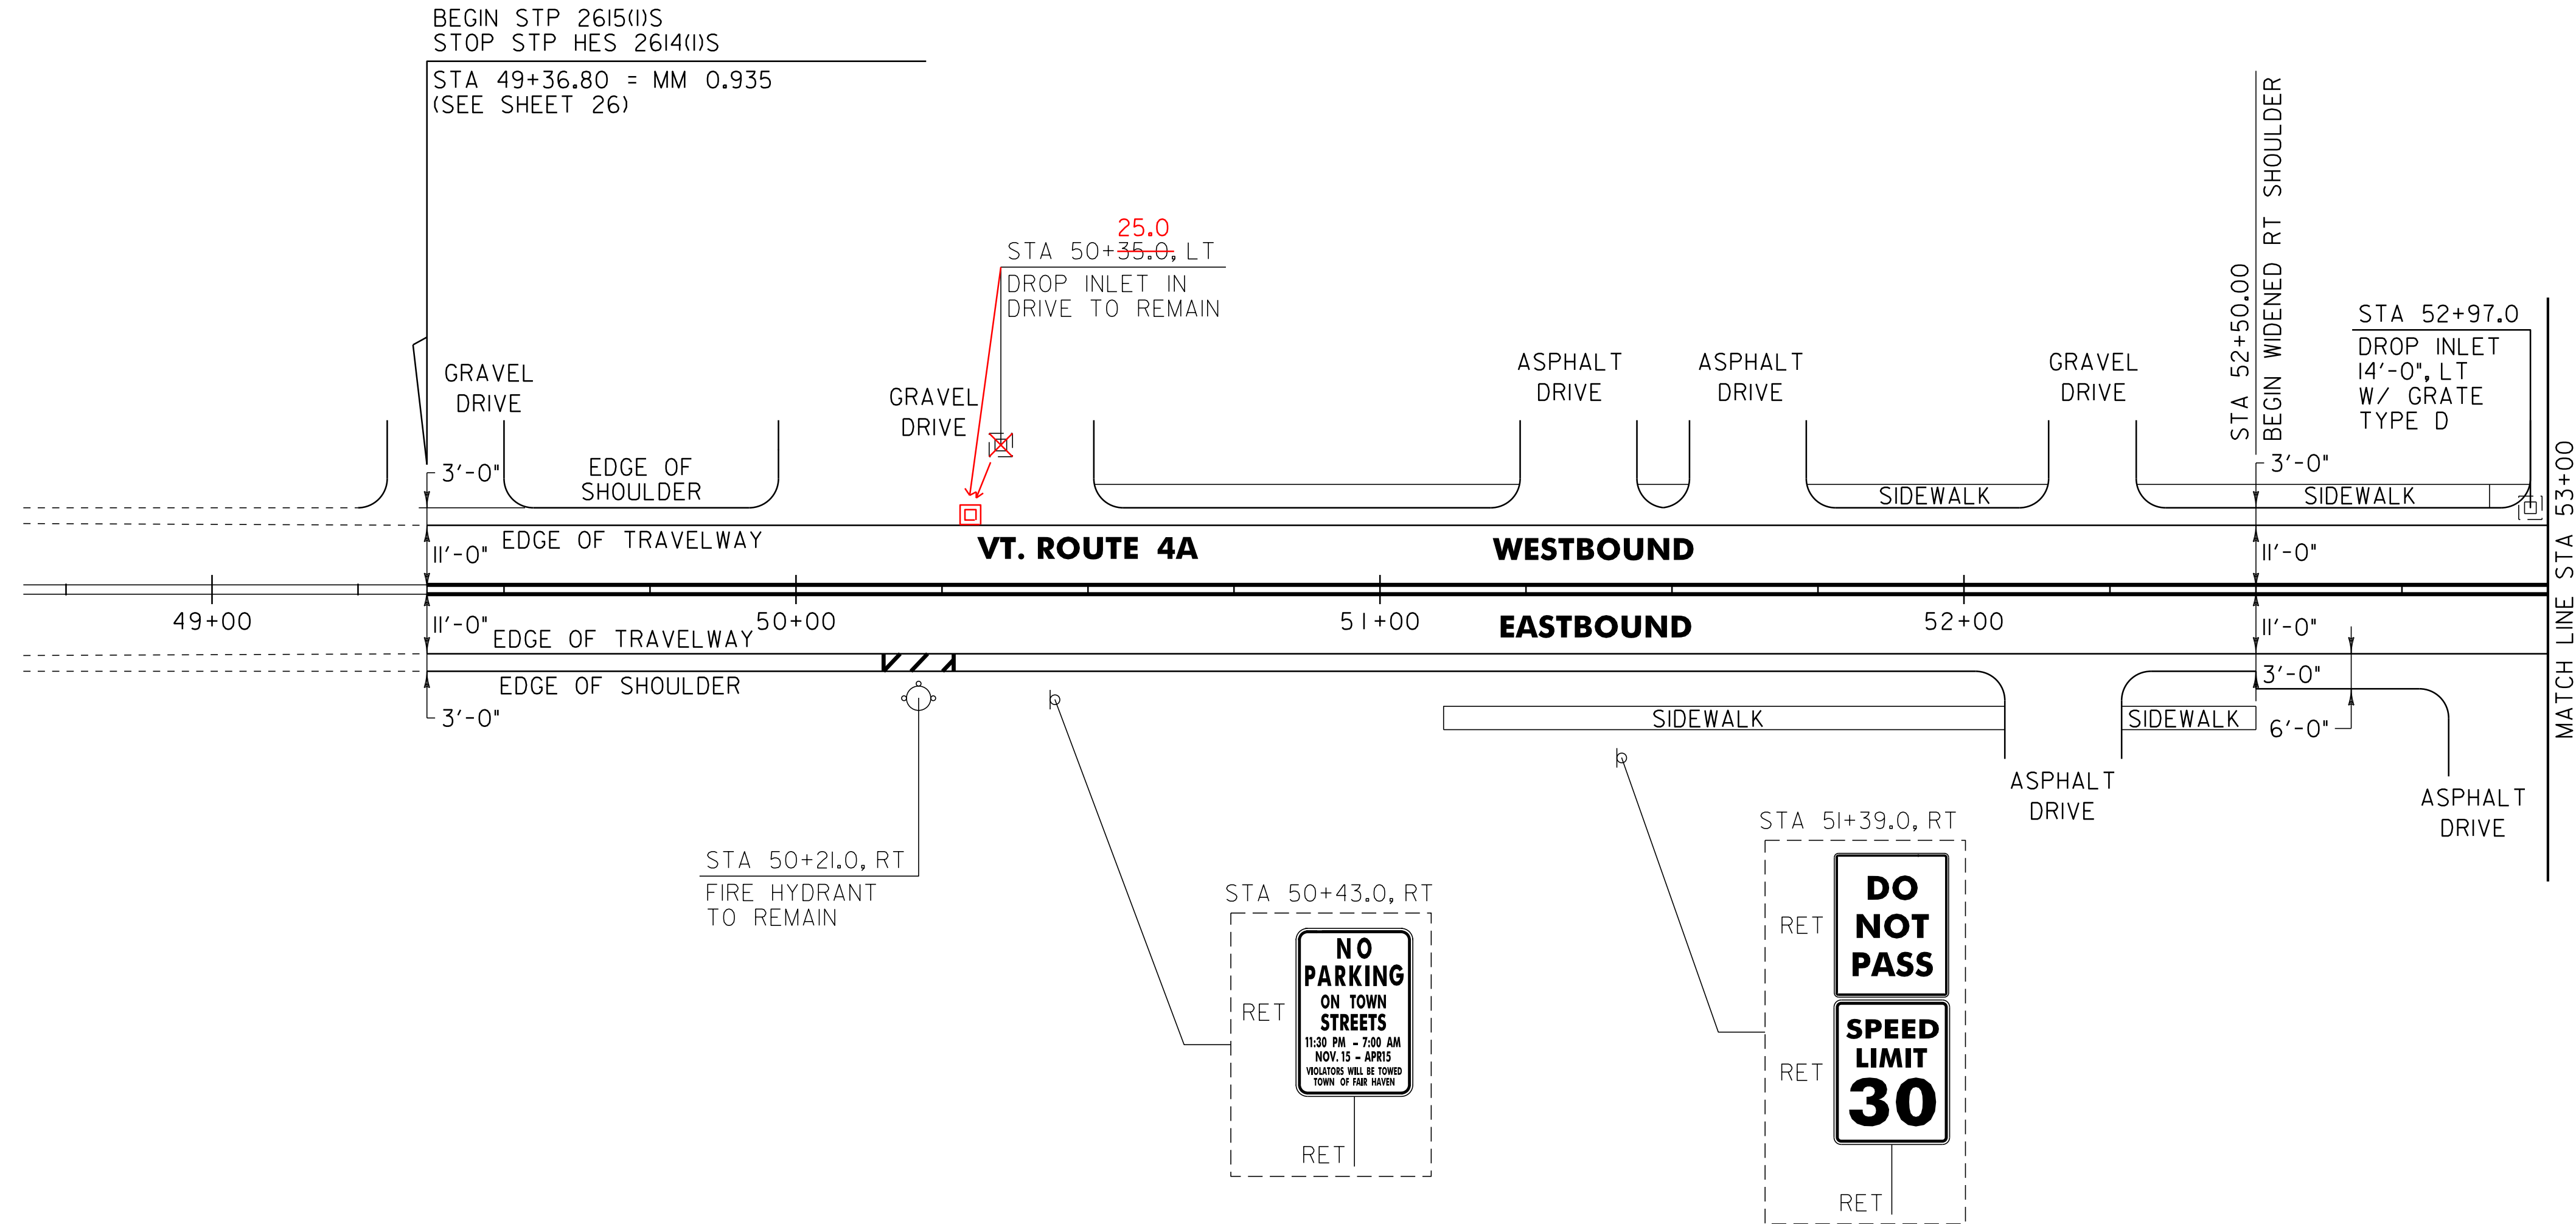

**NOTES:**

- THE CONTRACTOR SHALL REHAB. THE EXISTING DROP INLETS, CATCH BASINS OR MANHOLES TO A DEPTH AS DIRECTED BY THE RESIDENT ENGINEER. ALL REHAB. WORK WILL BE PAID FOR UNDER THE APPLICABLE REHAB. ITEM AS DIRECTED BY THE RESIDENT ENGINEER. ALL EXISTING UTILITIES MARKED "TO REMAIN" SHALL NOT BE ALTERED OR REHABILITATED UNLESS DIRECTED OTHERWISE BY THE RESIDENT ENGINEER.
- SEE SHEET 10 FOR FIRE HYDRANT PAVING MARKING DETAIL.

604.412, 604.415 OR 604.418  
 REHAB. DROP INLETS, CATCH BASINS OR MANHOLES (SEE NOTE 1)

FAIR HAVEN:  
 STA 52+97.0 LT STA 50+25 LT

**SIGN LEGEND**  
 R = REMOVE  
 S = SALVAGE  
 N = NEW  
 RET = RETAIN  
 B-B = BACK TO BACK  
 EXISTING = - - - - -  
 NEW = \_\_\_\_\_

**NOT TO SCALE**

<b>PROJECT LAYOUT SHEET #1</b>	PROJECT NAME: FAIR HAVEN
	PROJECT NUMBER: STP 2615(1)S
	FILE NAME: p06c060.dgn
	PLOT DATE: 22-FEB-2012 12:51
DESIGNED BY: M.J.M.	DRAWN BY: C.A.K.
IPARM FILE: p06c060I01.i	CHECKED BY: D.E.G.
	SHEET 88 OF 157