

646.402 DURABLE 4 INCH WHITE LINE, THERMOPLASTIC
 (ALL LINES WILL INCLUDE EDGE LINE BREAKS AND RADIUS FOR TOWN HIGHWAYS)
 FAIR HAVEN:
 STA 73+00.00 - STA 78+00.00 LT & RT

646.602 TEMPORARY 4 INCH WHITE LINE, PAINT
 (ALL LINES WILL INCLUDE EDGE LINE BREAKS AND RADIUS FOR TOWN HIGHWAYS)
 FAIR HAVEN:
 STA 73+00.00 - STA 78+00.00 LT & RT

646.412 DURABLE 4 INCH YELLOW LINE, THERMOPLASTIC
 (ALL LINES WILL INCLUDE C/L BREAKS FOR TOWN HIGHWAYS) S=SOLID, D=DASHED
 FAIR HAVEN:
 STA 73+00.00 - STA 78+00.00 LT C RT S - S


646.612 TEMPORARY 4 INCH YELLOW LINE, PAINT
 (ALL LINES WILL INCLUDE C/L BREAKS FOR TOWN HIGHWAYS) S=SOLID, D=DASHED
 FAIR HAVEN:
 STA 73+00.00 - STA 78+00.00 LT C RT S - S

646.442 DURABLE 8 INCH WHITE LINE, THERMOPLASTIC
 FAIR HAVEN:
 STA 75+29.00 - STA 75+41.00 FIRE HYDRANT, NO PARKING, RT

646.492 DURABLE LETTER OR SYMBOL, THERMOPLASTIC
 FAIR HAVEN:
 STA 73+29.80 RT, "S,T,O,P" (4 EA)
 STA 73+70.20 RT, "A,H,E,A,D" (5 EA)

646.692 TEMPORARY LETTER OR SYMBOL, PAINT
 FAIR HAVEN:
 STA 73+29.80 RT, "S,T,O,P" (8 EA)
 STA 73+70.20 RT, "A,H,E,A,D" (10 EA)

675.50 REMOVING SIGNS
 AS SHOWN - 5
 675.60 ERECTING SALVAGED SIGNS
 AS SHOWN - 2

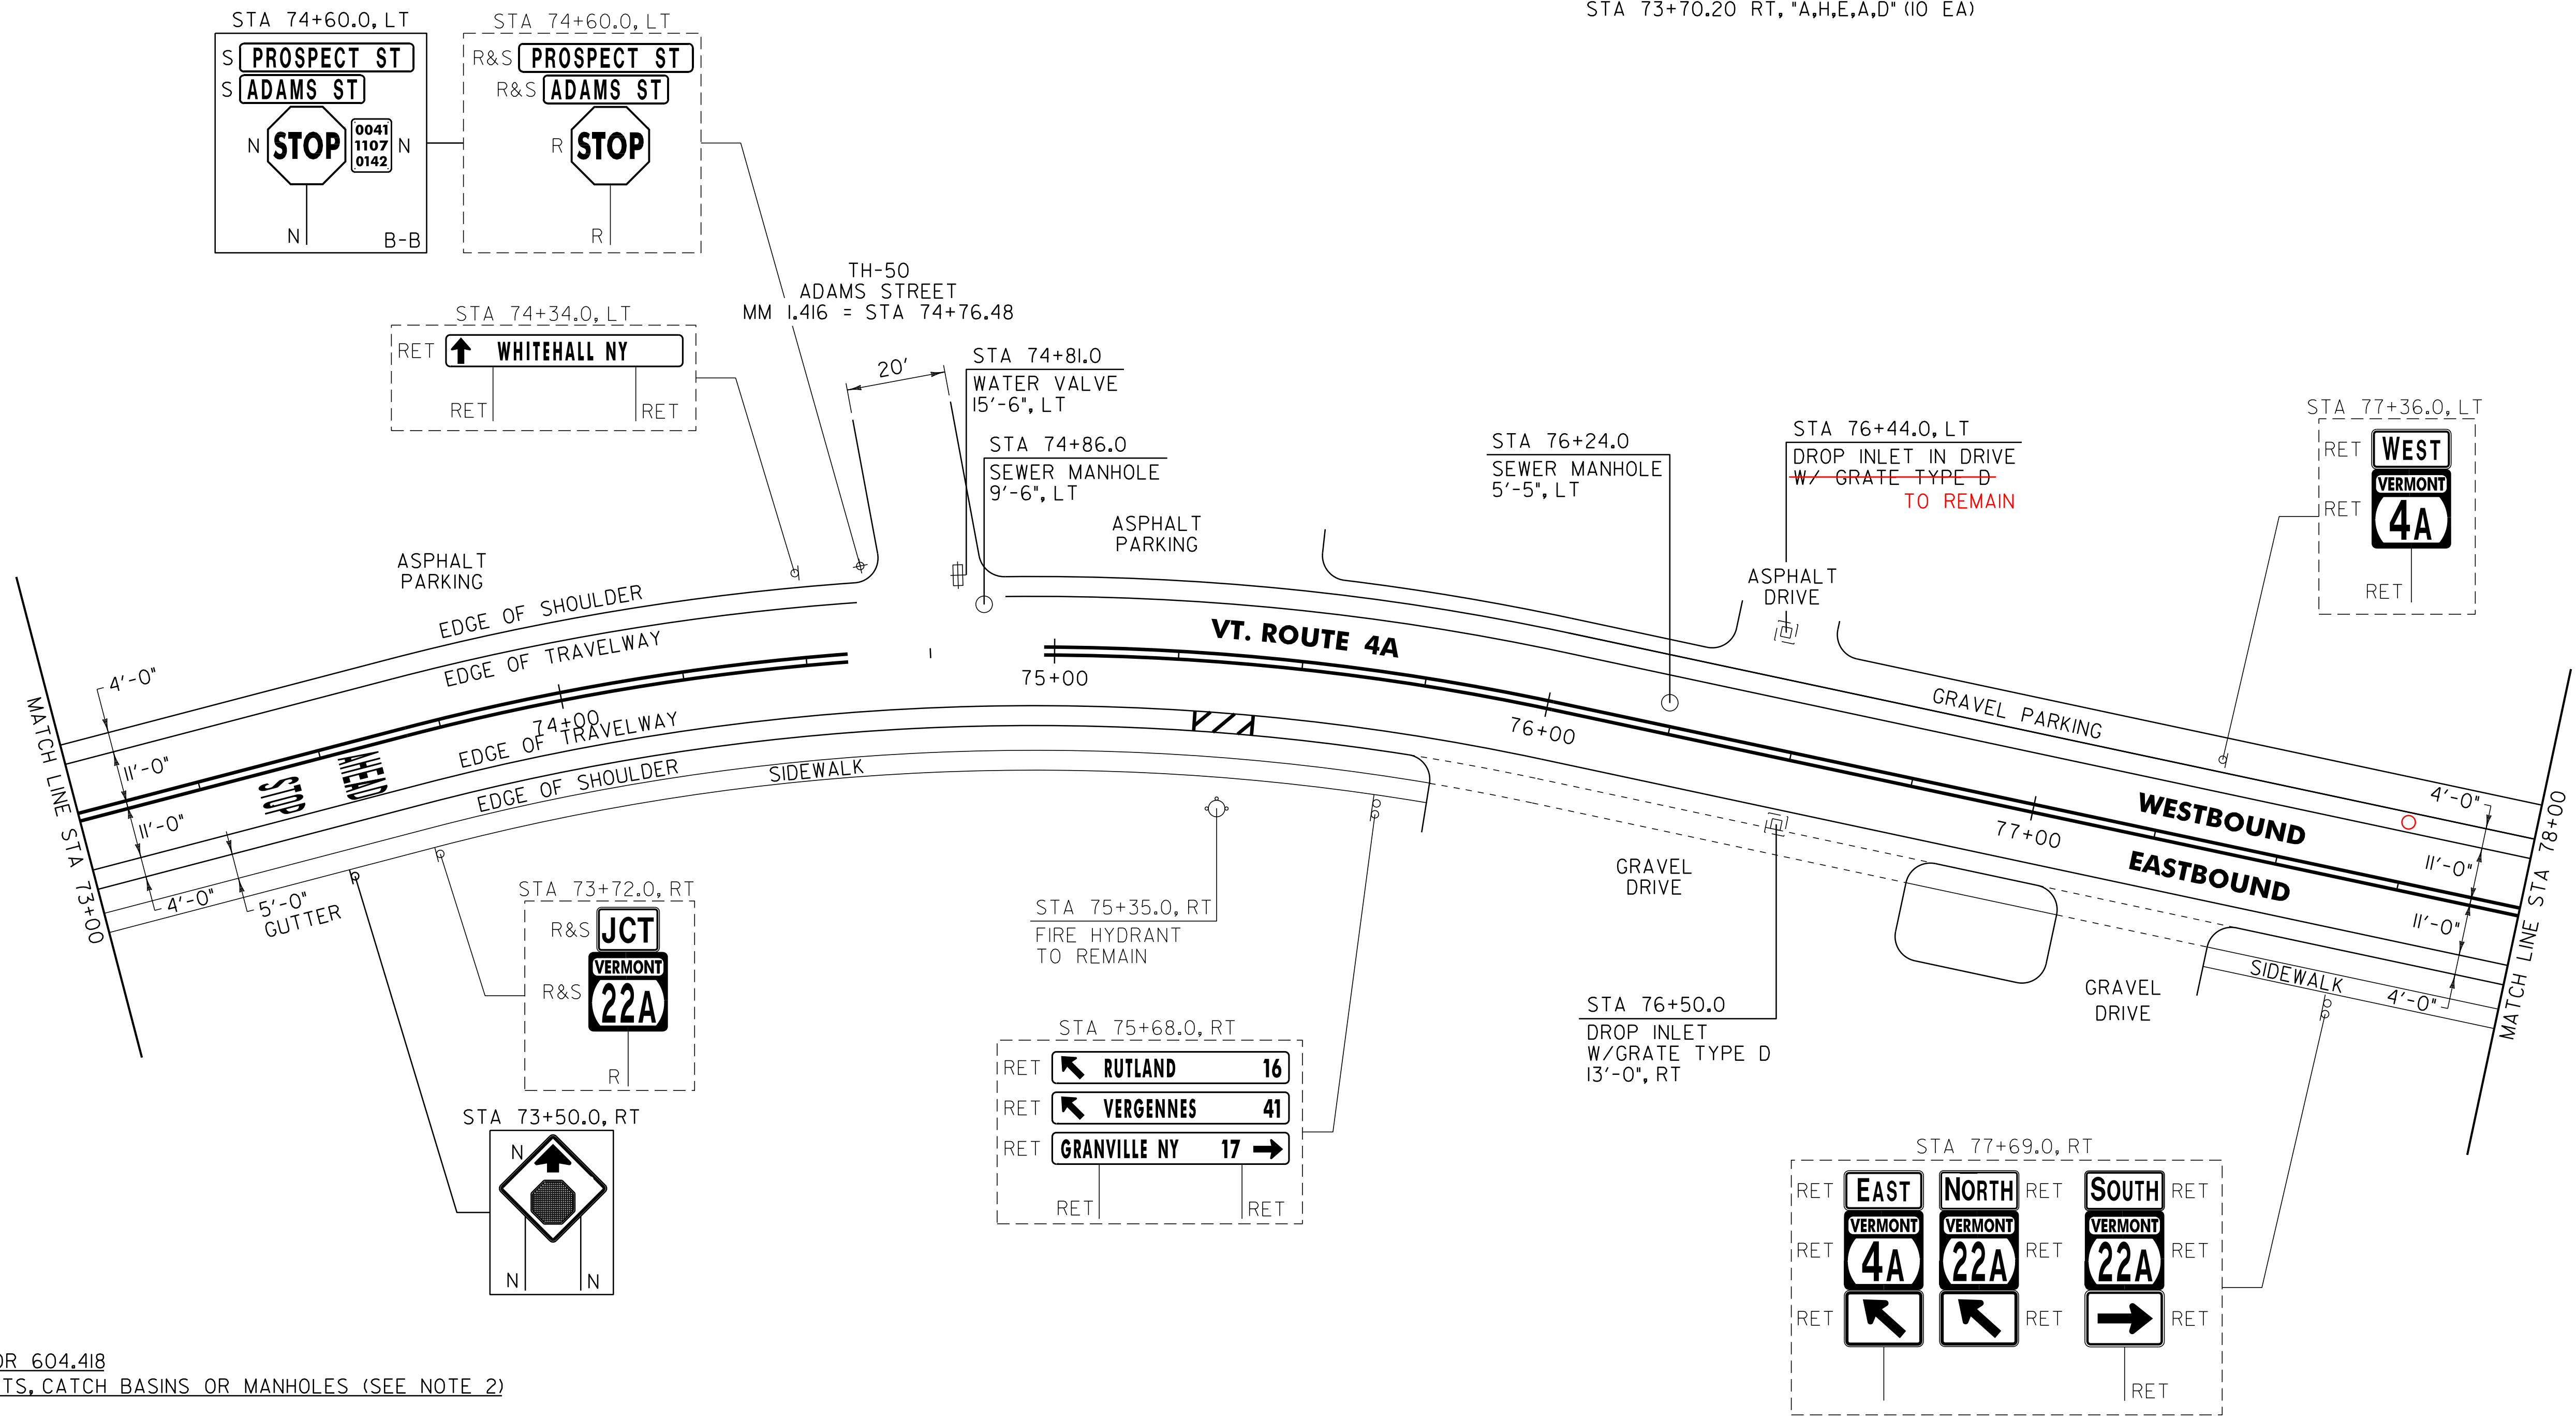

604.412, 604.415 OR 604.418
 REHAB. DROP INLETS, CATCH BASINS OR MANHOLES (SEE NOTE 2)

FAIR HAVEN:
 STA 76+44.0 LT — DID NOT TOUCH
 STA 76+50.0 RT

604.42 CHANGING ELEVATION OF SEWER MANHOLES

FAIR HAVEN:
 STA 74+86.0 LT 77+72 LT
 STA 76+24.0 LT

616.47 BITUMINOUS CONCRETE GUTTERS AND TRAFFIC ISLANDS

FAIR HAVEN:
 STA 73+00.0 - STA 78+00.0 RT (30.9 TON)

629.20 ADJUST ELEVATION OF VALVE BOX

FAIR HAVEN:
 STA 74+81.0 LT

NOTES:

- PAVING LIMIT ON ALL TOWN HIGHWAYS SHALL BE MEASURED 25 FT BACK FROM VT. ROUTE 4A EDGE OF SHOULDER UNLESS DENOTED OTHERWISE ON THE PLANS OR AS DIRECTED BY THE RESIDENT ENGINEER.
- THE CONTRACTOR SHALL REHAB. THE EXISTING DROP INLETS, CATCH BASINS OR MANHOLES TO A DEPTH AS DIRECTED BY THE RESIDENT ENGINEER. ALL REHAB. WORK WILL BE PAID FOR UNDER THE APPLICABLE REHAB. ITEM AS DIRECTED BY THE RESIDENT ENGINEER. ALL EXISTING UTILITIES MARKED "TO REMAIN" SHALL NOT BE ALTERED OR REHABILITATED UNLESS DIRECTED OTHERWISE BY THE RESIDENT ENGINEER.

SIGN LEGEND
 R = REMOVE
 S = SALVAGE
 N = NEW
 RET = RETAIN
 B-B = BACK TO BACK
 EXISTING = - - - - -
 NEW = _____

NOT TO SCALE

PROJECT LAYOUT SHEET #6	PROJECT NAME: FAIR HAVEN
	PROJECT NUMBER: STP 2615(1)S
	FILE NAME: p06c060.dgn
	PLOT DATE: 22-FEB-2012 12:53
DESIGNED BY: M.J.M.	DRAWN BY: C.A.K.
IPARM FILE: p06c060i06.i	CHECKED BY: D.E.G.
	SHEET 93 OF 157