

646.402 DURABLE 4 INCH WHITE LINE, THERMOPLASTIC  
 (ALL LINES WILL INCLUDE EDGE LINE BREAKS AND  
 RADIUS FOR TOWN HIGHWAYS)  
 FAIR HAVEN:  
 STA 78+00.00 - STA 83+00.00 LT & RT

646.412 DURABLE 4 INCH YELLOW LINE, THERMOPLASTIC  
 (ALL LINES WILL INCLUDE C/L BREAKS FOR  
 TOWN HIGHWAYS) S=SOLID, D=DASHED  
 FAIR HAVEN:  
 STA 78+00.00 - STA 78+76.00 S - S  
 STA 79+60.00 - STA 83+00.00 S - S

646.602 TEMPORARY 4 INCH WHITE LINE, PAINT  
 (ALL LINES WILL INCLUDE EDGE LINE BREAKS AND  
 RADIUS FOR TOWN HIGHWAYS)  
 FAIR HAVEN:  
 STA 78+00.00 - STA 83+00.00 LT & RT

646.612 TEMPORARY 4 INCH YELLOW LINE, PAINT  
 (ALL LINES WILL INCLUDE C/L BREAKS FOR  
 TOWN HIGHWAYS) S=SOLID, D=DASHED  
 FAIR HAVEN:  
 STA 78+00.00 - STA 78+76.00 S - S  
 STA 79+60.00 - STA 83+00.00 S - S


646.482 DURABLE 24 INCH STOP BAR, THERMOPLASTIC  
 FAIR HAVEN:  
 STA 78+77.00 RT

646.492 DURABLE LETTER OR SYMBOL, THERMOPLASTIC  
 FAIR HAVEN:  
 STA 78+69.00 RT, "S,T,O,P" (4 EA)

646.682 TEMPORARY 24 INCH STOP BAR, PAINT  
 FAIR HAVEN:  
 STA 78+77.00 RT

646.692 TEMPORARY LETTER OR SYMBOL, PAINT  
 FAIR HAVEN:  
 STA 78+69.00 RT, "S,T,O,P" (8 EA)

675.50 REMOVING SIGNS  
 AS SHOWN - 5  
 675.60 ERECTING SALVAGED SIGNS  
 AS SHOWN - 2

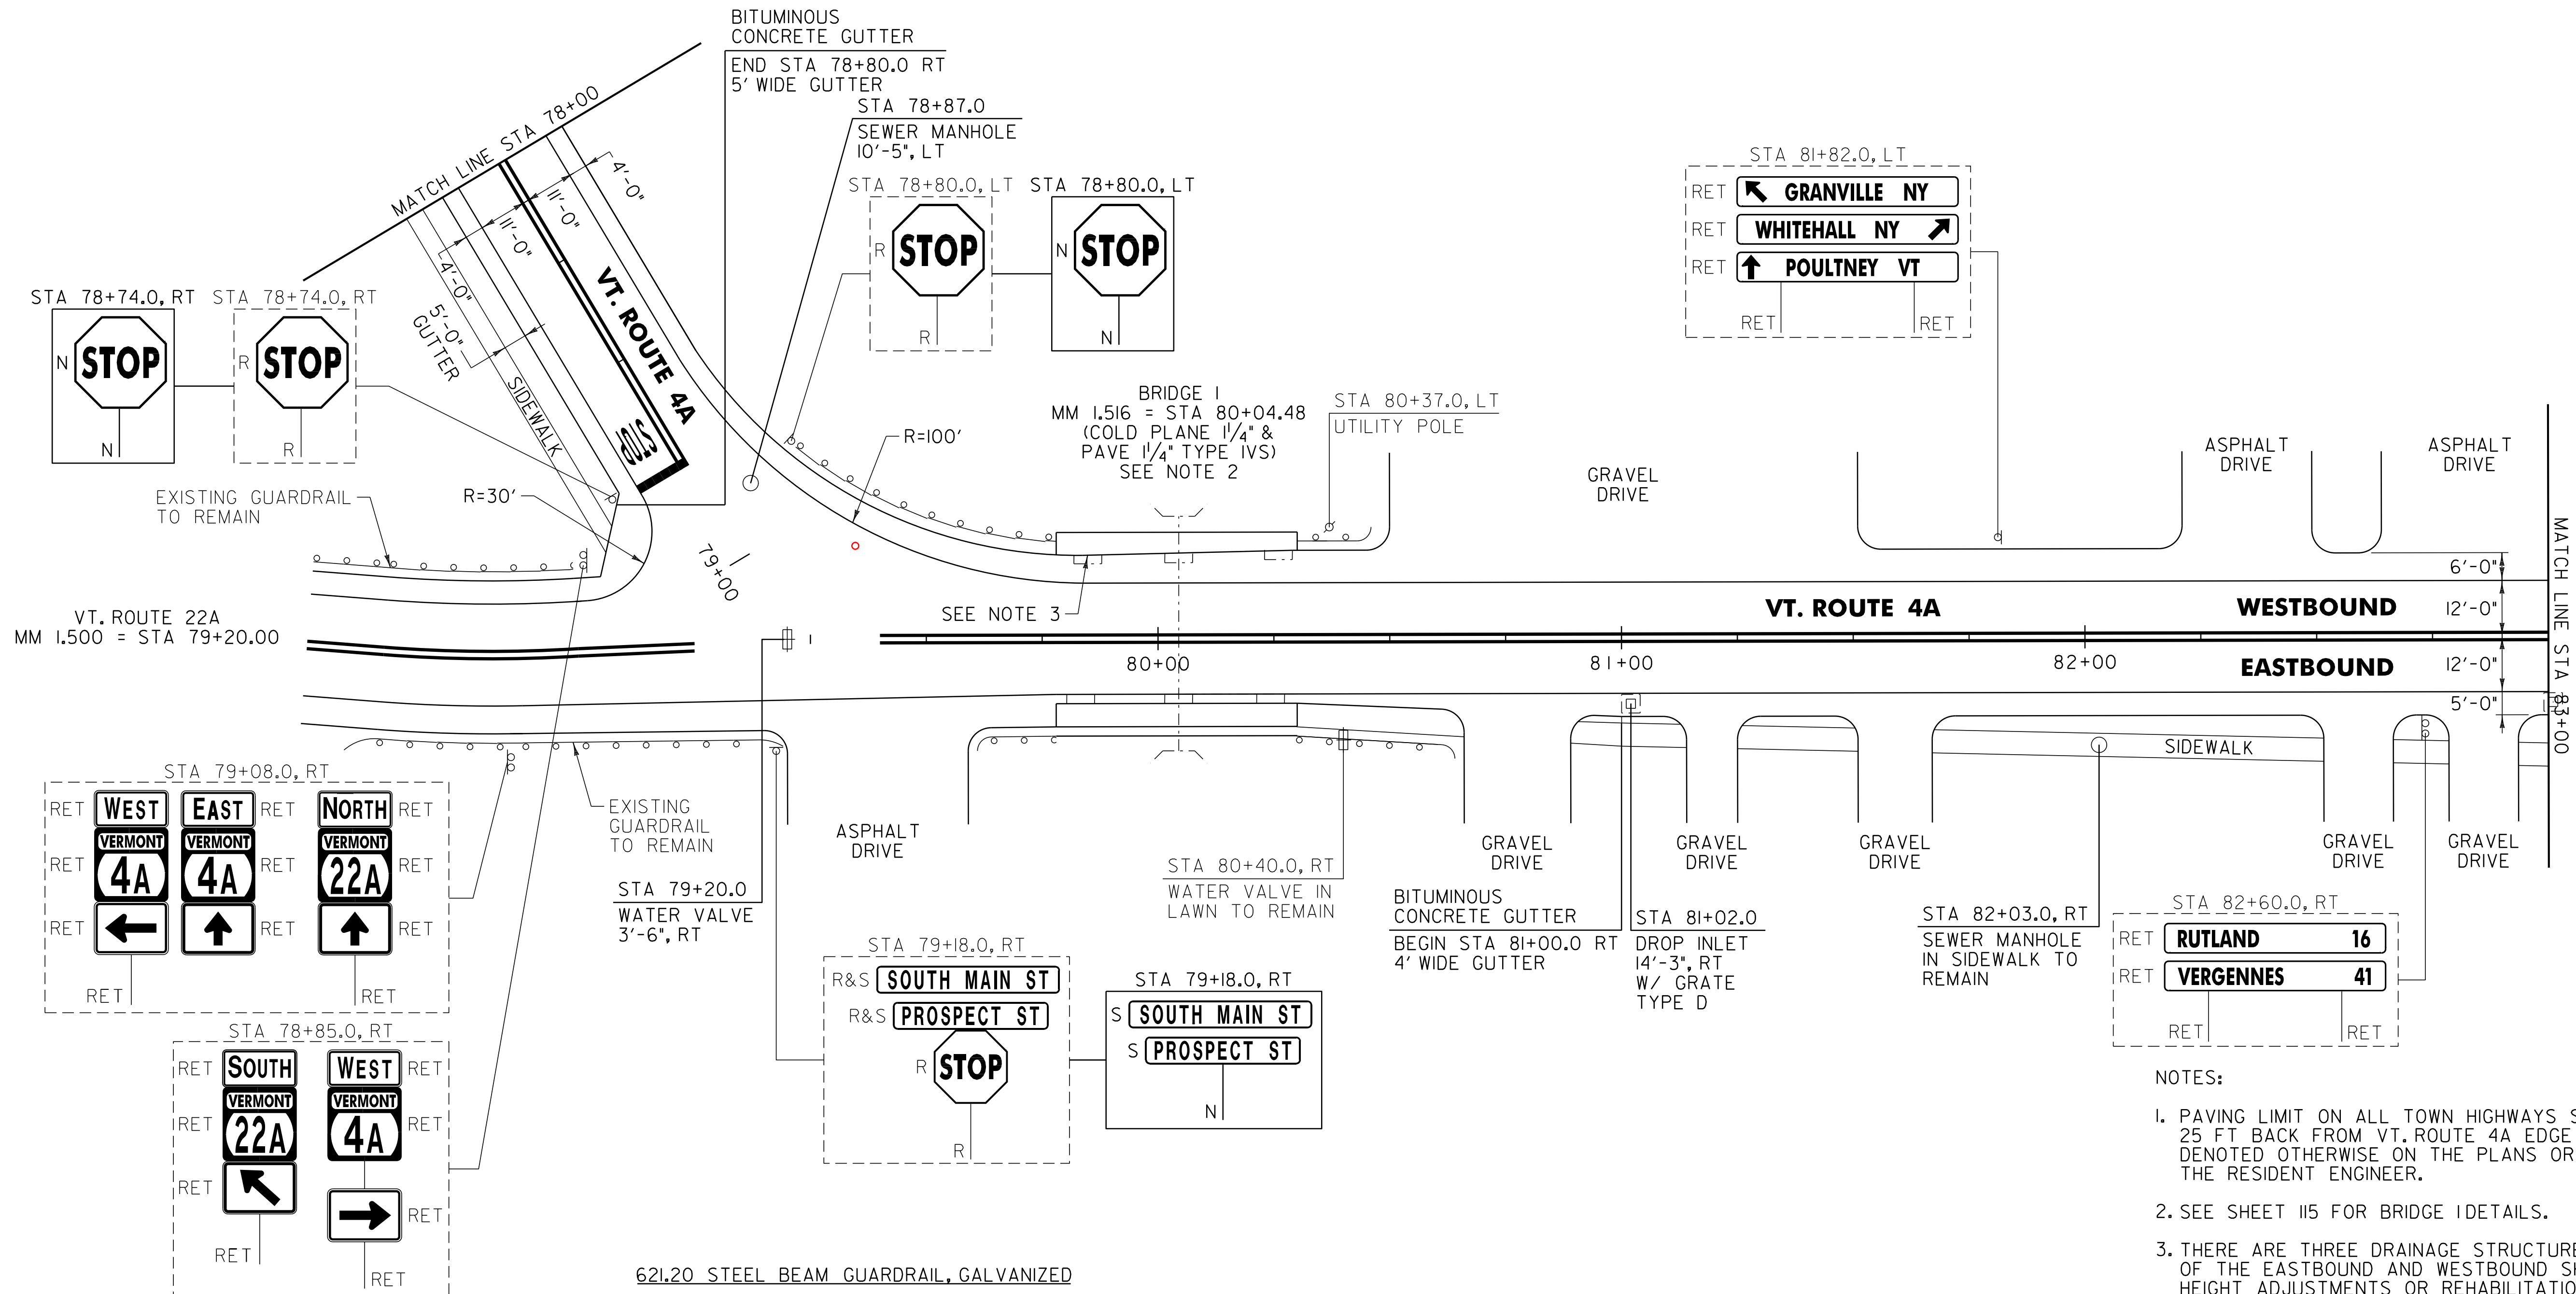

- NOTES:
- PAVING LIMIT ON ALL TOWN HIGHWAYS SHALL BE MEASURED 25 FT BACK FROM VT. ROUTE 4A EDGE OF SHOULDER UNLESS DENOTED OTHERWISE ON THE PLANS OR AS DIRECTED BY THE RESIDENT ENGINEER.
  - SEE SHEET I15 FOR BRIDGE 1 DETAILS.
  - THERE ARE THREE DRAINAGE STRUCTURES LOCATED IN EACH OF THE EASTBOUND AND WESTBOUND SHOULDERS ON BR 1. HEIGHT ADJUSTMENTS OR REHABILITATIONS WILL NOT BE REQUIRED.
  - THE CONTRACTOR SHALL REHAB. THE EXISTING DROP INLETS, CATCH BASINS OR MANHOLES TO A DEPTH AS DIRECTED BY THE RESIDENT ENGINEER. ALL REHAB. WORK WILL BE PAID FOR UNDER THE APPLICABLE REHAB. ITEM AS DIRECTED BY THE RESIDENT ENGINEER. ALL EXISTING UTILITIES MARKED "TO REMAIN" SHALL NOT BE ALTERED OR REHABILITATED UNLESS DIRECTED OTHERWISE BY THE RESIDENT ENGINEER.

- 621.20 STEEL BEAM GUARDRAIL, GALVANIZED  
 FAIR HAVEN: 78+89 52  
 STA 78+85.0 - STA 79+51.0 LT (39.5 LF)  
 STA 80+56.0 - STA 80+70.5 RT (14.5 LF)
- 621.21 HD STEEL BEAM GUARDRAIL, GALVANIZED  
 FAIR HAVEN:  
 STA 79+51.0 - STA 79+76.0 LT (32.5 LF)  
 STA 79+59.0 - STA 79+77.0 RT (34.5 LF)  
 STA 80+29.0 - STA 80+43.5 LT (44.5 LF) 80+56 (32.5 LF)  
 STA 80+31.0 - STA 80+56.0 RT (32.5 LF)
- 621.53 TERMINAL CONNECTOR FOR STEEL BEAM GUARDRAIL  
 FAIR HAVEN:  
 STA 79+76.0 - STA 79+78.0 LT  
 STA 79+77.0 - STA 79+79.0 RT  
 STA 80+27.0 - STA 80+29.0 LT  
 STA 80+29.0 - STA 80+31.0 RT
- 621.60 ANCHOR FOR STEEL BEAM RAIL  
 FAIR HAVEN:  
 STA 78+94.5 LT  
 STA 79+62.5 RT  
 STA 80+33.5 LT  
 STA 80+60.5 RT
- 621.80 REMOVAL AND DISPOSAL OF GUARDRAIL  
 FAIR HAVEN:  
 STA 78+85.0 - STA 79+78.0 LT (60.0 LF)  
 STA 79+59.0 - STA 79+79.0 RT (20.0 LF)  
 STA 80+27.0 - STA 80+48.0 LT (21.0 LF)  
 STA 80+29.0 - STA 80+69.0 RT (40.0 LF)
- 629.20 ADJUST ELEVATION OF VALVE BOX  
 FAIR HAVEN:  
 STA 79+20.0 RT

SIGN LEGEND  
 R = REMOVE  
 S = SALVAGE  
 N = NEW  
 RET = RETAIN  
 B-B = BACK TO BACK  
 EXISTING = - - - - -  
 NEW = \_\_\_\_\_

<b>PROJECT LAYOUT SHEET #7</b>	PROJECT NAME: FAIR HAVEN	PLOT DATE: 22-FEB-2012 12:53
	PROJECT NUMBER: STP 2615(I)S	DRAWN BY: C.A.K.
	FILE NAME: p06c060.dgn	CHECKED BY: D.E.G.
	PROJECT LEADER: D.E.G. DESIGNED BY: M.J.M. IPARM FILE: p06c060I07.i	SHEET 94 OF 157

604.412, 604.415 OR 604.418  
 REHAB. DROP INLETS, CATCH BASINS OR MANHOLES (SEE NOTE 4)  
 FAIR HAVEN:  
 STA 81+02.0 RT

604.42 CHANGING ELEVATION OF SEWER MANHOLES  
 FAIR HAVEN:  
 STA 78+87.0 LT  
 STA 79+32 LT

616.47 BITUMINOUS CONCRETE GUTTERS AND TRAFFIC ISLANDS  
 FAIR HAVEN:  
 STA 78+00.0 - STA 78+80.0 RT (5.0 TON)  
 STA 81+00.0 - STA 83+00.0 RT (10.4 TON)