


646.402 DURABLE 4 INCH WHITE LINE, THERMOPLASTIC
 (ALL LINES WILL INCLUDE EDGE LINE BREAKS AND RADIUS FOR TOWN HIGHWAYS)
 FAIR HAVEN:
 STA 88+00.00 - STA 89+58.00 LANE LINE LT
 STA 88+00.00 - STA 89+27.00 RT, PARKING STALL MARKINGS
 STA 88+00.00 - STA 88+77.00 LT, PARKING STALL MARKINGS
 STA 89+27.00 - STA 89+56.00 RT, NO PARKING HATCHING
 STA 89+64.00 - STA 90+85.00 DASHED LINE LT
 STA 89+64.00 - STA 89+84.00 RT, NO PARKING HATCHING
 STA 89+84.00 - STA 90+55.00 RT, PARKING SPACES
 STA 90+55.00 - STA 90+66.00 RT, NO PARKING HATCHING
 STA 90+66.00 - STA 90+96.00 RT, PARKING SPACES
 STA 90+96.00 - STA 91+21.00 RT, NO PARKING HATCHING
 STA 91+29.00 - STA 91+46.00 RT, NO PARKING HATCHING
 STA 91+46.00 - STA 92+02.00 RT, PARKING STALL MARKINGS
 STA 92+10.00 - STA 92+28.00 LT, NO PARKING HATCHING
 STA 92+14.00 - STA 92+96.00 RT, PARKING STALL MARKINGS
 STA 92+28.00 - STA 92+89.00 LT, PARKING SPACES
 STA 92+89.00 - STA 93+00.00 LT, NO PARKING HATCHING

646.602 TEMPORARY 4 INCH WHITE LINE, PAINT
 (ALL LINES WILL INCLUDE EDGE LINE BREAKS AND RADIUS FOR TOWN HIGHWAYS)
 FAIR HAVEN:
 STA 88+00.00 - STA 89+58.00 LANE LINE LT
 STA 88+00.00 - STA 89+27.00 RT, PARKING STALL MARKINGS
 STA 88+00.00 - STA 88+77.00 LT, PARKING STALL MARKINGS
 STA 89+27.00 - STA 89+56.00 RT, NO PARKING HATCHING
 STA 89+64.00 - STA 90+85.00 DASHED LINE LT
 STA 89+64.00 - STA 89+84.00 RT, NO PARKING HATCHING
 STA 89+84.00 - STA 90+55.00 RT, PARKING SPACES
 STA 90+55.00 - STA 90+66.00 RT, NO PARKING HATCHING
 STA 90+66.00 - STA 90+96.00 RT, PARKING SPACES
 STA 90+96.00 - STA 91+21.00 RT, NO PARKING HATCHING
 STA 91+29.00 - STA 91+46.00 RT, NO PARKING HATCHING
 STA 91+46.00 - STA 92+02.00 RT, PARKING STALL MARKINGS
 STA 92+10.00 - STA 92+28.00 LT, NO PARKING HATCHING
 STA 92+14.00 - STA 92+96.00 RT, PARKING STALL MARKINGS
 STA 92+28.00 - STA 92+89.00 LT, PARKING SPACES
 STA 92+89.00 - STA 93+00.00 LT, NO PARKING HATCHING

646.412 DURABLE 4 INCH YELLOW LINE, THERMOPLASTIC
 (ALL LINES WILL INCLUDE C/L BREAKS FOR TOWN HIGHWAYS) S=SOLID, D=DASHED
 FAIR HAVEN:
 STA 88+00.00 - STA 93+00.00 LT S - RT S
 STA 88+00.00 - STA 93+00.00 S - S
 646.612 TEMPORARY 4 INCH YELLOW LINE, PAINT
 (ALL LINES WILL INCLUDE C/L BREAKS FOR TOWN HIGHWAYS) S=SOLID, D=DASHED
 FAIR HAVEN:
 STA 88+00.00 - STA 93+00.00 LT S - RT S
 STA 88+00.00 - STA 93+00.00 S - S

646.492 DURABLE LETTER OR SYMBOL, THERMOPLASTIC
 FAIR HAVEN:
 STA 88+13.00 RT, HANDICAP MARKING (1EA)
 STA 88+46.10 C/L, "O,N,L,Y" (4 EA)
 STA 89+00.00 C/L, ARROW (1EA)
 STA 89+53.80 C/L, "O,N,L,Y" (4 EA)
 646.502 DURABLE CROSSWALK MARKING, THERMOPLASTIC
 FAIR HAVEN:
~~STA 89+60.0 LT/RT~~
 STA 89+69.0 - STA 92+17.0 LT
 STA 91+25.0 LT/RT
 STA 92+08.32 RT, TH-43

646.692 TEMPORARY LETTER OR SYMBOL, PAINT
 FAIR HAVEN:
 STA 88+13.00 RT, HANDICAP MARKING (2 EA)
 STA 89+00.00 C/L, ARROW (2 EA)
 646.702 TEMPORARY CROSSWALK MARKING, PAINT
 FAIR HAVEN:
 STA 89+60.0 LT/RT
 STA 89+69.0 - STA 92+17.0 LT
 STA 91+25.0 LT/RT
 STA 92+08.32 RT, TH-43
 675.50 REMOVING SIGNS
 AS SHOWN - 5
 675.60 ERECTING SALVAGED SIGNS
 AS SHOWN - 2

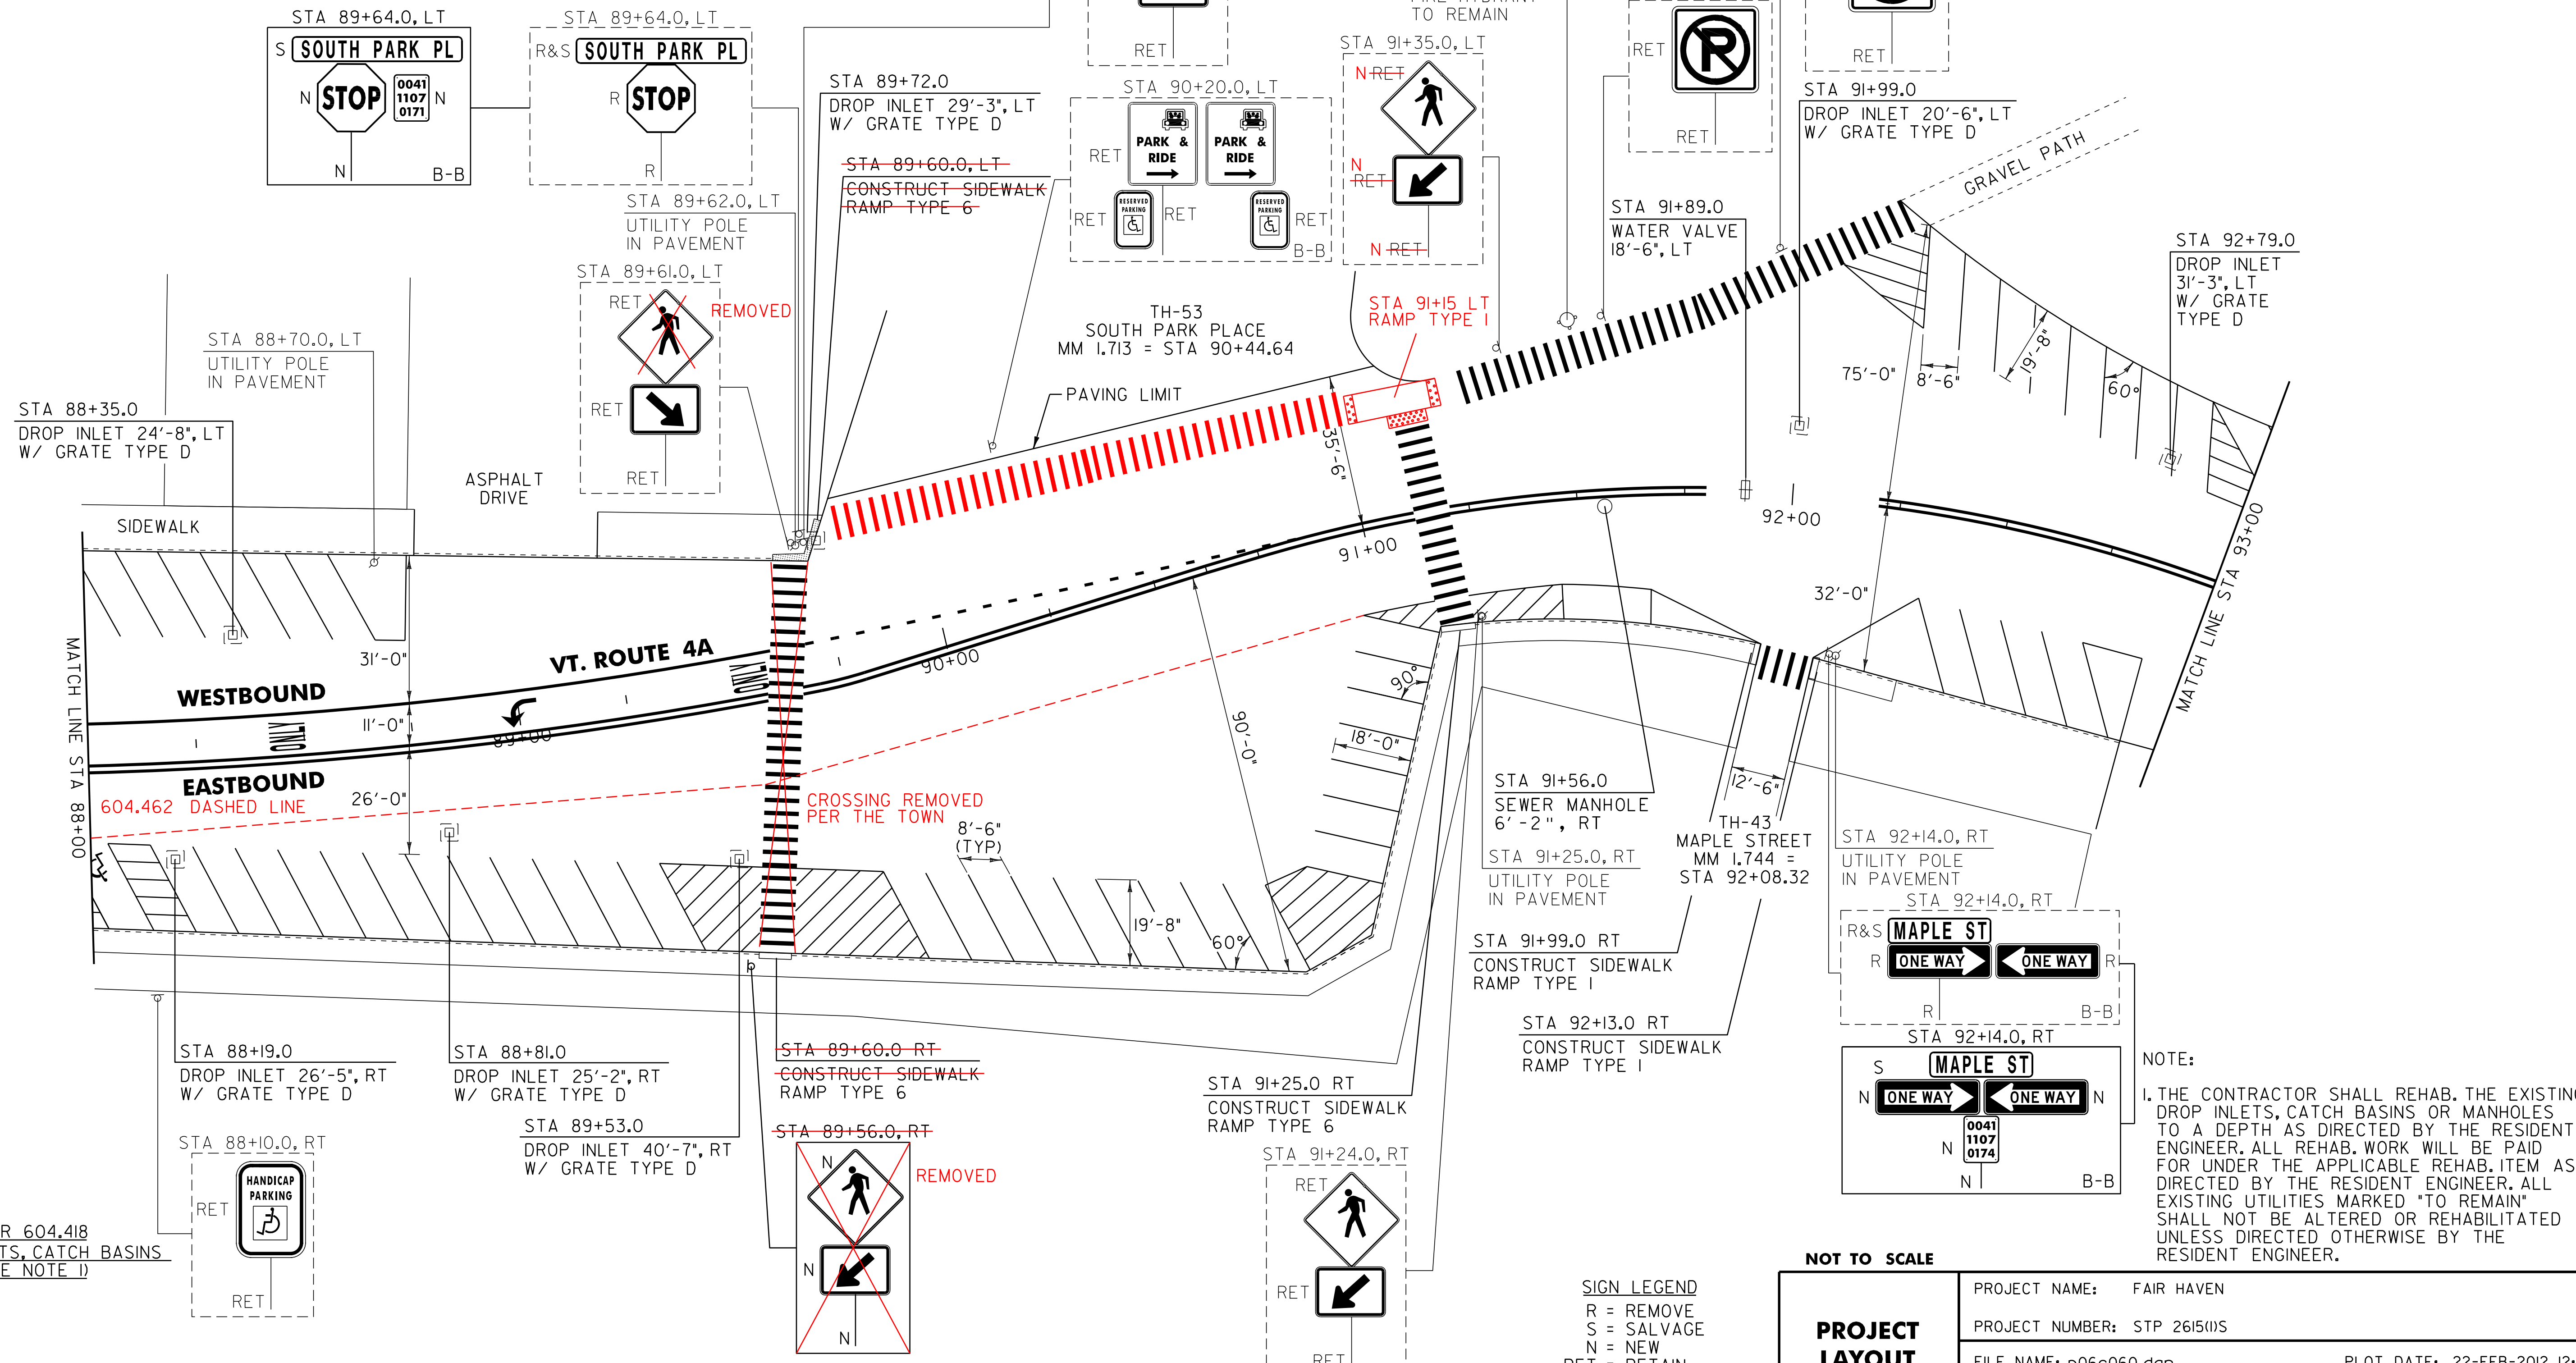

604.412, 604.415 OR 604.418
 REHAB. DROP INLETS, CATCH BASINS
 OR MANHOLES (SEE NOTE 1)
 FAIR HAVEN:
 STA 88+19.0 RT
 STA 88+35.0 LT
 STA 88+81.0 RT
 STA 89+53.0 RT
 STA 89+72.0 LT
 STA 91+99.0 LT
 STA 92+79.0 LT

604.42 CHANGING ELEVATION OF SEWER MANHOLES
 FAIR HAVEN:
 STA 91+56.0 CL
 629.20 ADJUST ELEVATION OF WATER VALVE
 FAIR HAVEN:
 STA 91+89.0 LT

NOTE:
 1. THE CONTRACTOR SHALL REHAB. THE EXISTING
 DROP INLETS, CATCH BASINS OR MANHOLES
 TO A DEPTH AS DIRECTED BY THE RESIDENT
 ENGINEER. ALL REHAB. WORK WILL BE PAID
 FOR UNDER THE APPLICABLE REHAB. ITEM AS
 DIRECTED BY THE RESIDENT ENGINEER. ALL
 EXISTING UTILITIES MARKED "TO REMAIN"
 SHALL NOT BE ALTERED OR REHABILITATED
 UNLESS DIRECTED OTHERWISE BY THE
 RESIDENT ENGINEER.

PROJECT LAYOUT SHEET #9	PROJECT NAME: FAIR HAVEN	PLOT DATE: 22-FEB-2012 12:53
	PROJECT NUMBER: STP 2615(1)S	DRAWN BY: C.A.K.
	FILE NAME: p06c060.dgn	CHECKED BY: D.E.G.
	PROJECT LEADER: D.E.G. DESIGNED BY: M.J.M. IPARM FILE: p06c060109.1	SHEET 96 OF 157

SIGN LEGEND
 R = REMOVE
 S = SALVAGE
 N = NEW
 RET = RETAIN
 B-B = BACK TO BACK
 EXISTING = - - - - -
 NEW = _____

NOT TO SCALE