
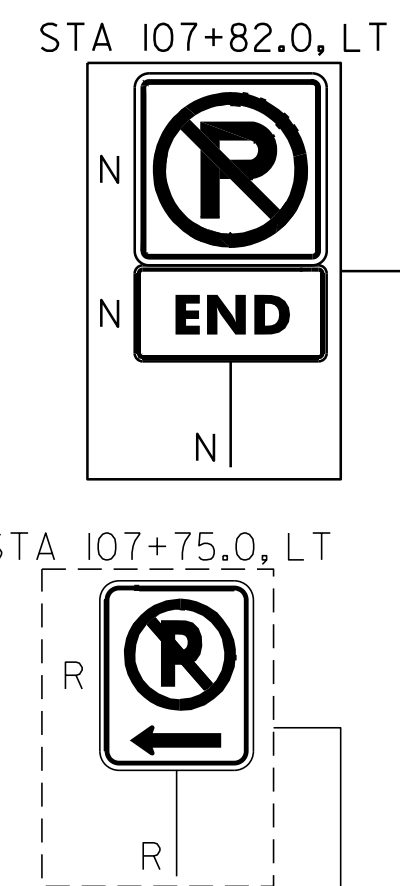


646.402 DURABLE 4 INCH WHITE LINE, THERMOPLASTIC  
(ALL LINES WILL INCLUDE EDGE LINE BREAKS AND RADIUS FOR TOWN HIGHWAYS)  
FAIR HAVEN:  
STA 103+00.00 - STA 108+00.00 LT & RT  
STA 107+82.00 - STA 108+00.00 NO PARKING ZONE,LT

646.602 TEMPORARY 4 INCH WHITE LINE, PAINT  
(ALL LINES WILL INCLUDE EDGE LINE BREAKS AND RADIUS FOR TOWN HIGHWAYS)  
FAIR HAVEN:  
STA 103+00.00 - STA 108+00.00 LT & RT  
STA 107+82.00 - STA 108+00.00 NO PARKING ZONE,LT

646.412 DURABLE 4 INCH YELLOW LINE, THERMOPLASTIC  
(ALL LINES WILL INCLUDE C/L BREAKS FOR TOWN HIGHWAYS) S=SOLID, D=DASHED  
FAIR HAVEN:  
STA 103+00.00 - STA 108+00.00 LT C RT S - S

646.612 TEMPORARY 4 INCH YELLOW LINE, PAINT  
(ALL LINES WILL INCLUDE C/L BREAKS FOR TOWN HIGHWAYS) S=SOLID, D=DASHED  
FAIR HAVEN:  
STA 103+00.00 - STA 108+00.00 LT C RT S - S

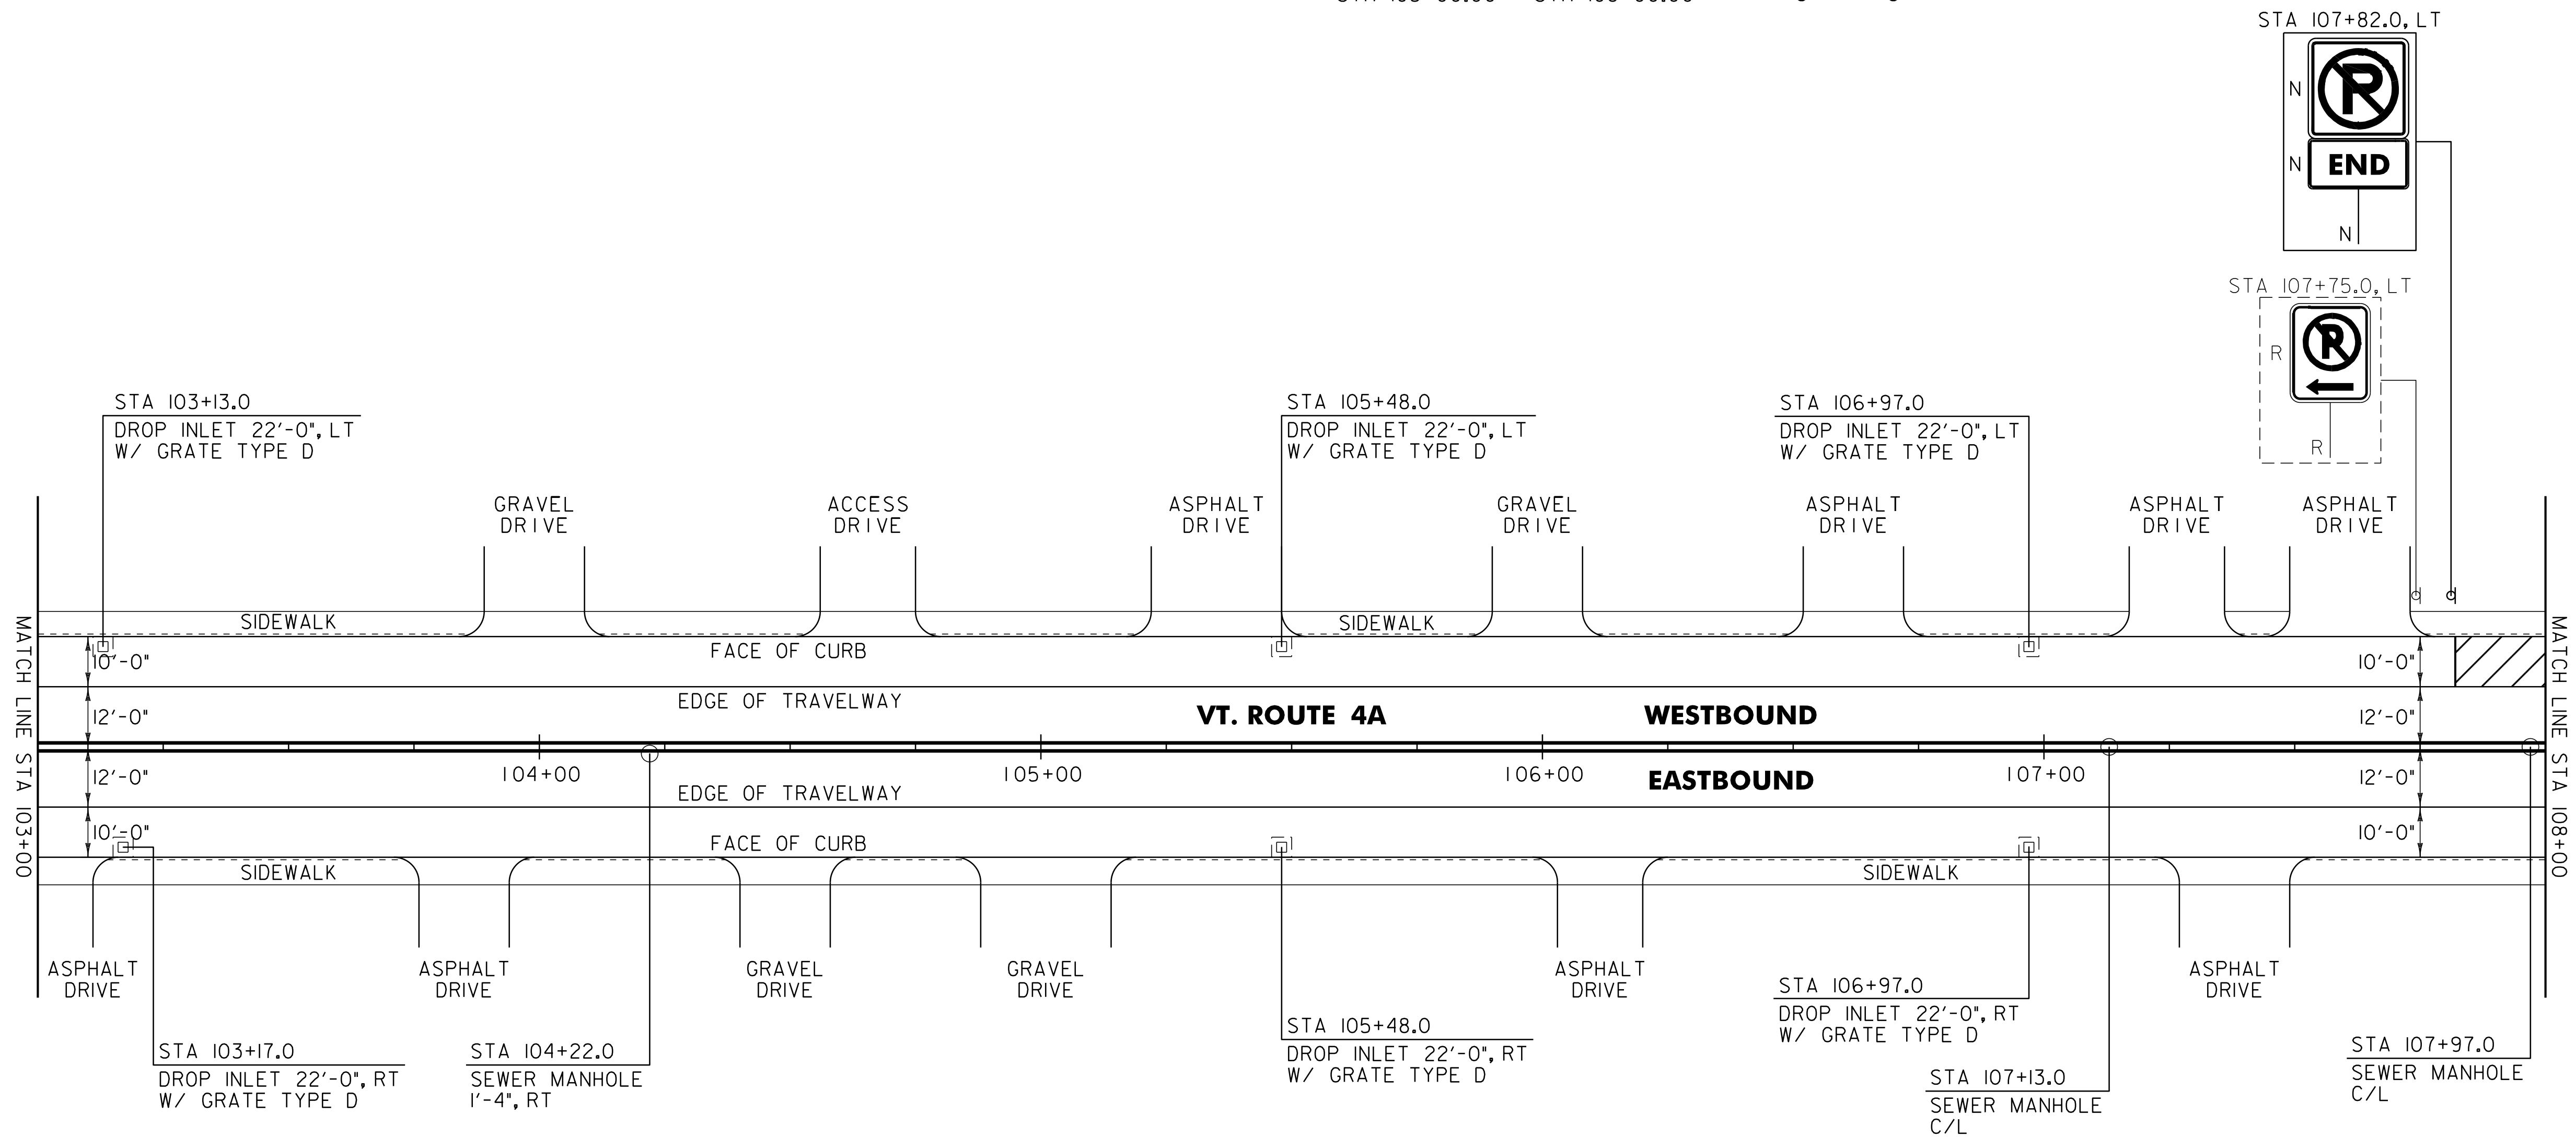

604.412, 604.415 OR 604.418  
REHAB. DROP INLETS, CATCH BASINS OR MANHOLES (SEE NOTE 1)

FAIR HAVEN:  
STA 103+13.0 LT  
STA 103+17.0 RT  
STA 105+48.0 LT  
STA 105+48.0 RT  
STA 106+97.0 LT  
STA 106+97.0 RT

604.42 CHANGING ELEVATION OF SEWER MANHOLES

FAIR HAVEN:  
STA 104+22.0 RT  
STA 107+13.0 C/L  
STA 107+97.0 C/L

NOTE:  
1. THE CONTRACTOR SHALL REHAB. THE EXISTING DROP INLETS, CATCH BASINS OR MANHOLES TO A DEPTH AS DIRECTED BY THE RESIDENT ENGINEER. ALL REHAB. WORK WILL BE PAID FOR UNDER THE APPLICABLE REHAB. ITEM AS DIRECTED BY THE RESIDENT ENGINEER. ALL EXISTING UTILITIES MARKED "TO REMAIN" SHALL NOT BE ALTERED OR REHABILITATED UNLESS DIRECTED OTHERWISE BY THE RESIDENT ENGINEER.

SIGN LEGEND  
R = REMOVE  
S = SALVAGE  
N = NEW  
RET = RETAIN  
B-B = BACK TO BACK  
EXISTING = - - - - -  
NEW = \_\_\_\_\_

**NOT TO SCALE**

<b>PROJECT LAYOUT SHEET #12</b>	PROJECT NAME: FAIR HAVEN	PLOT DATE: 22-FEB-2012 12:53
	PROJECT NUMBER: STP 2615(1)S	DRAWN BY: C.A.K.
	FILE NAME: p06c060.dgn	CHECKED BY: D.E.G.
	PROJECT LEADER: D.E.G. DESIGNED BY: M.J.M. IPARM FILE: p06c0601012.i	SHEET 99 OF 157