


646.402 DURABLE 4 INCH WHITE LINE, THERMOPLASTIC
(ALL LINES WILL INCLUDE EDGE LINE BREAKS AND
RADIUS FOR TOWN HIGHWAYS)
FAIR HAVEN:
STA 127+00.00 - STA 130+36.32 LT & RT

646.412 DURABLE 4 INCH YELLOW LINE, THERMOPLASTIC
(ALL LINES WILL INCLUDE C/L BREAKS FOR
TOWN HIGHWAYS) S=SOLID, D=DASHED
FAIR HAVEN:
STA 127+00.00 - STA 130+36.32 LT ☉ RT
S - S

646.602 TEMPORARY 4 INCH WHITE LINE, PAINT
(ALL LINES WILL INCLUDE EDGE LINE BREAKS AND
RADIUS FOR TOWN HIGHWAYS)
FAIR HAVEN:
STA 127+00.00 - STA 130+36.32 LT & RT

646.612 TEMPORARY 4 INCH YELLOW LINE, PAINT
(ALL LINES WILL INCLUDE C/L BREAKS FOR
TOWN HIGHWAYS) S=SOLID, D=DASHED
FAIR HAVEN:
STA 127+00.00 - STA 130+36.32 LT ☉ RT
S - S

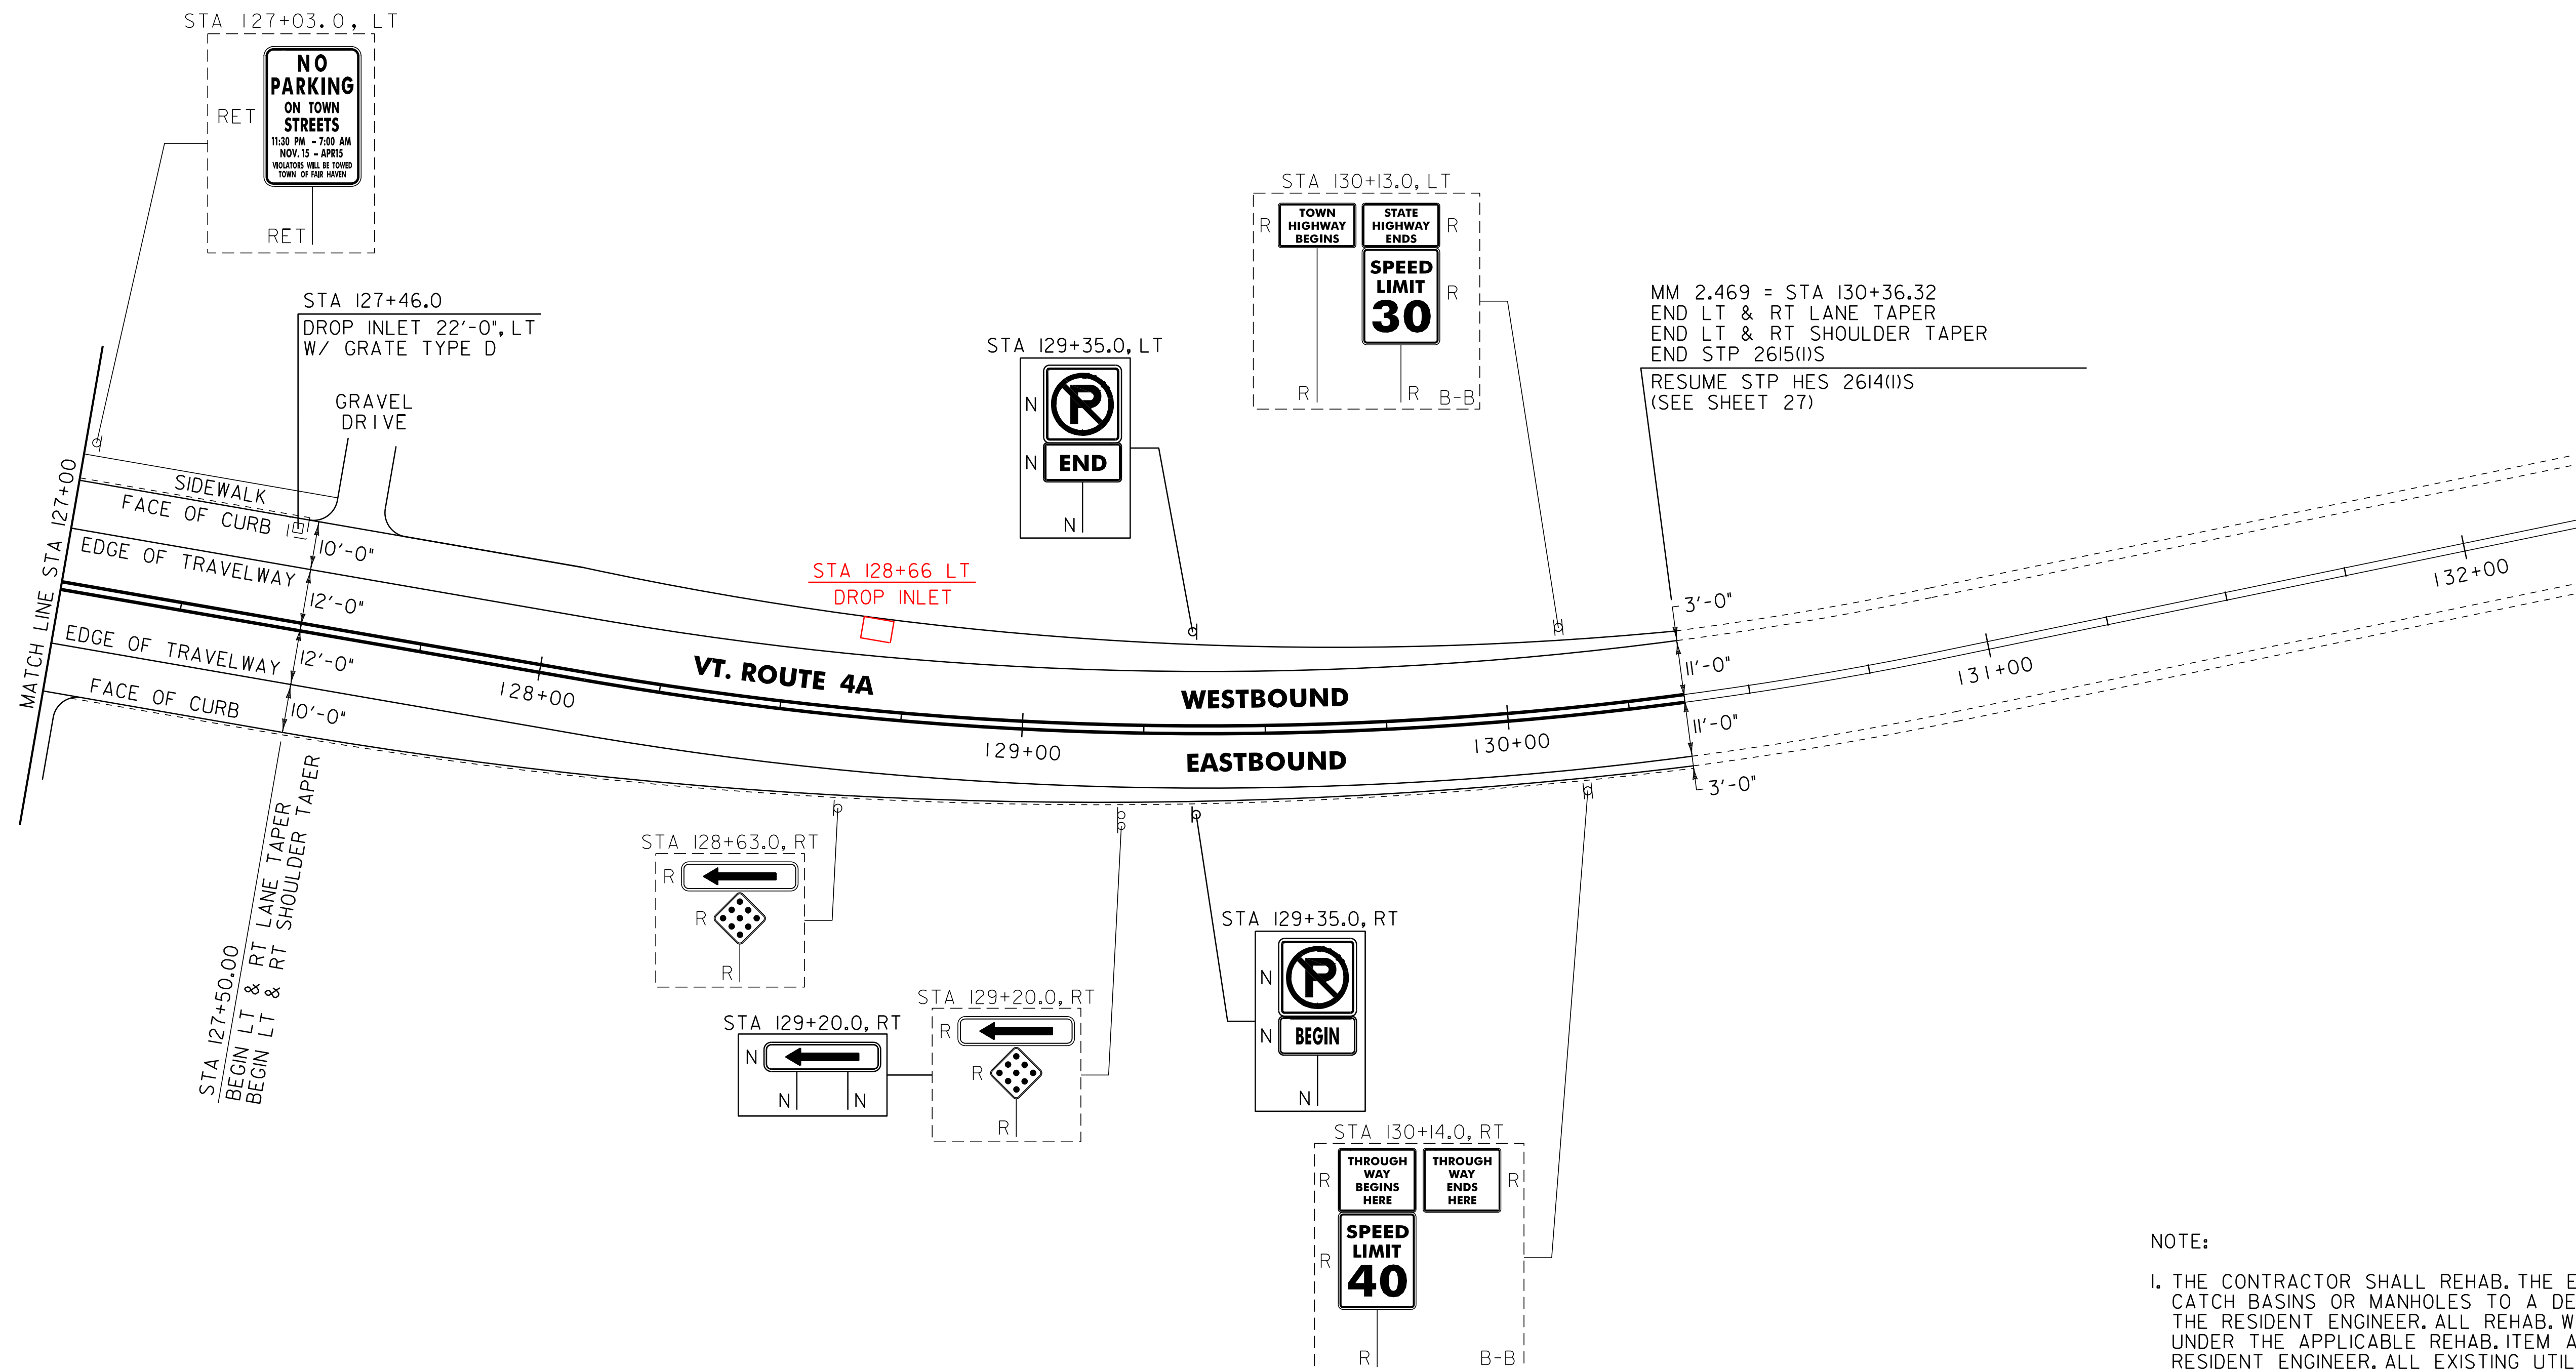

MM 2.469 = STA 130+36.32
END LT & RT LANE TAPER
END LT & RT SHOULDER TAPER
END STP 2615(I)S
RESUME STP HES 2614(I)S
(SEE SHEET 27)

NOTE:
I. THE CONTRACTOR SHALL REHAB. THE EXISTING DROP INLETS,
CATCH BASINS OR MANHOLES TO A DEPTH AS DIRECTED BY
THE RESIDENT ENGINEER. ALL REHAB. WORK WILL BE PAID FOR
UNDER THE APPLICABLE REHAB. ITEM AS DIRECTED BY THE
RESIDENT ENGINEER. ALL EXISTING UTILITIES MARKED
"TO REMAIN" SHALL NOT BE ALTERED OR REHABILITATED
UNLESS DIRECTED OTHERWISE BY THE RESIDENT ENGINEER.

NOT TO SCALE

SIGN LEGEND
R = REMOVE
S = SALVAGE
N = NEW
RET = RETAIN
B-B = BACK TO BACK
EXISTING = - - - - -
NEW = _____

PROJECT LAYOUT SHEET #17	PROJECT NAME: FAIR HAVEN	PLOT DATE: 22-FEB-2012 12:5
	PROJECT NUMBER: STP 2615(I)S	DRAWN BY: C.A.K.
	FILE NAME: p06c060.dgn	CHECKED BY: D.E.G.
	DESIGNED BY: M.J.M.	SHEET 104 OF 157
	IPARM FILE: p06c060I017.I	

604.412, 604.415 OR 604.418
REHAB. DROP INLETS, CATCH BASINS OR MANHOLES (SEE NOTE I)

FAIR HAVEN:
STA 127+46.0 LT STA 128+66.0 LT