


**VT. ROUTE 4A**

**WESTBOUND**

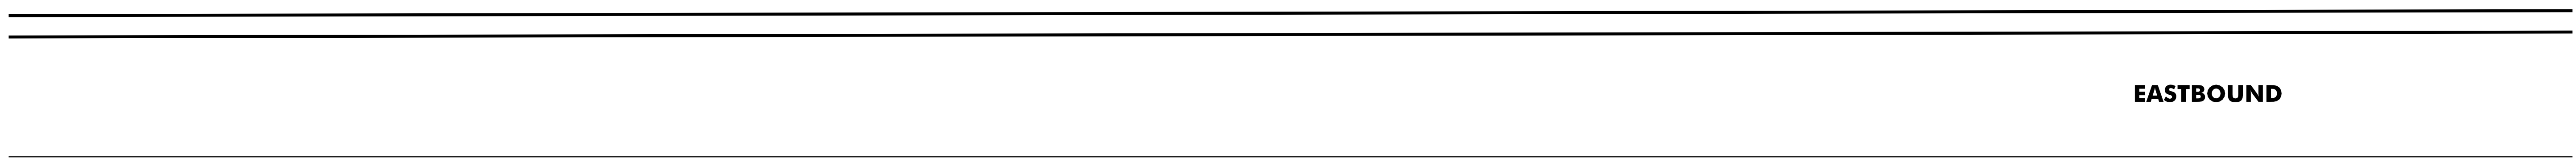

**EASTBOUND**

**BR 1 FAIR HAVEN MM 1.516 = STA 80+40.48**

NOTE:  
 1. SEE VAOT STANDARD SHEET G-16 FOR TERMINAL CONNECTOR FOR STEEL BEAM GUARDRAIL INSTALLATION DETAILS.

**NOT TO SCALE**

<b>BRIDGE DETAIL SHEET #1</b>	PROJECT NAME: FAIR HAVEN
	PROJECT NUMBER: STP 2615(1)S
	FILE NAME: p06c060.dgn
	PLOT DATE: 22-FEB-2012 12:55
PROJECT LEADER: D.E.G.	DRAWN BY: C.A.K.
DESIGNED BY: M.J.M.	CHECKED BY: D.E.G.
IPARM FILE: p06c060br1.i	SHEET 115 OF 157