

646.426 DURABLE 6 INCH WHITE LINE, RECESSED POLYUREA

U.S. ROUTE 4 WESTBOUND:
STA 29+00.00 - STA 32+20.00 EDGE LINE C/L

646.622 TEMPORARY 6 INCH WHITE LINE, PAINT


U.S. ROUTE 4 WESTBOUND:
STA 29+00.00 - STA 32+20.00 EDGE LINE C/L

646.436 DURABLE 6 INCH YELLOW LINE, RECESSED POLYUREA

U.S. ROUTE 4 WESTBOUND:
STA 29+00.00 - STA 32+20.00 EDGE LINE RT

646.632 TEMPORARY 6 INCH YELLOW LINE, PAINT

U.S. ROUTE 4 WESTBOUND:
STA 29+00.00 - STA 32+20.00 EDGE LINE RT

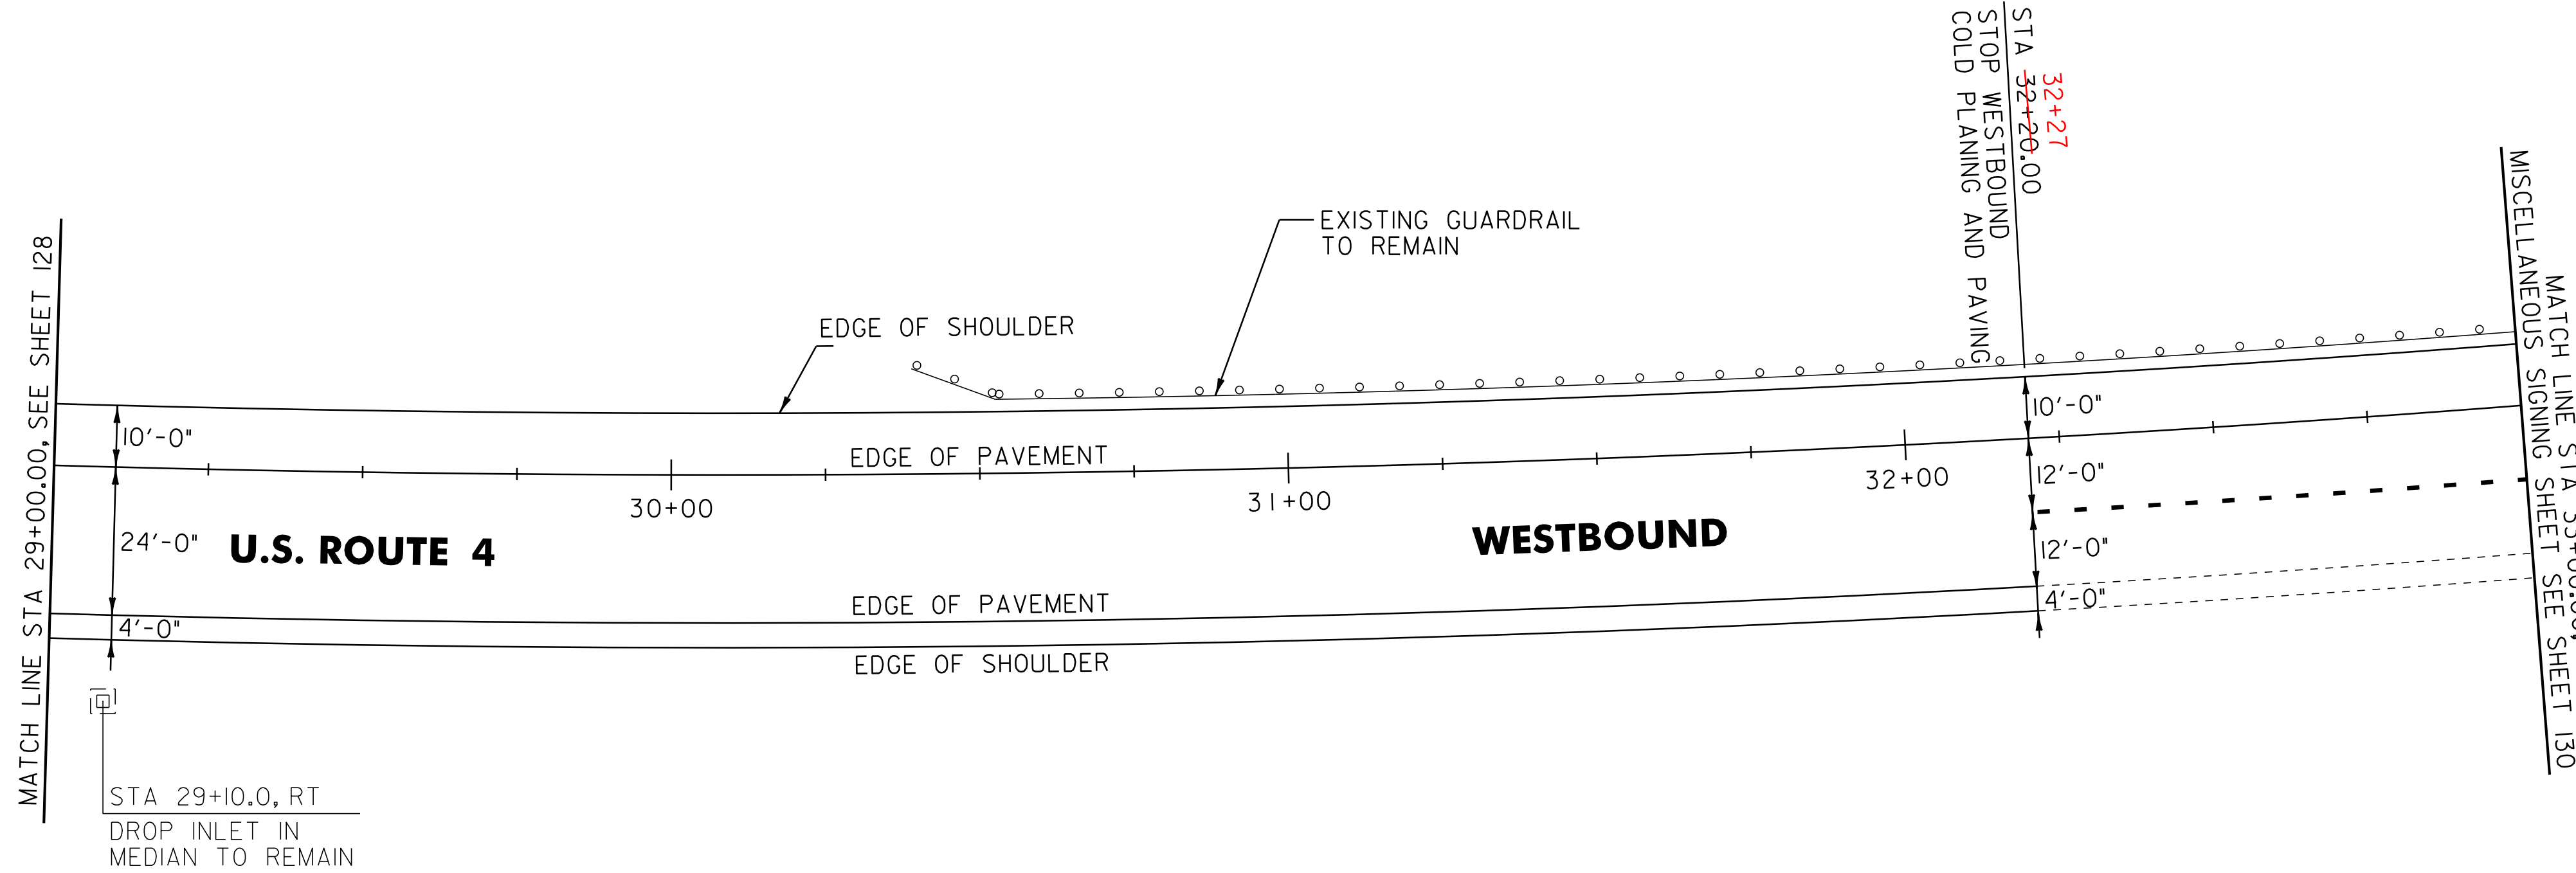

213.10 MILLED RUMBLE STRIPS

U.S. ROUTE 4 WESTBOUND:
STA 29+00.0 - STA ~~32+20.0~~ LT (320.0 LF) 32+27
STA 29+00.0 - STA ~~32+20.0~~ RT (320.0 LF) 32+27

SIGN LEGEND
 R = REMOVE
 S = SALVAGE
 N = NEW
 RET = RETAIN
 B-B = BACK TO BACK
 EXISTING = - - - - -
 NEW = _____

NOT TO SCALE

PROJECT LAYOUT SHEET #6

PROJECT NAME: FAIR HAVEN	PLOT DATE: 22-FEB-2012 12:5
PROJECT NUMBER: NH HES 020-K21)	DRAWN BY: C.A.K.
FILE NAME: 08b234.dgn	CHECKED BY: D.E.G.
DESIGNED BY: M.J.M.	SHEET 129 OF 157
DWG. NO. 08b234106.i	