

646.492 DURABLE LETTER OR SYMBOL, THERMOPLASTIC

FAIR HAVEN:  
STA 102+15.0 LT, "S,C,H,O,O,L" (6 EA) (SEE NOTE 3)

646.692 TEMPORARY LETTER OR SYMBOL, PAINT


FAIR HAVEN:  
STA 102+15.0 LT, "S,C,H,O,O,L" (12 EA) (SEE NOTE 3)

675.50 REMOVING SIGNS

AS SHOWN - 5

675.60 ERECTING SALVAGED SIGNS

AS SHOWN - 1

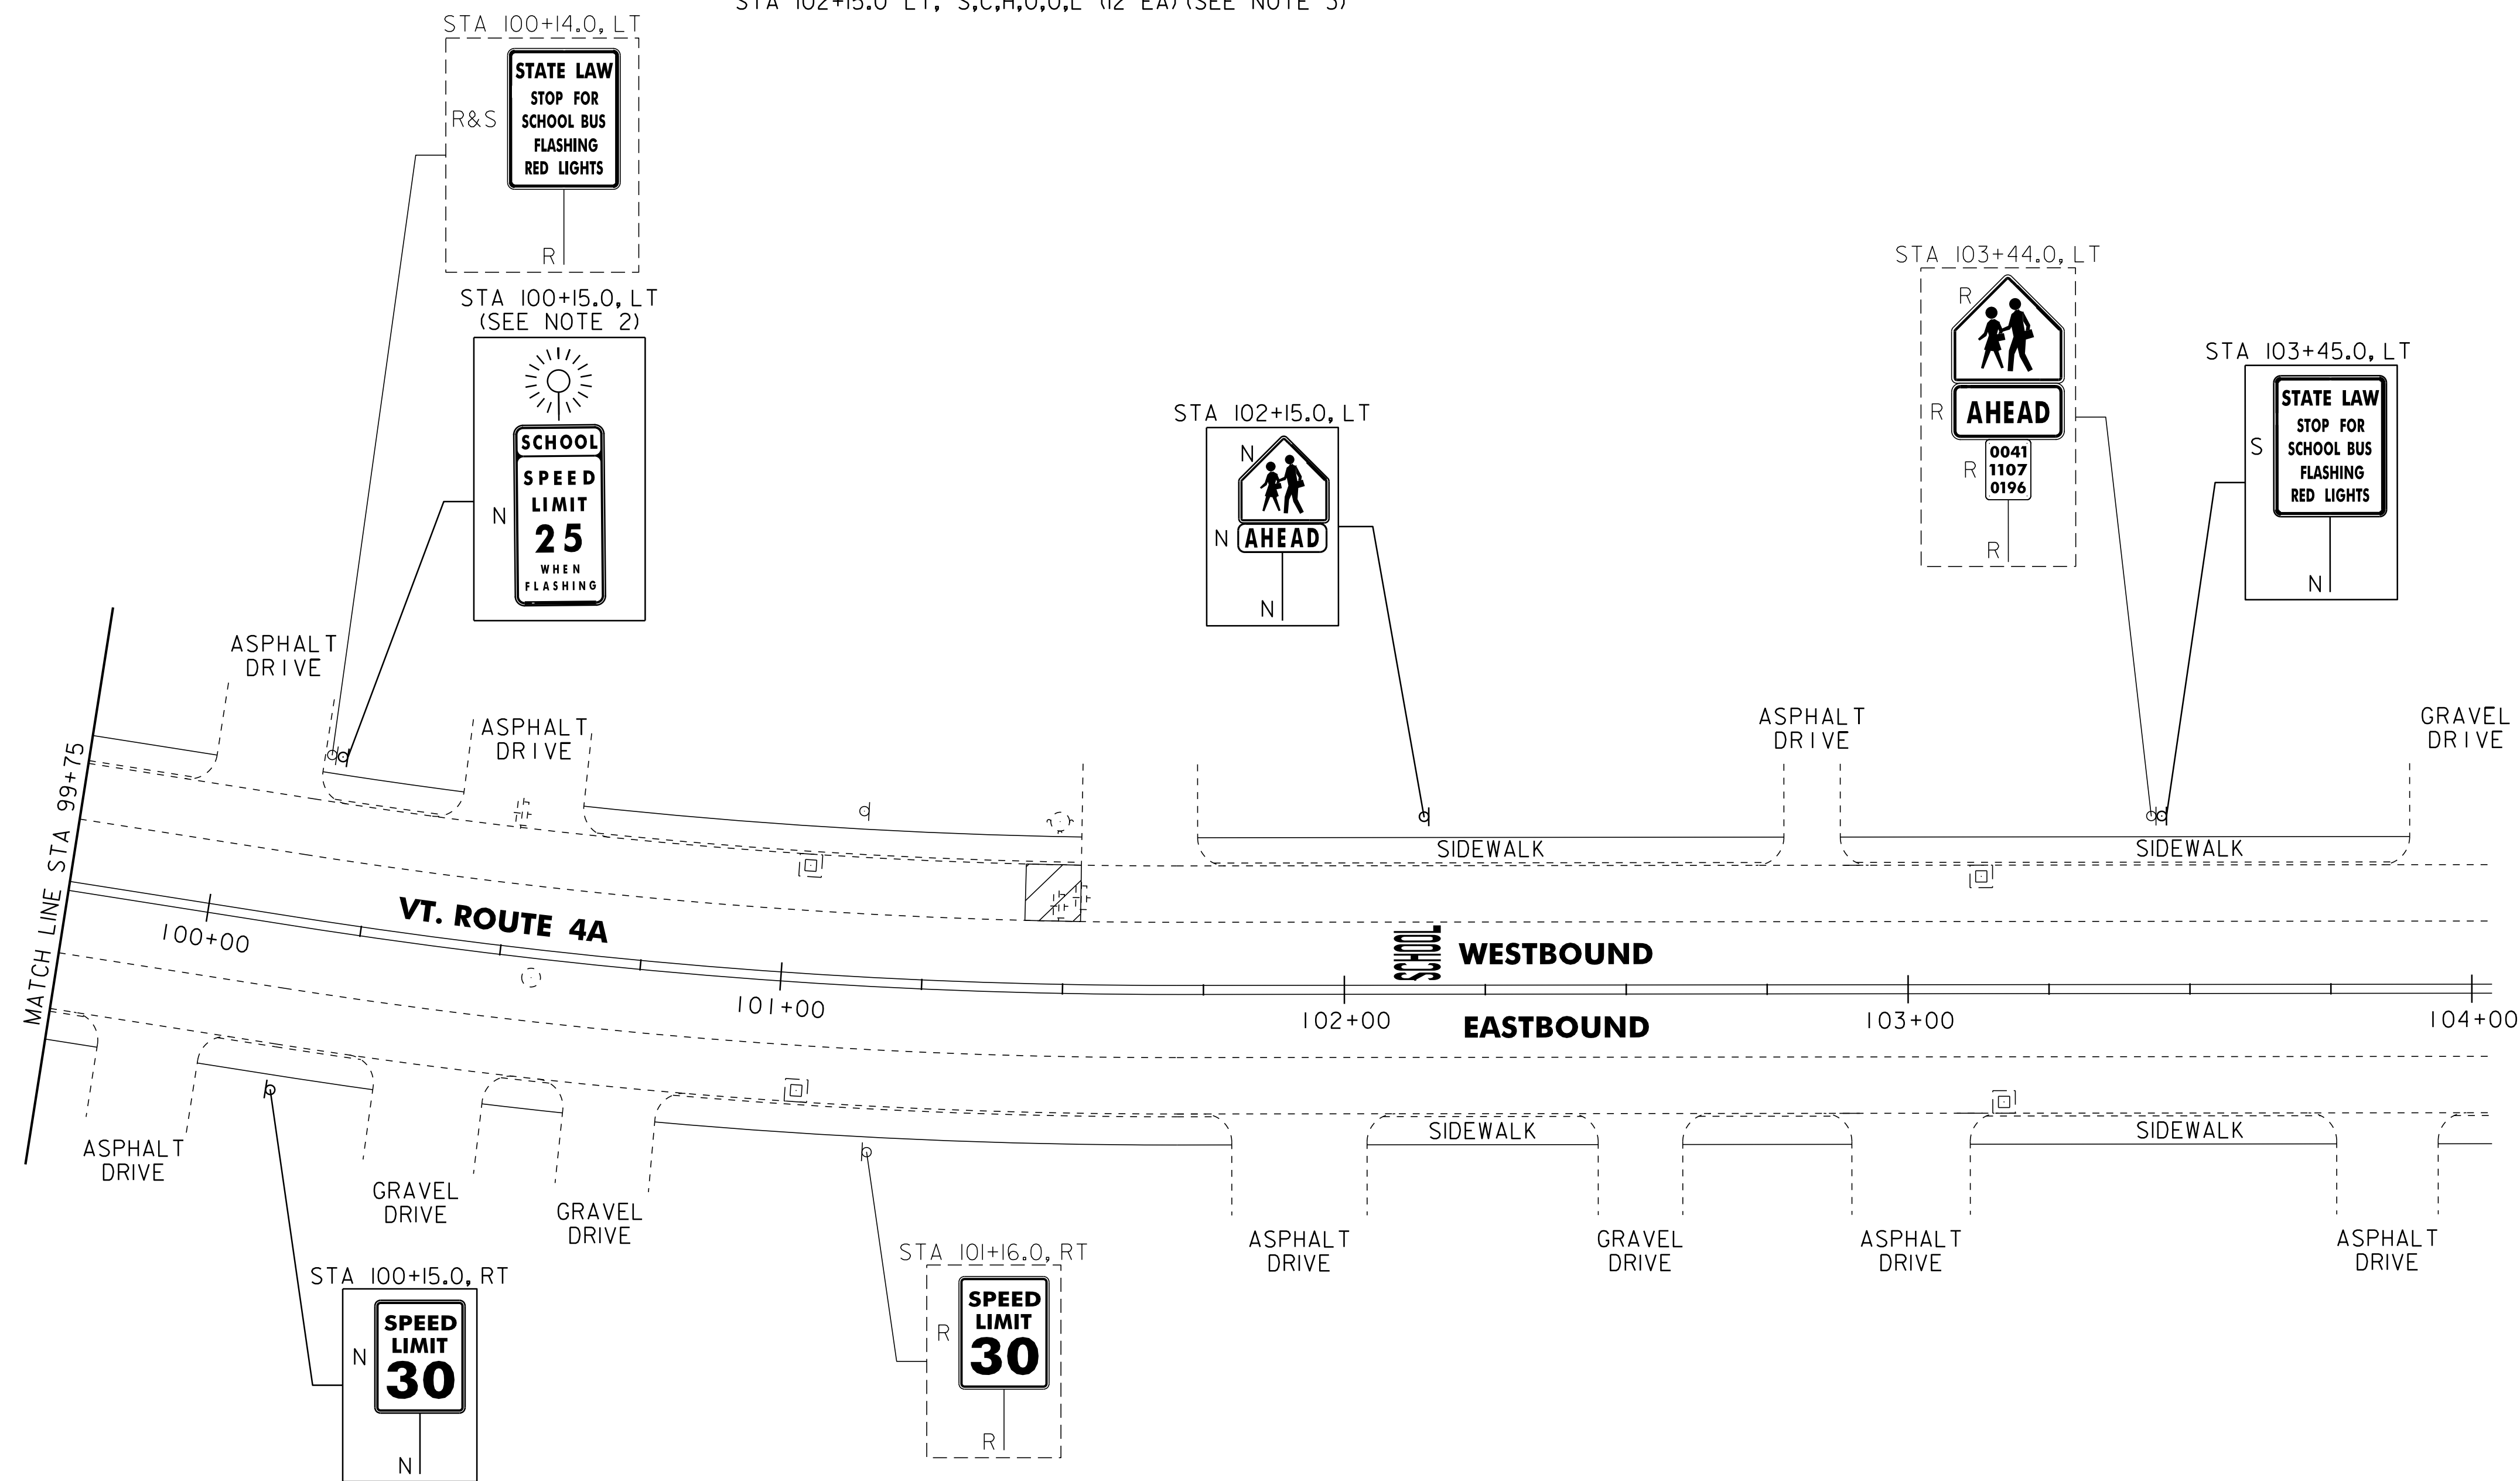

NOTES:

1. INSTALLED UNDER THE STP 2615(I)S FAIR HAVEN CLASS I PROJECT AS DIRECTED BY THE RESIDENT ENGINEER. SEE SHEETS 98 THRU 99 FOR ADDITIONAL INFORMATION.
2. INSTALLED UNDER THE STP 2615(I)S FAIR HAVEN CLASS I SOLAR-POWERED SCHOOL ZONE FLASHING BEACON SHALL BE USED IN CONJUNCTION WITH "SCHOOL SPEED LIMIT 25 WHEN FLASHING" SIGN. ALL WORK ASSOCIATED WITH THE INSTALLATION OF THE SOLAR-POWERED SCHOOL FLASHING BEACON WILL BE PAID FOR UNDER ITEM 900.620 SPECIAL PROVISION (SOLAR POWERED SCHOOL ZONE FLASHING BEACON) AS DIRECTED BY THE RESIDENT ENGINEER. SEE SHEET 157 FOR SOLAR POWERED SCHOOL ZONE FLASHING BEACON DETAILS.
3. ALL PAVEMENT MARKINGS SHALL BE PLACED IN CONJUNCTION WITH THE STP 2615(I)S PROJECT AS DIRECTED BY THE RESIDENT ENGINEER.
4. FOR CLARITY, NOT ALL OF THE EXISTING AND PROPOSED HAVE BEEN SHOWN ON THE PROJECT LAYOUT SHEETS.

SIGN LEGEND  
 R = REMOVE  
 S = SALVAGE  
 N = NEW  
 RET = RETAIN  
 B-B = BACK TO BACK  
 EXISTING = - - - - -  
 NEW = \_\_\_\_\_

NOT TO SCALE

<b>PROJECT LAYOUT SHEET #2</b>	PROJECT NAME: FAIR HAVEN
	PROJECT NUMBER: STP SRIN (004)
	FILE NAME: p06c058.dgn
	IPARM FILE: p06c058.i
	PLOT DATE: 22-FEB-2012 12:58
	DRAWN BY: C.A.K.
	CHECKED BY: D.E.G.
	SHEET 152 OF 157

900.620 SPECIAL PROVISION (SOLAR-POWERED SCHOOL ZONE FLASHING BEACON)

FAIR HAVEN:  
STA 100+15.0 LT (1 EA)