


US 5 PEDESTAL WALL - ELEVATION

SCALE 3/16" = 1'-0"

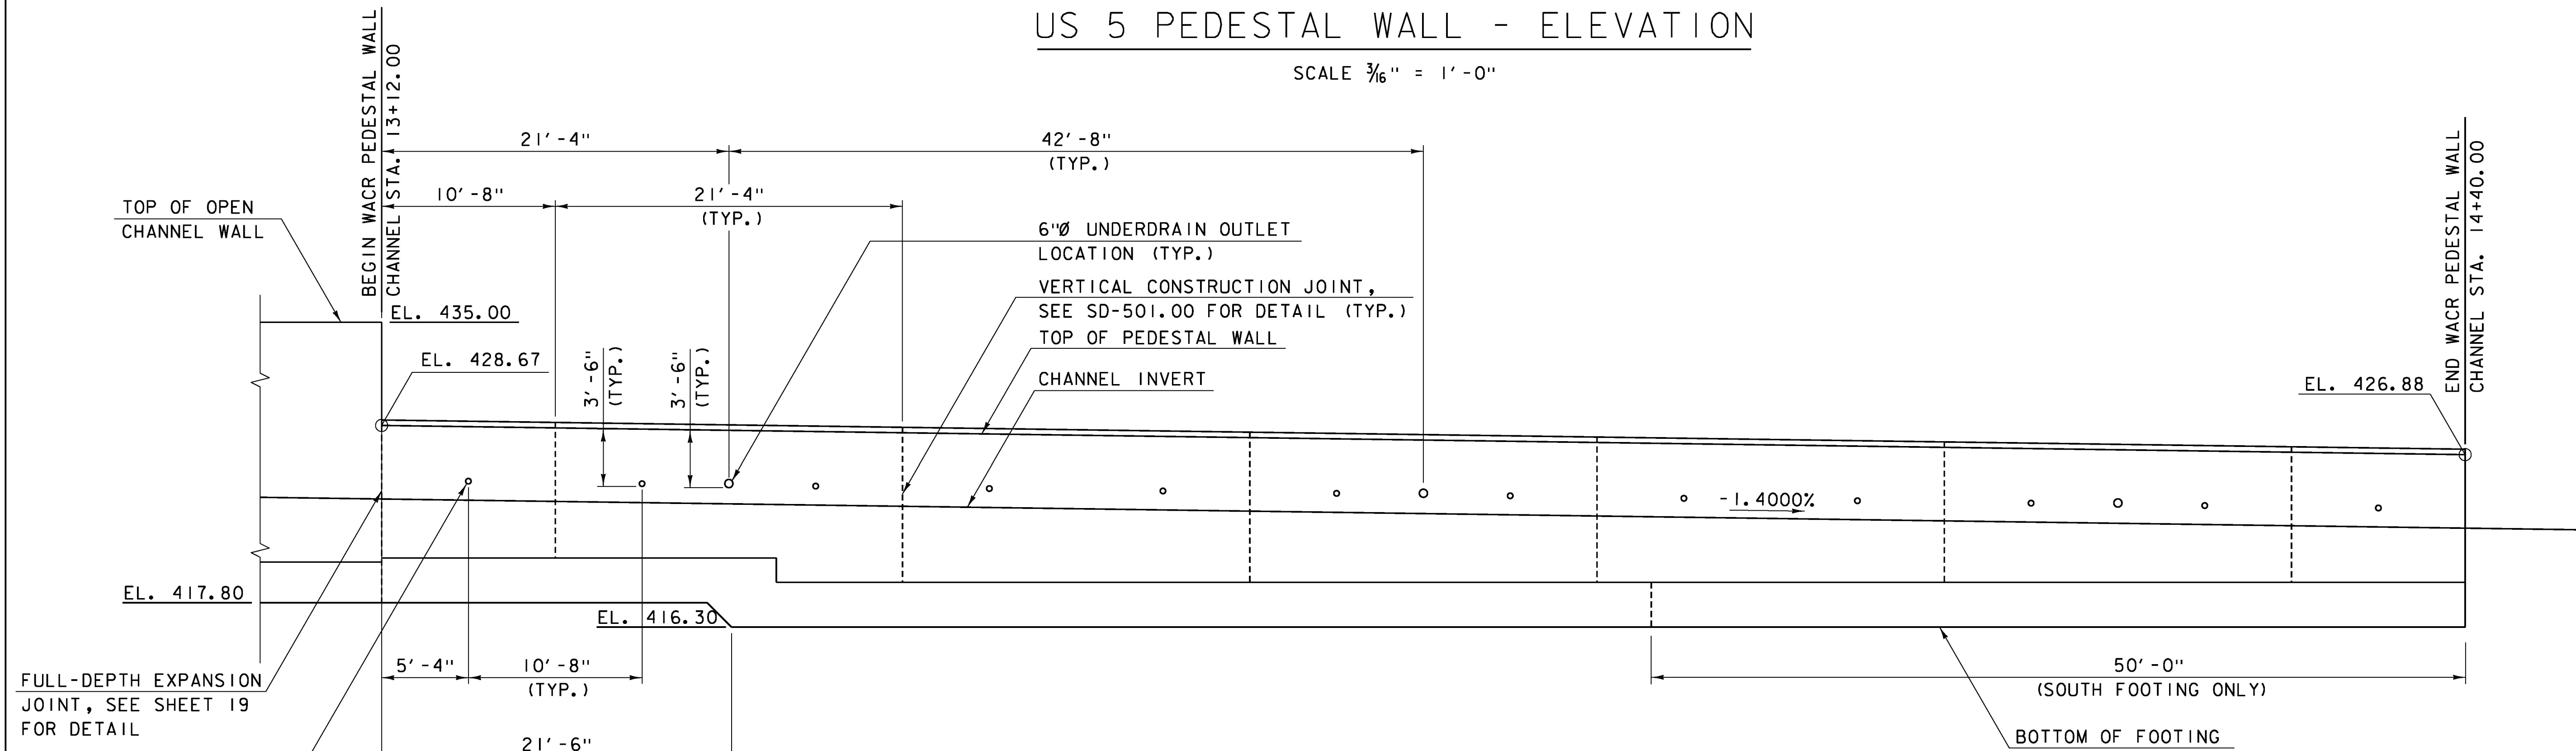

WACR PEDESTAL WALL - ELEVATION

SCALE 3/16" = 1'-0"

NOTE: ONE PEDESTAL WALL IS SHOWN FOR US 5 AND WACR, OPPOSING WALLS ARE THE MIRROR IMAGE.

PROJECT NAME:	RYEGATE
PROJECT NUMBER:	STP CULV(10)
FILE NAME:	z06cl56sup.dgn
PROJECT LEADER:	E. DETRICK
DESIGNED BY:	R. BARNES
PEDESTAL WALL ELEVATIONS	
PLOT DATE:	3/23/16
DRAWN BY:	R. BARNES
CHECKED BY:	E. DETRICK
SHEET	16 OF 36

