


US 5 PEDESTAL WALL REINFORCING - ELEVATION

SCALE 3/16" = 1'-0"

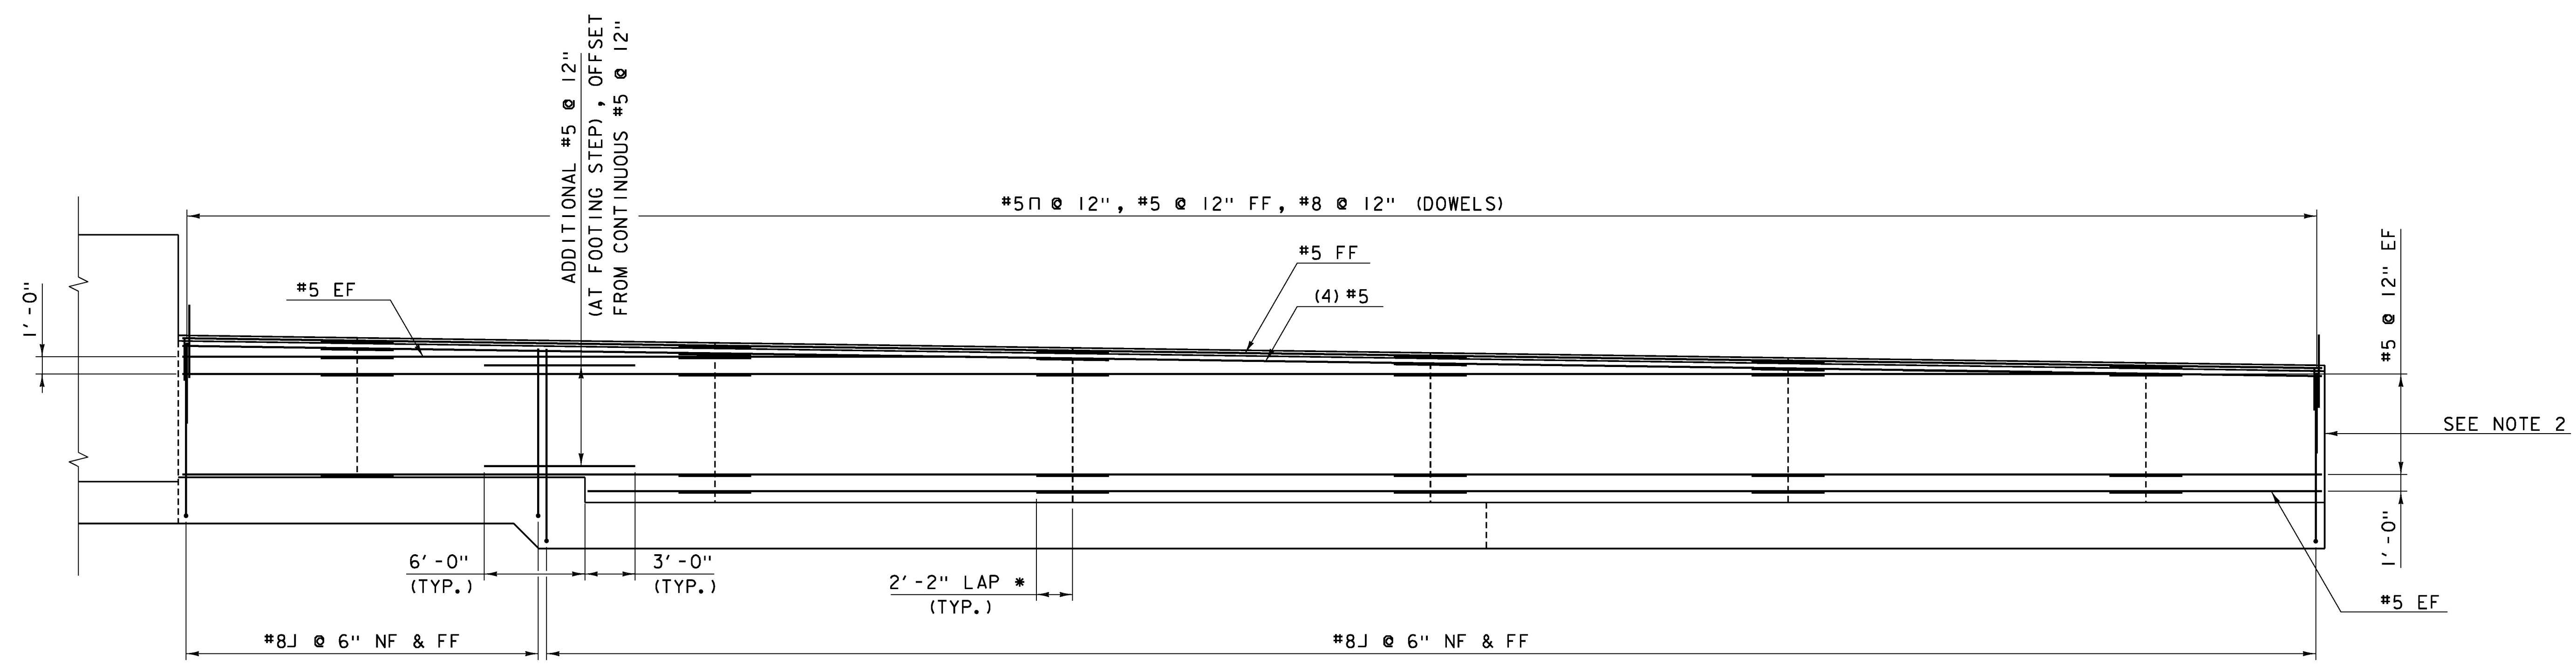

WACR PEDESTAL WALL REINFORCING - ELEVATION

SCALE 3/16" = 1'-0"

NOTE:
 NF = NEAR FACE
 FF = FAR FACE
 EF = EACH FACE
 ▲ = CUT TO FIT IN FIELD
 3" CLEAR, UNLESS OTHERWISE SPECIFIED ON THE PLANS.
 2'-2" BAR LAP UNLESS OTHERWISE SPECIFIED ON THE PLANS.

NOTES:
 1. ONE PEDESTAL WALL IS SHOWN FOR US 5 AND WACR, OPPOSING WALLS ARE THE MIRROR IMAGE.
 2. HW #1 AND HW #4 CONNECTION REINFORCING NOT SHOWN, SEE SHEETS 23 AND 29 FOR DETAILS.

* LAP WITH MECHANICAL BAR CONNECTOR DOWEL



PROJECT NAME: RYEGATE	PLOT DATE: 3/23/16
PROJECT NUMBER: STP CULV(10)	DRAWN BY: R. BARNES
FILE NAME: z06cl56sup.dgn	CHECKED BY: E. DETRICK
PROJECT LEADER: E. DETRICK	SHEET 17 OF 36
DESIGNED BY: R. BARNES	
PEDESTAL WALL REINFORCING	