


FLOW AND CHANNEL
LINE STATIONING
CHANNEL WALL #1 - FOOTING PLAN
SCALE 3/8" = 1'-0"

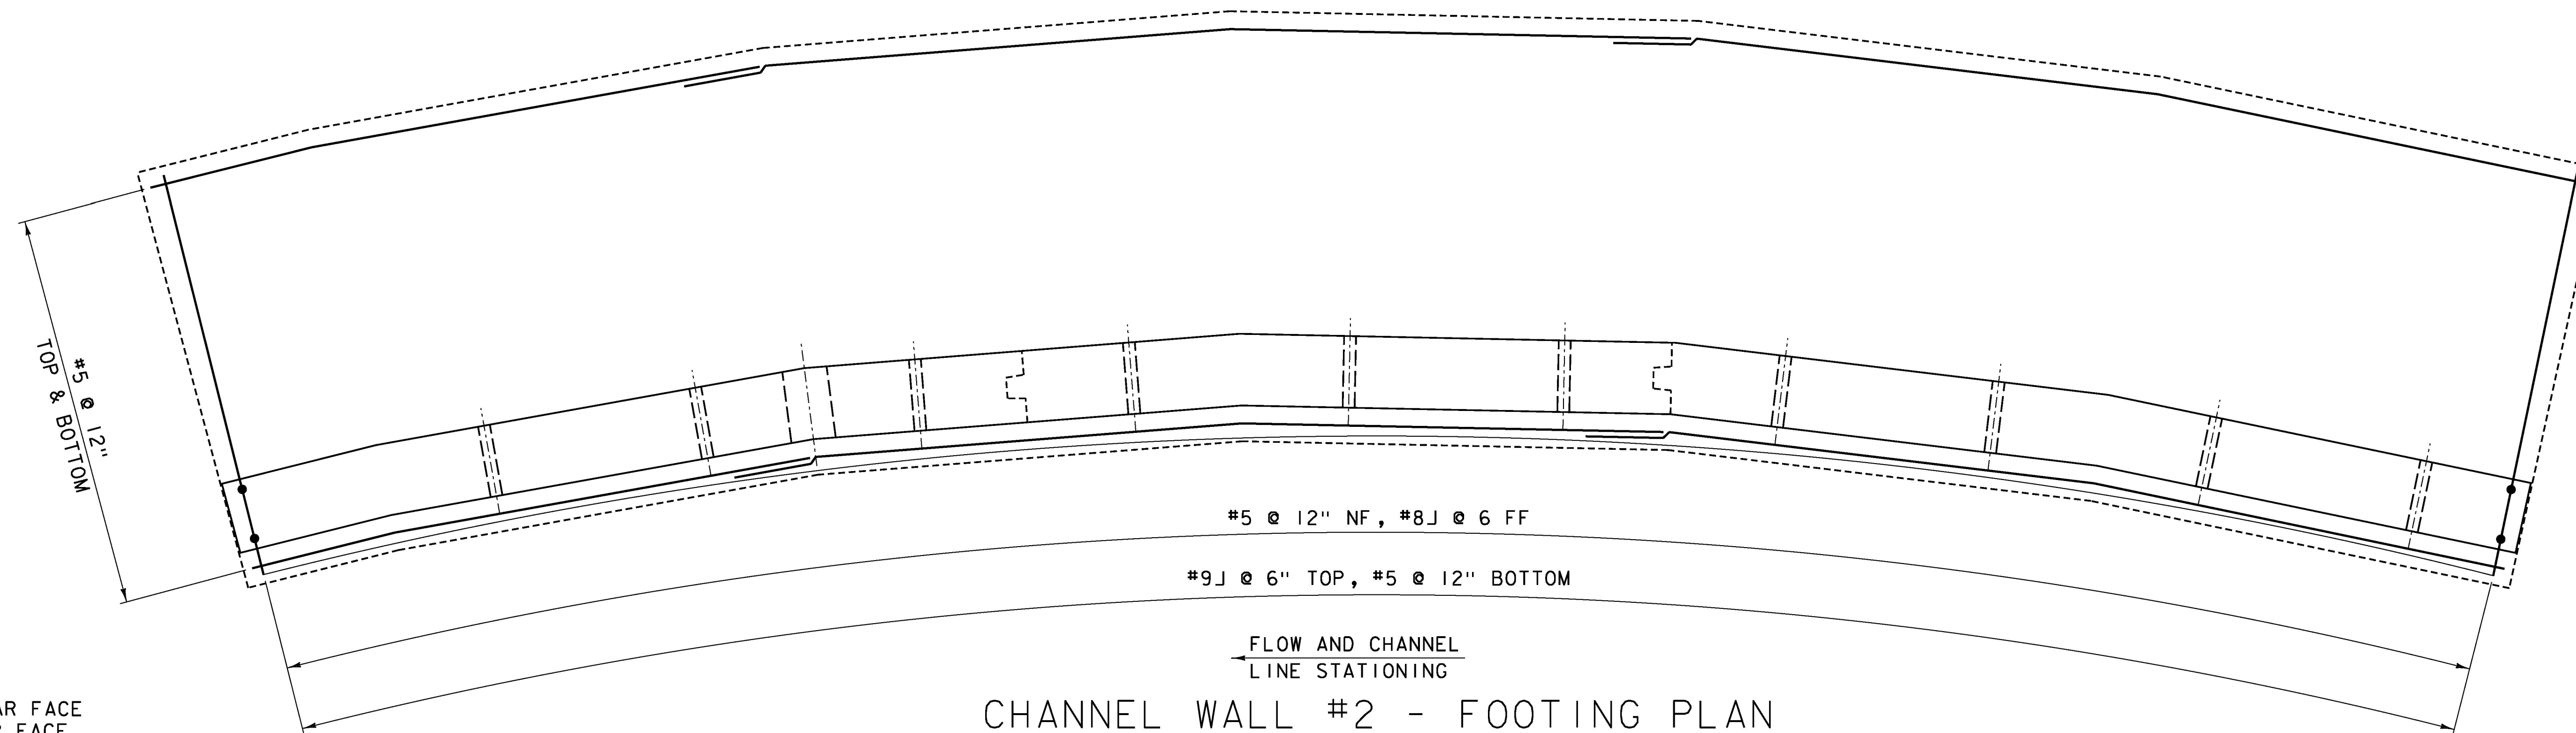

FLOW AND CHANNEL
LINE STATIONING
CHANNEL WALL #2 - FOOTING PLAN
SCALE 3/8" = 1'-0"

NOTE:

- NF = NEAR FACE
- FF = FAR FACE
- EF = EACH FACE
- ▲ = CUT TO FIT IN FIELD
- 3" CLEAR, UNLESS OTHERWISE SPECIFIED ON THE PLANS.
- 2'-2" BAR LAP UNLESS OTHERWISE SPECIFIED ON THE PLANS.

PROJECT NAME: RYEGATE	PLOT DATE: 3/23/16
PROJECT NUMBER: STP CULV(10)	DRAWN BY: R. BARNES
FILE NAME: z06cl56chwallfoot.dgn	CHECKED BY: E. DETRICK
DESIGNED BY: P. BERO	SHEET 21 OF 36
CHANNEL WALL FOOTING REINFORCING PLAN	

