


WACR INLET - PLAN
SCALE 1/4" = 1'-0"

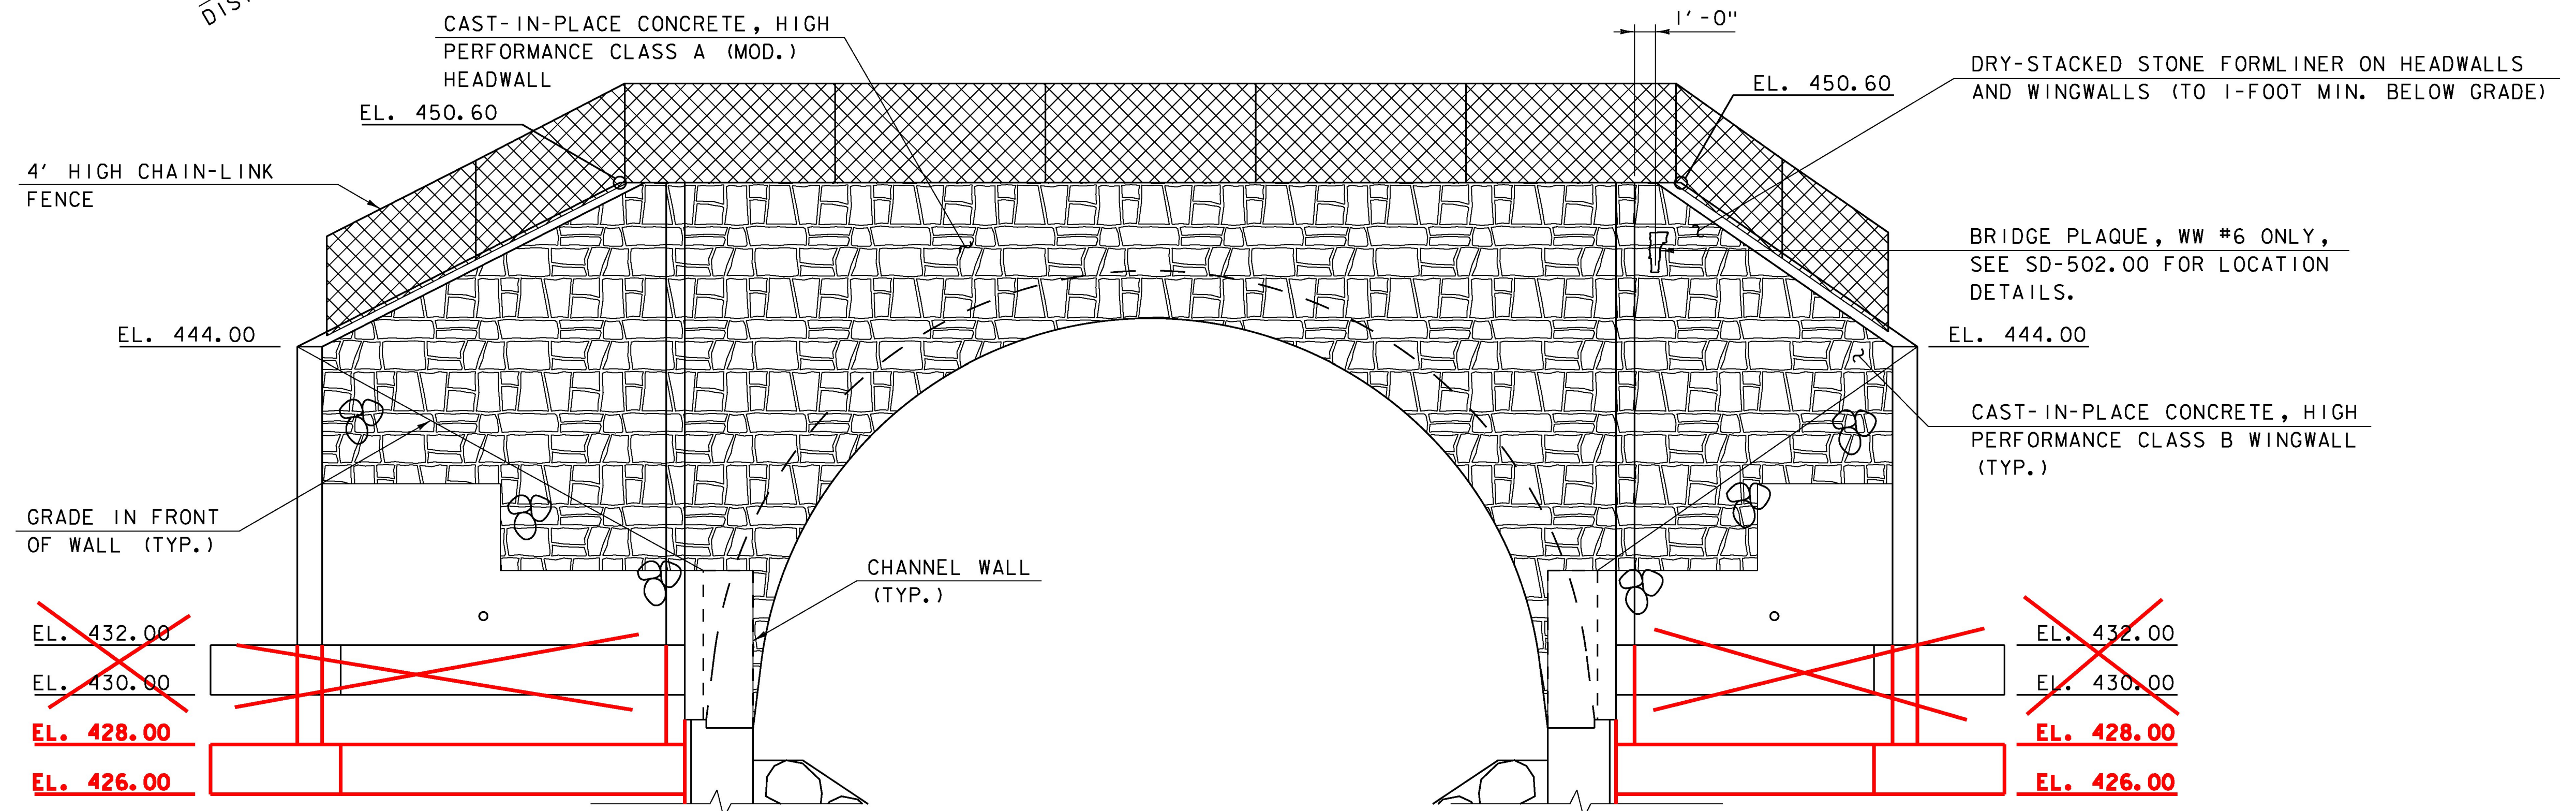

WACR INLET - ELEVATION
SCALE 1/4" = 1'-0"

NOTE: SEE SHEET 24 FOR SECTION A-A.

* POST SPACING MEASURED ALONG HORIZONTAL. POST SPACING INDICATED IS TYPICAL ALONG WINGWALL SLOPES AND HEADWALL, AS SHOWN.

| | |
|-------------------------------|------------------|
| PROJECT NAME: | RYEGATE |
| PROJECT NUMBER: | STP CULV(10) |
| FILE NAME: | z06cl56bSUB4.dgn |
| PROJECT LEADER: | E. DETRICK |
| DESIGNED BY: | R. BARNES |
| WACR INLET PLAN AND ELEVATION | |
| PLOT DATE: | 11/24/2015 |
| DRAWN BY: | R. BARNES |
| CHECKED BY: | E. DETRICK |
| SHEET | 26 OF 56 |

