


WACR OUTLET - PLAN
SCALE 1/4" = 1'-0"

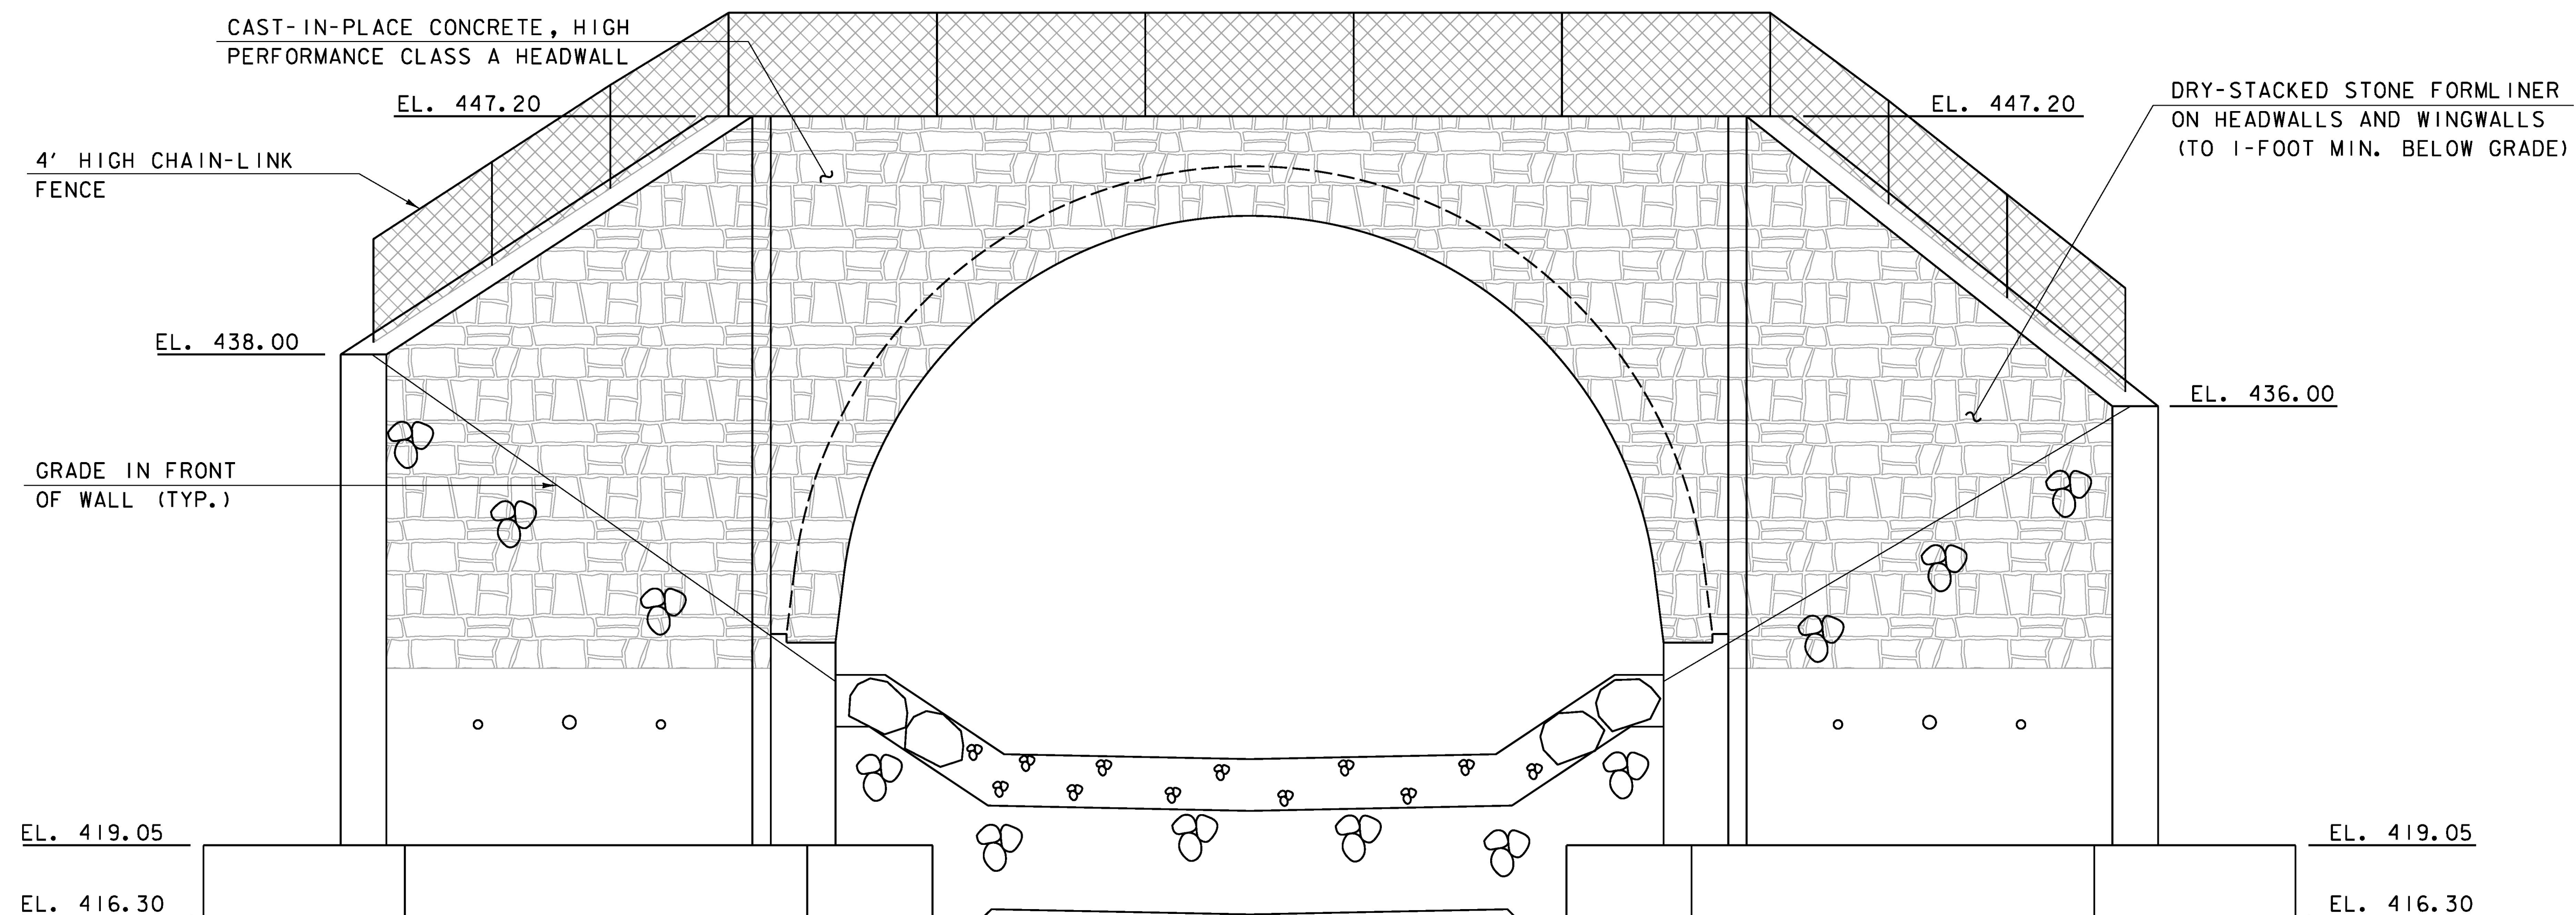

WACR OUTLET - ELEVATION
SCALE 1/4" = 1'-0"

NOTE: SEE SHEET 22 FOR SECTION A-A.

* POST SPACING MEASURED ALONG HORIZONTAL.
POST SPACING INDICATED IS TYPICAL ALONG
WINGWALL SLOPES, AS SHOWN.



PROJECT NAME: RYEGATE
PROJECT NUMBER: STP CULV(10)

FILE NAME: z06cl56sub4.dgn
PROJECT LEADER: E. DETRICK
DESIGNED BY: R. BARNES
WACR OUTLET PLAN AND ELEVATION

PLOT DATE: 3/23/16
DRAWN BY: R. BARNES
CHECKED BY: E. DETRICK
SHEET 28 OF 36