



10+25

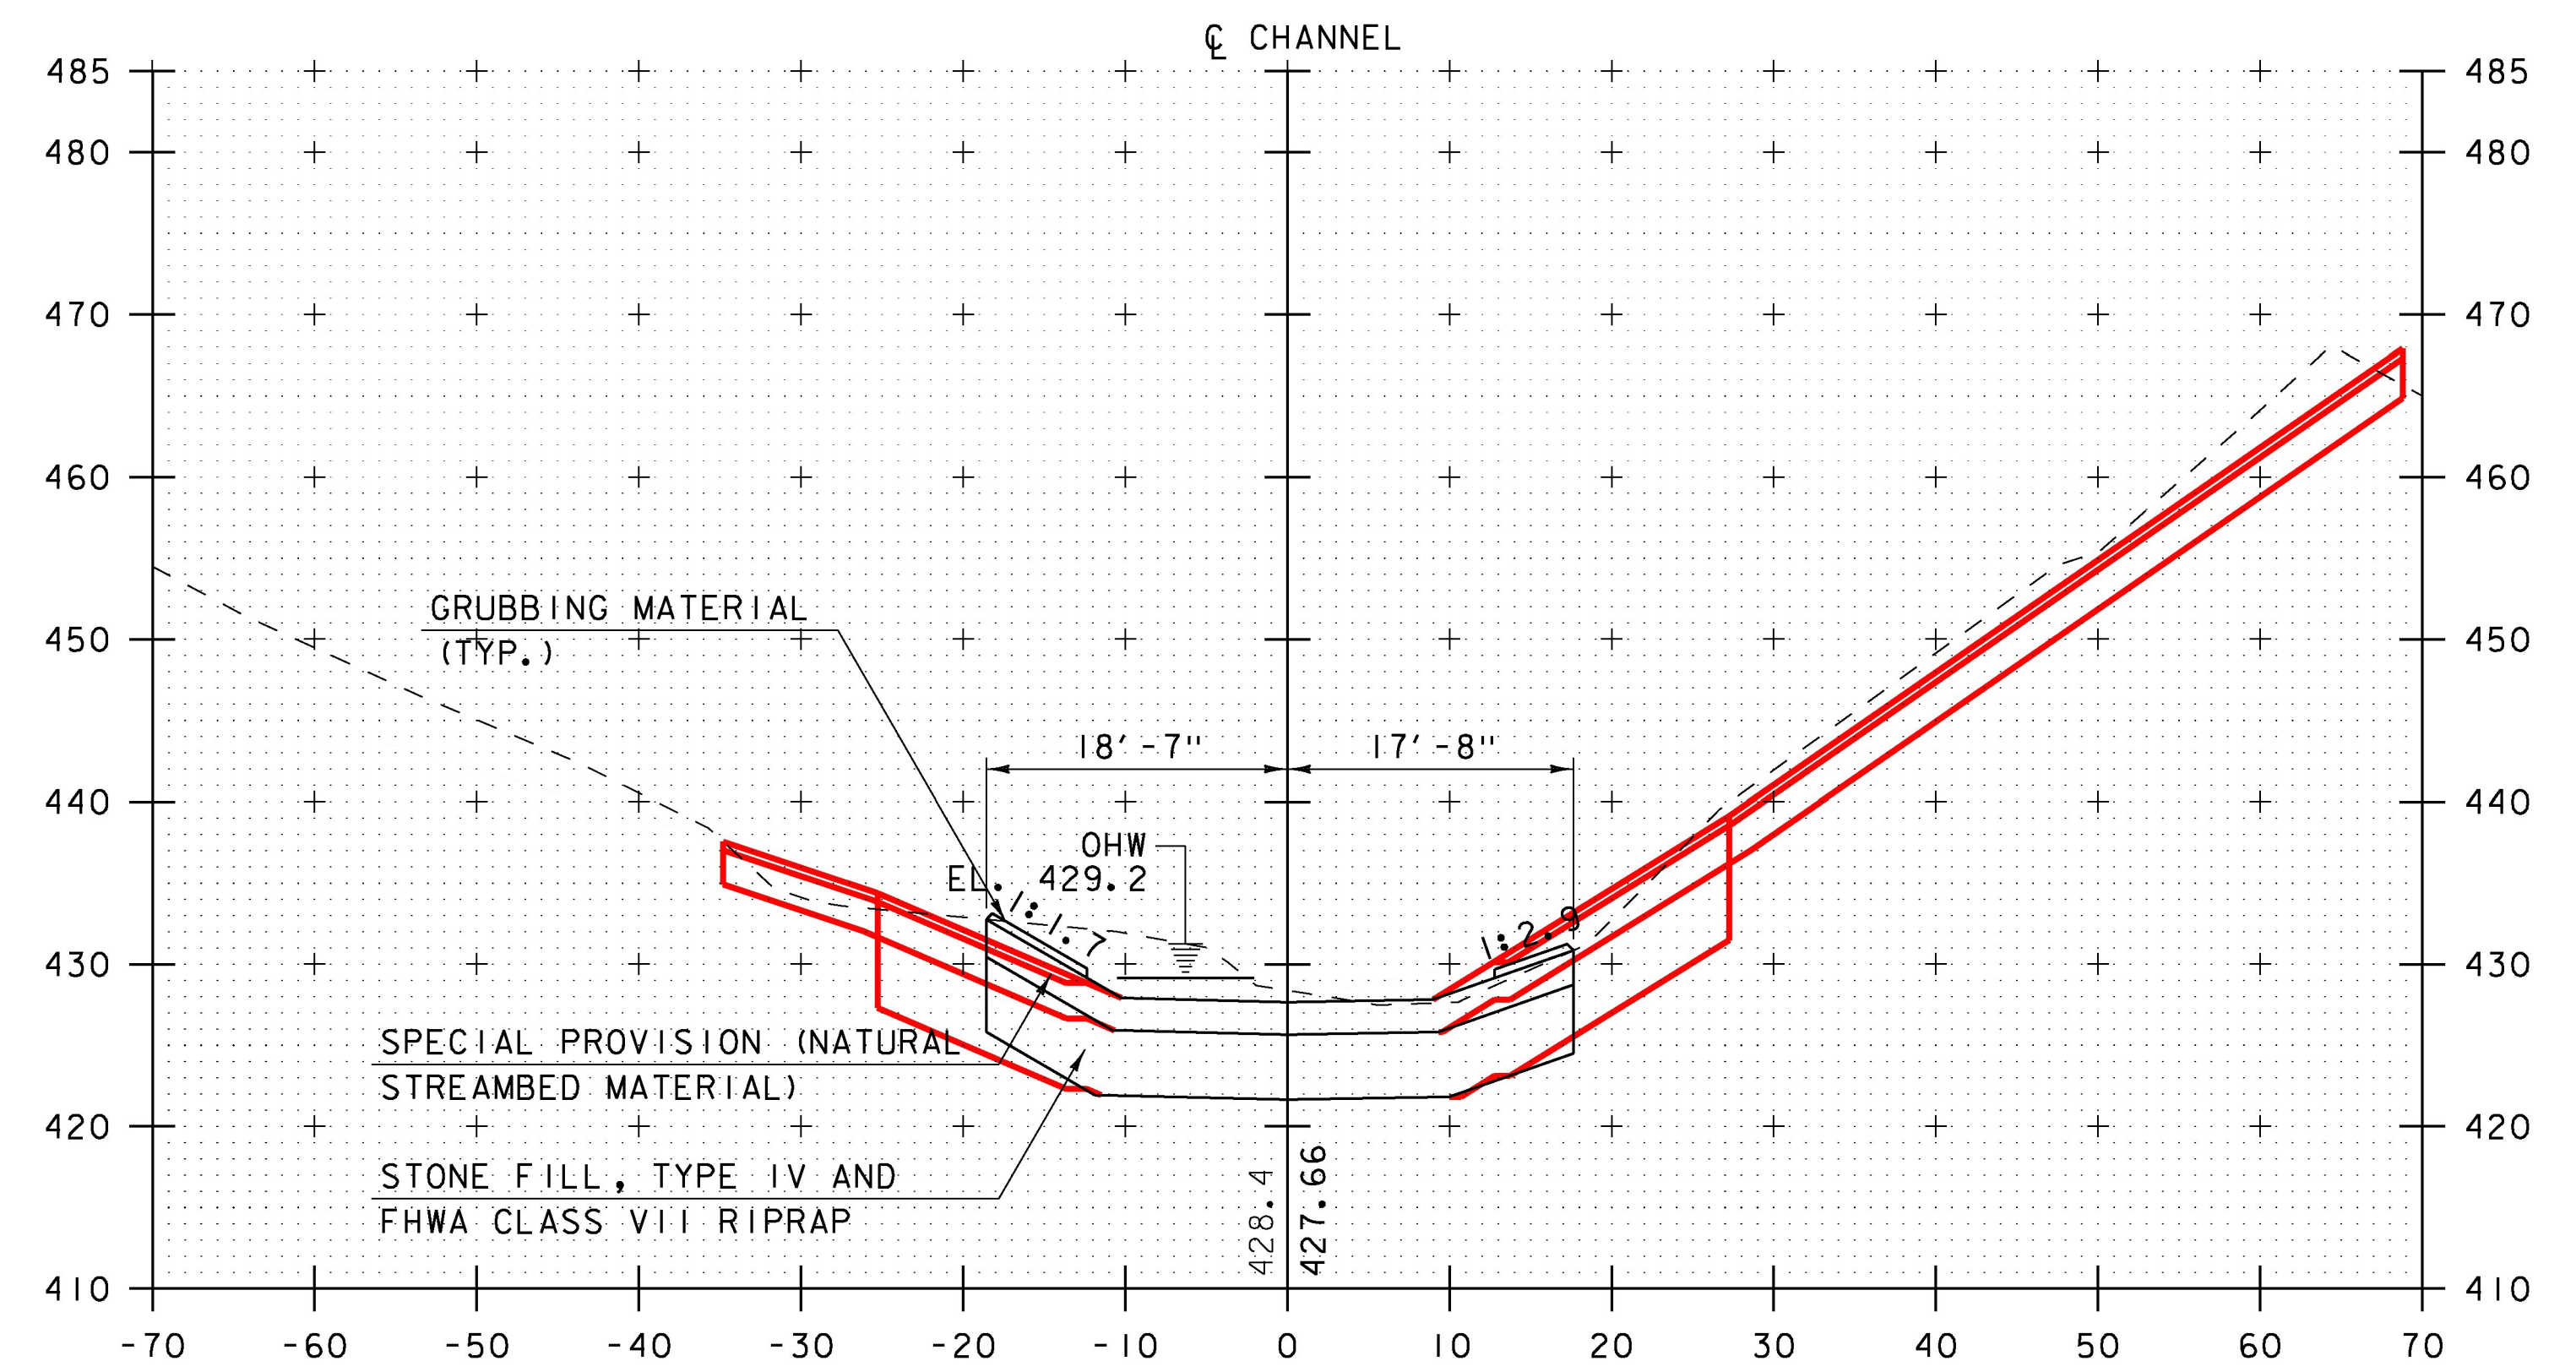

STA. ~~10+60-00~~ 10+00
 BEGIN STONE FILL, TYPE IV AND FHWA CLASS VII RIPRAP
 BEGIN NATIVE CHANNEL MATERIAL
 BEGIN GRUBBING MATERIAL

10+75

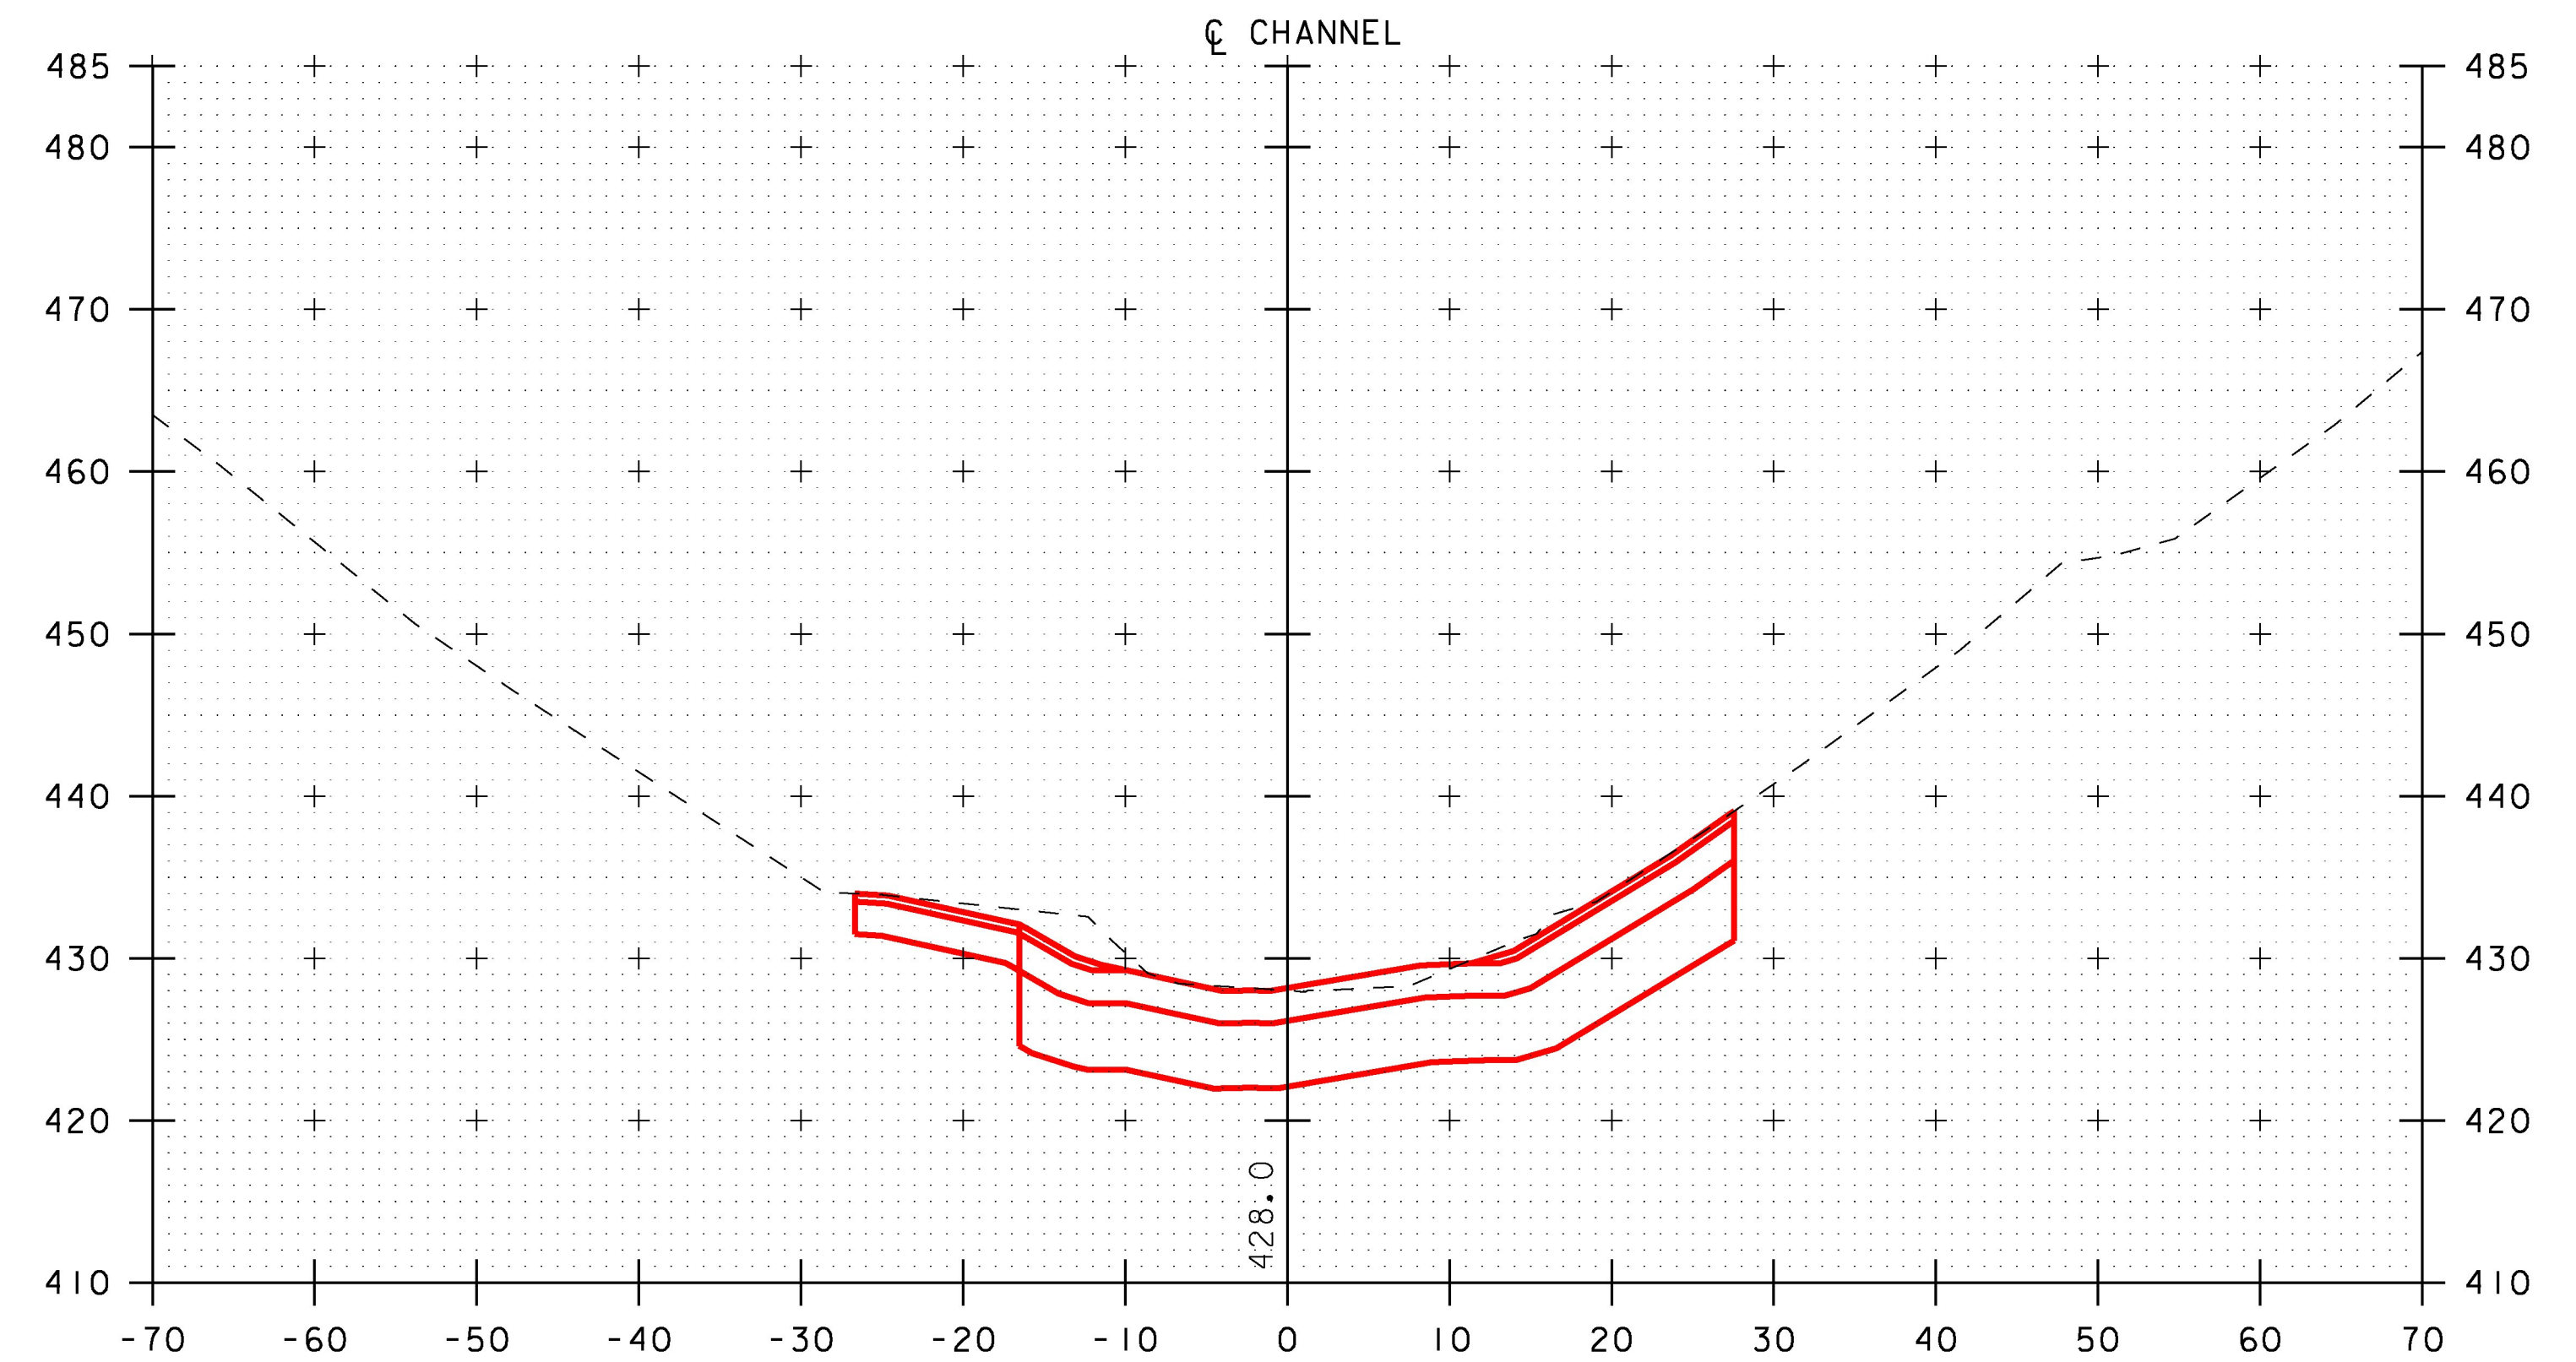

10+50

NOTE: CHANNEL CROSS-SECTION SHOWN REFLECTS GENERAL CHANNEL GEOMETRY, IT WILL NOT BE A SMOOTHLY GRADED SURFACE AS SHOWN, SEE CHANNEL MATERIAL NOTES, SHEET 3.

SCALE 1" = 10'-0"
 10 0 10



PROJECT NAME: RYEGATE	PLOT DATE: 11/24/2015
PROJECT NUMBER: STP CULV(10)	DRAWN BY: R. BARNES
FILE NAME: z06cl56chxs.dgn	CHECKED BY: E. DETRICK
PROJECT LEADER: E. DETRICK	SHEET 31 OF 56
DESIGNED BY: R. BARNES	
CHANNEL CROSS SECTIONS 1 OF 6	