


ACCESS ROAD 1 CURVE (1) DELTA = 45°00'00" D = 95°29'35" R = 60.00' T = 24.85' L = 47.12' E = 4.94'	ACCESS ROAD 1 CURVE (2) DELTA = 19°57'40" D = 38°11'50" R = 150.00' T = 26.40' L = 52.26' E = 2.30'	ACCESS ROAD 1 CURVE (3) DELTA = 24°56'58" D = 71°37'11" R = 80.00' T = 17.70' L = 34.84' E = 1.93'	ACCESS ROAD 1 CURVE (4) DELTA = 67°54'38" D = 143°14'22" R = 40.00' T = 26.93' L = 47.41' E = 8.22'
---	--	---	--

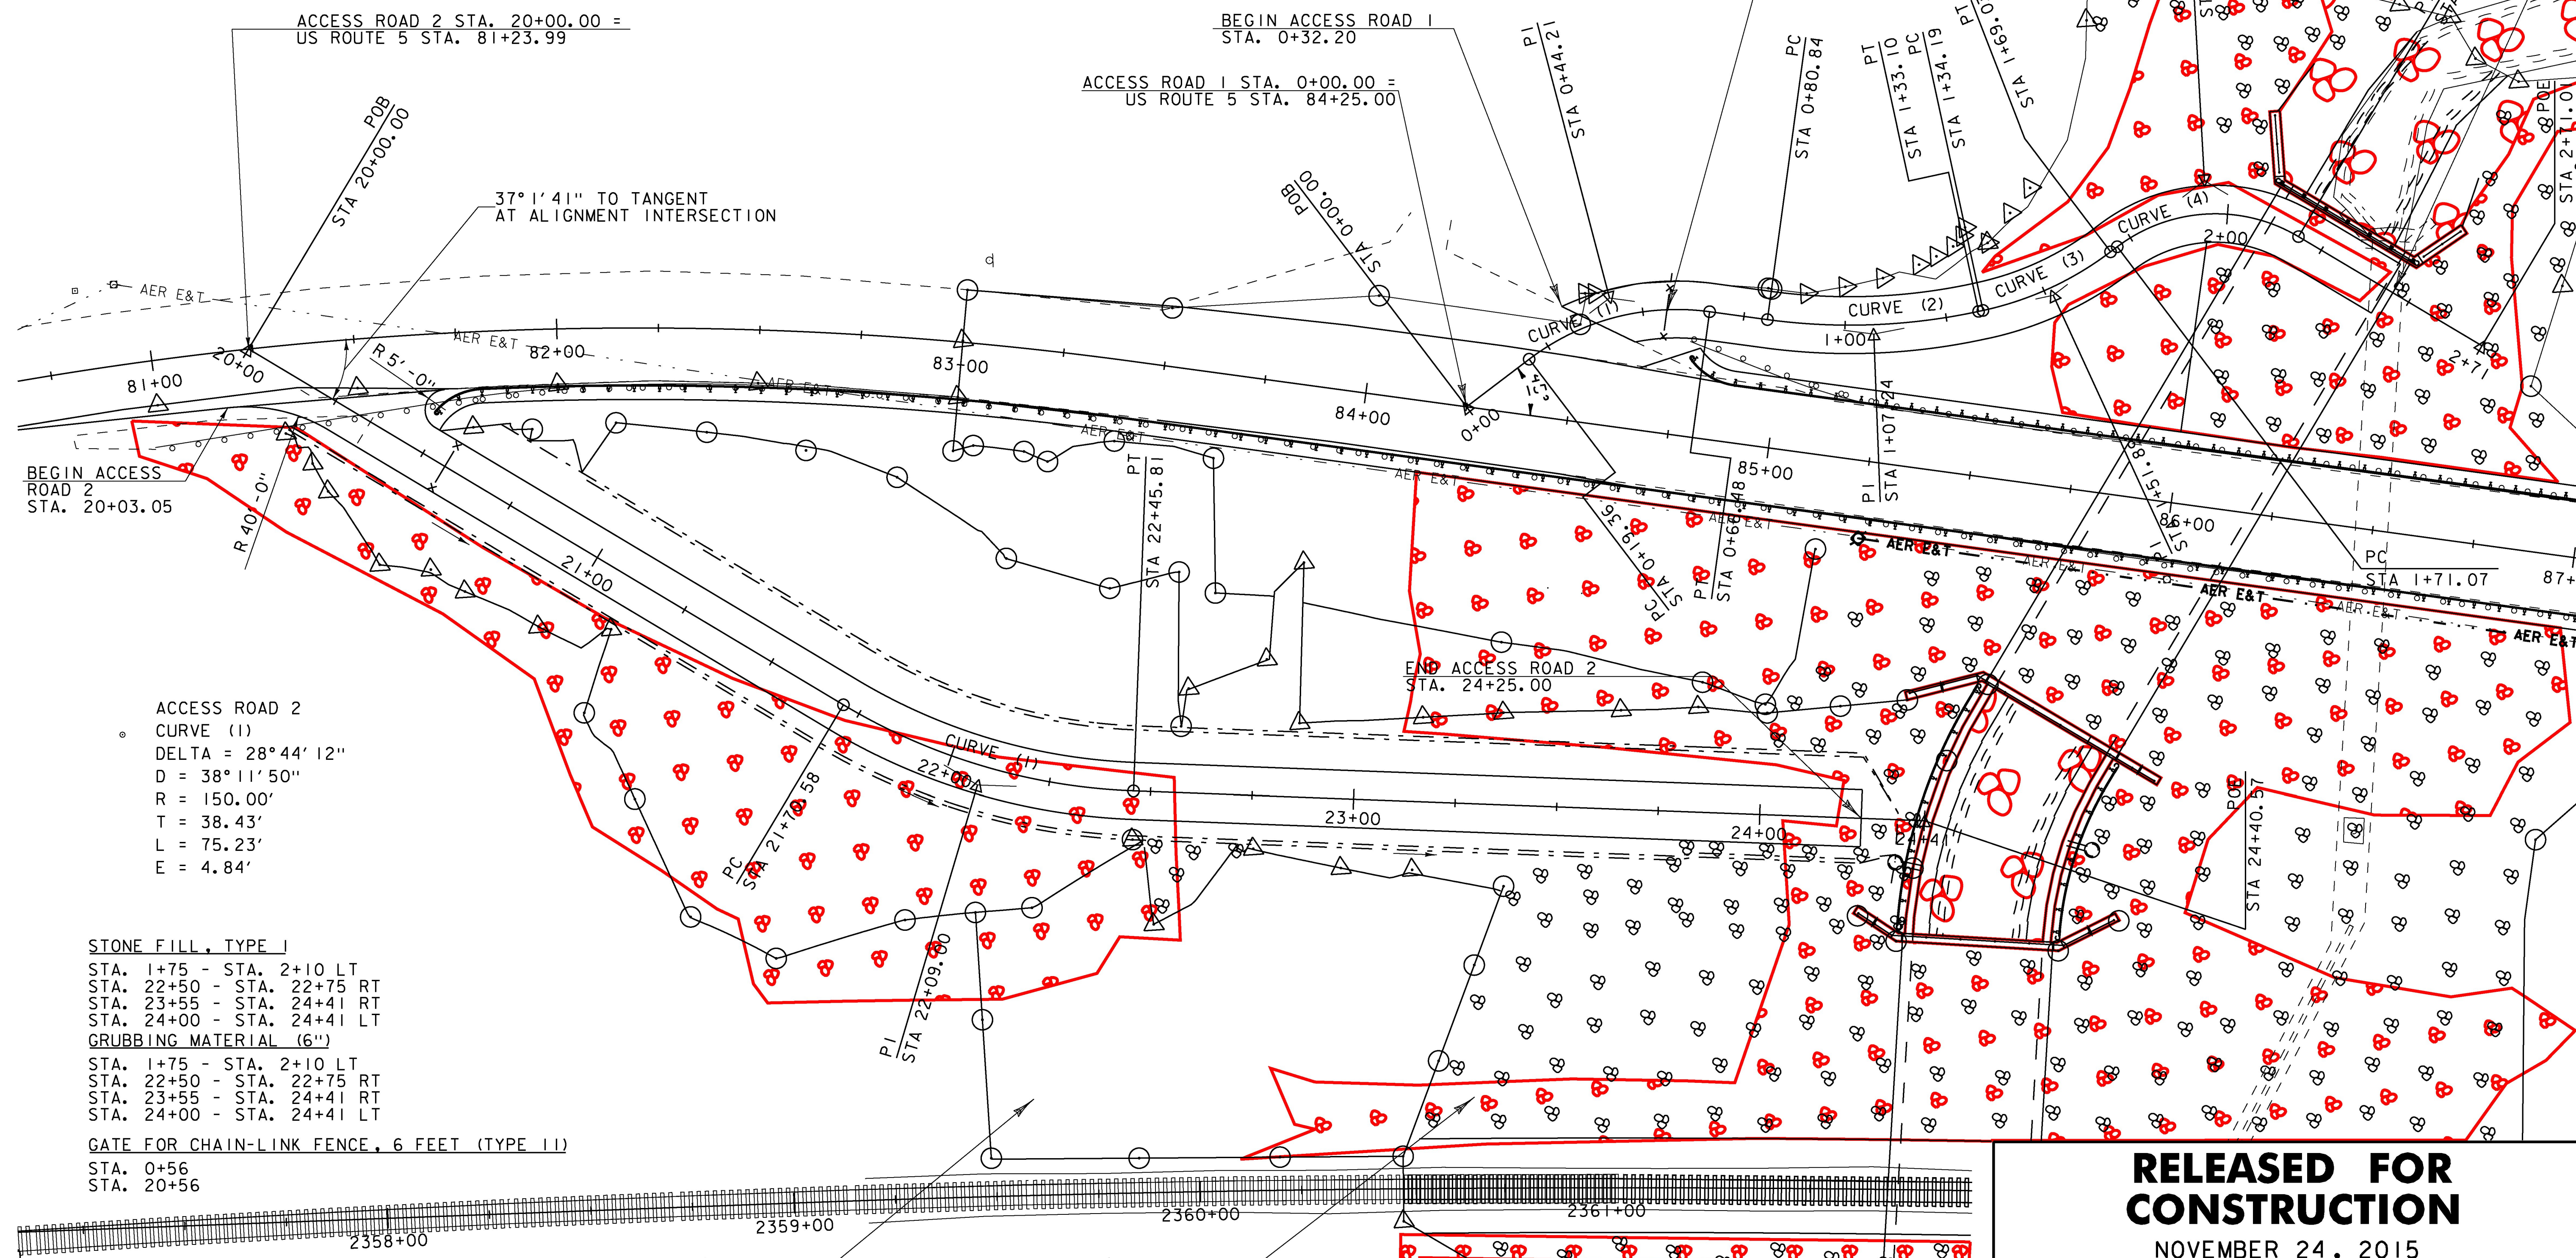


ACCESS ROAD 2  
CURVE (1)  
DELTA = 28°44'12"  
D = 38°11'50"  
R = 150.00'  
T = 38.43'  
L = 75.23'  
E = 4.84'

STONE FILL, TYPE I  
STA. 1+75 - STA. 2+10 LT  
STA. 22+50 - STA. 22+75 RT  
STA. 23+55 - STA. 24+41 RT  
STA. 24+00 - STA. 24+41 LT  
GRUBBING MATERIAL (6")  
STA. 1+75 - STA. 2+10 LT  
STA. 22+50 - STA. 22+75 RT  
STA. 23+55 - STA. 24+41 RT  
STA. 24+00 - STA. 24+41 LT

GATE FOR CHAIN-LINK FENCE, 6 FEET (TYPE 11)  
STA. 0+56  
STA. 20+56

TOPSOIL, SEED, FERTILIZE, LIME AND INSTALL PERMANENT EROSION CONTROL MATTING IN AREAS THAT HAVE BEEN CLEARED BUT NOT GRUBBED. STUMPS ARE TO BE REMOVED, OR CUT/GROUND TO BE FLUSH WITH OR BELOW FINISHED GRADE.

INSTALL 1 FOOT THICK TYPE I STONE AND 6" GRUBBING MATERIAL IN AREAS THAT HAVE BEEN CLEARED AND GRUBBED

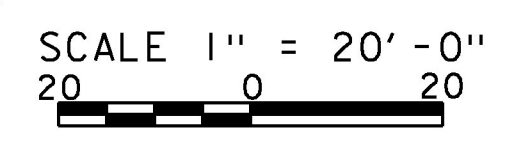

**RELEASED FOR CONSTRUCTION**  
NOVEMBER 24, 2015

PROJECT NAME: RYEGATE  
PROJECT NUMBER: STP CULV(10)

FILE NAME: z06cl56bdr\_acc.dgn  
PROJECT LEADER: E. DETRICK  
DESIGNED BY: B. BRESLEND  
ACCESS ROADS LAYOUT SHEET

PLOT DATE: 11/24/2015  
DRAWN BY: B. BRESLEND  
CHECKED BY: E. DETRICK  
SHEET 10 OF 56

