


ACCESS ROAD 1 PROFILE

THE GRADES SHOWN TO THE TENTH ARE THE EXISTING GROUND ELEVATIONS ALONG THE NEW ALIGNMENT. THE GRADES SHOWN TO THE NEAREST HUNDREDTH ARE THE PROPOSED GRADES FOR THE NEW ALIGNMENT.

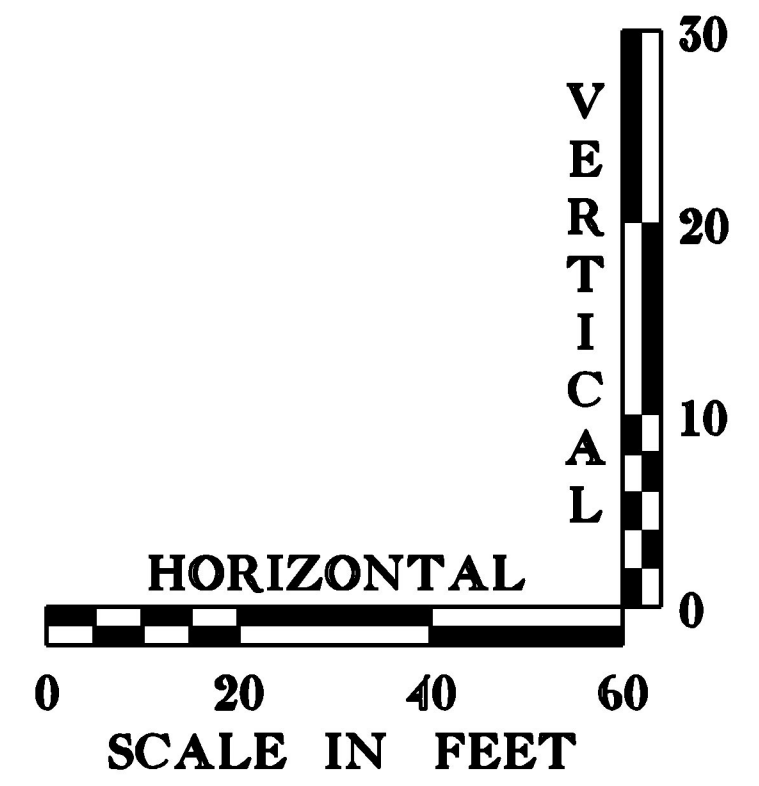

**RELEASED FOR CONSTRUCTION**  
 NOVEMBER 24, 2015

PROJECT NAME: RYEGATE	PLOT DATE: 11/24/2015
PROJECT NUMBER: STP CULV(10)	DRAWN BY: B. BRESLEND
FILE NAME: z06cl56pro_accl.dgn	CHECKED BY: E. DETRICK
DESIGNED BY: B. BRESLEND	ACCESS ROAD 1 PROFILE SHEET
	SHEET 11 OF 29

