


ACCESS ROAD 2 PROFILE

THE GRADES SHOWN TO THE TENTH ARE THE EXISTING GROUND ELEVATIONS ALONG THE NEW ALIGNMENT. THE GRADES SHOWN TO THE NEAREST HUNDREDTH ARE THE PROPOSED GRADES ALONG THE NEW ALIGNMENT.

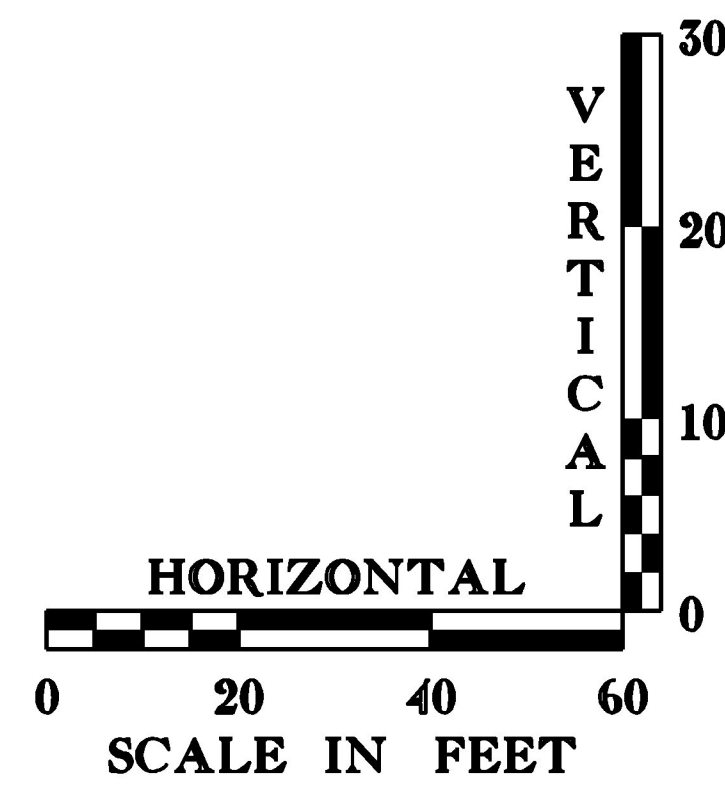

RELEASED FOR CONSTRUCTION	
NOVEMBER 24, 2015	
PROJECT NAME:	RYEGATE
PROJECT NUMBER:	STP CULV(10)
FILE NAME:	z06ci56pro_acc2.dgn
PROJECT LEADER:	E. DETRICK
DESIGNED BY:	B. BRESLEND
CHECKED BY:	E. DETRICK
ACCESS ROAD 2 PROFILE SHEET	PLOT DATE: 11/24/2015
	DRAWN BY: B. BRESLEND
	CHECKED BY: E. DETRICK
	SHEET 12 OF 29