




BEGIN APPROACH  
STA. 83+00.00

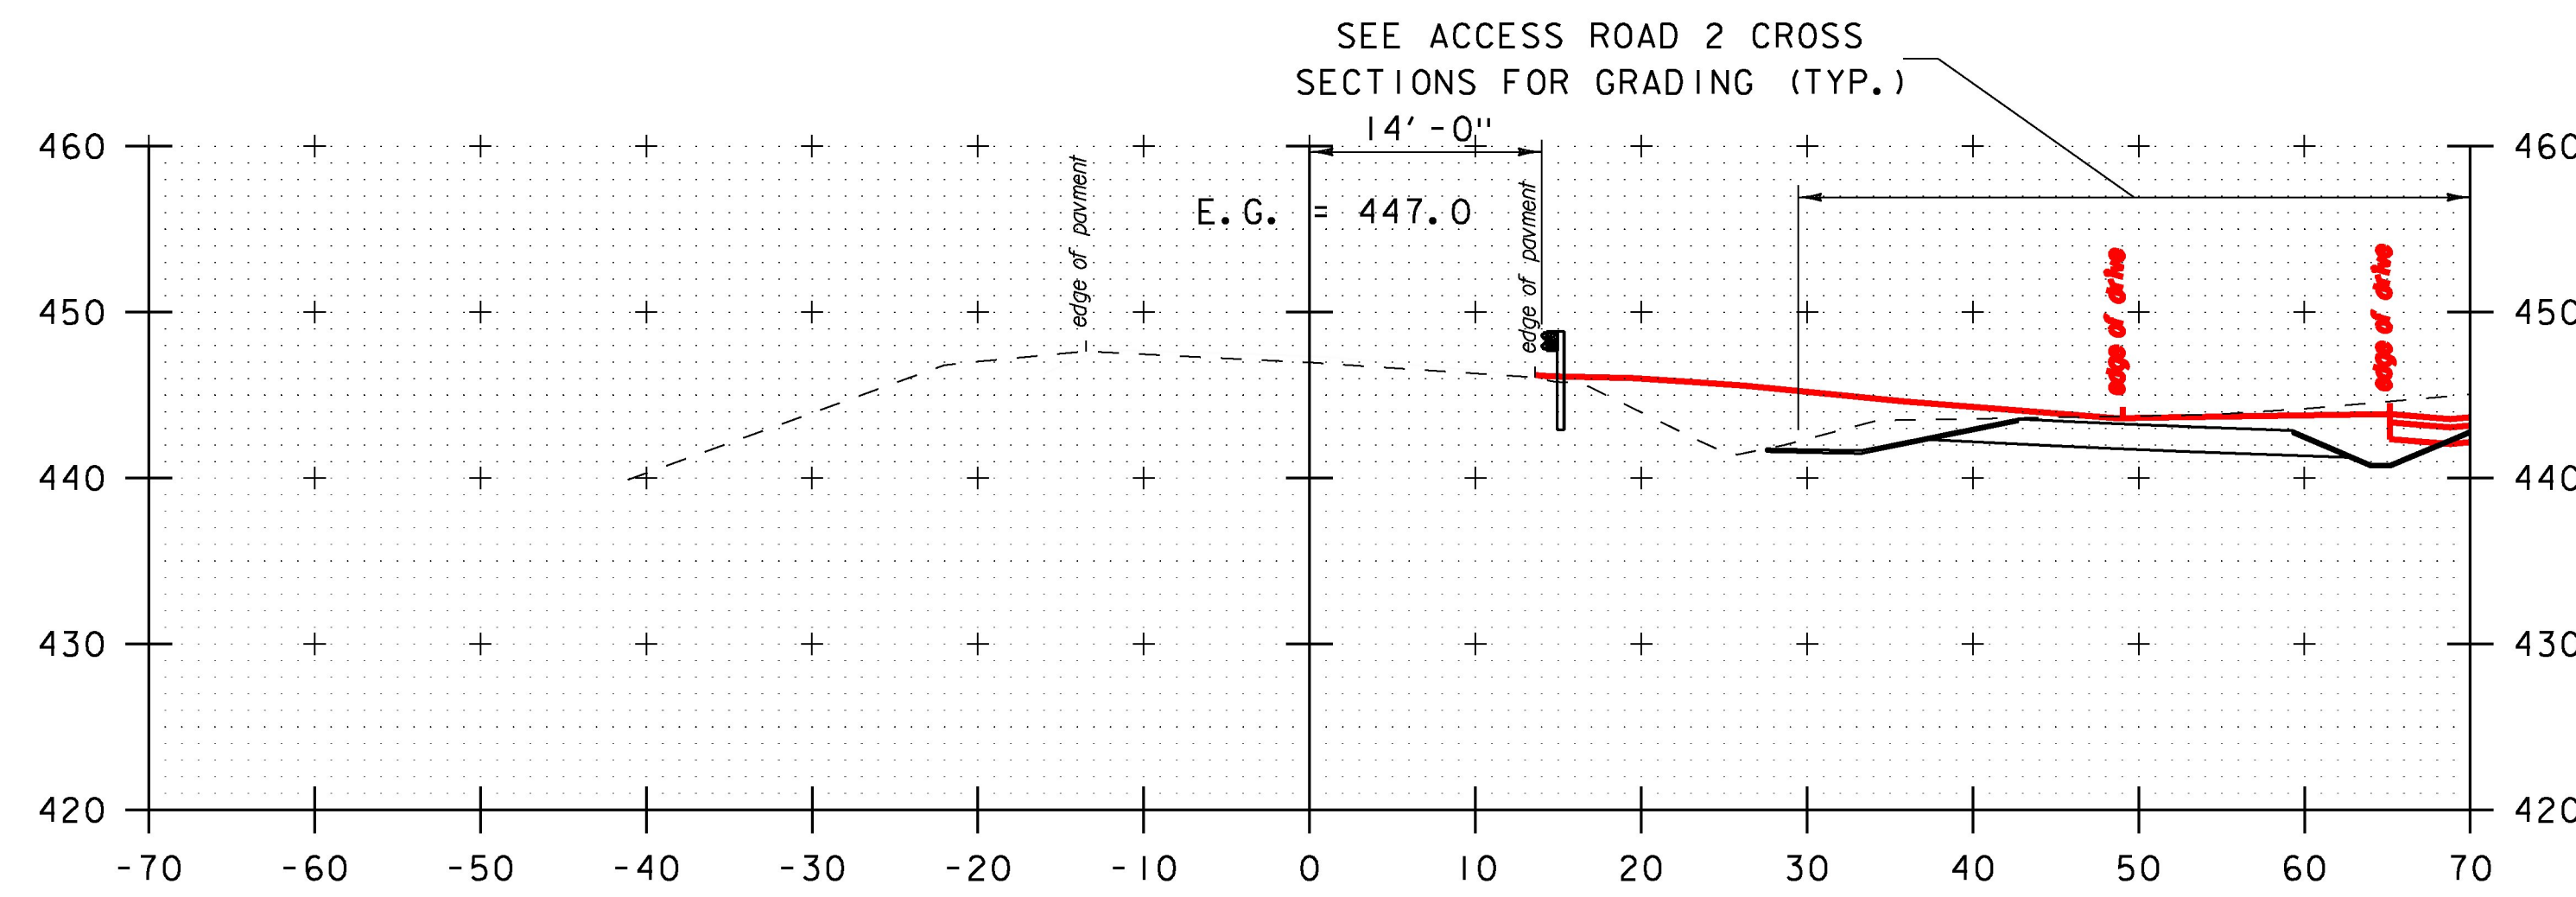


82+00

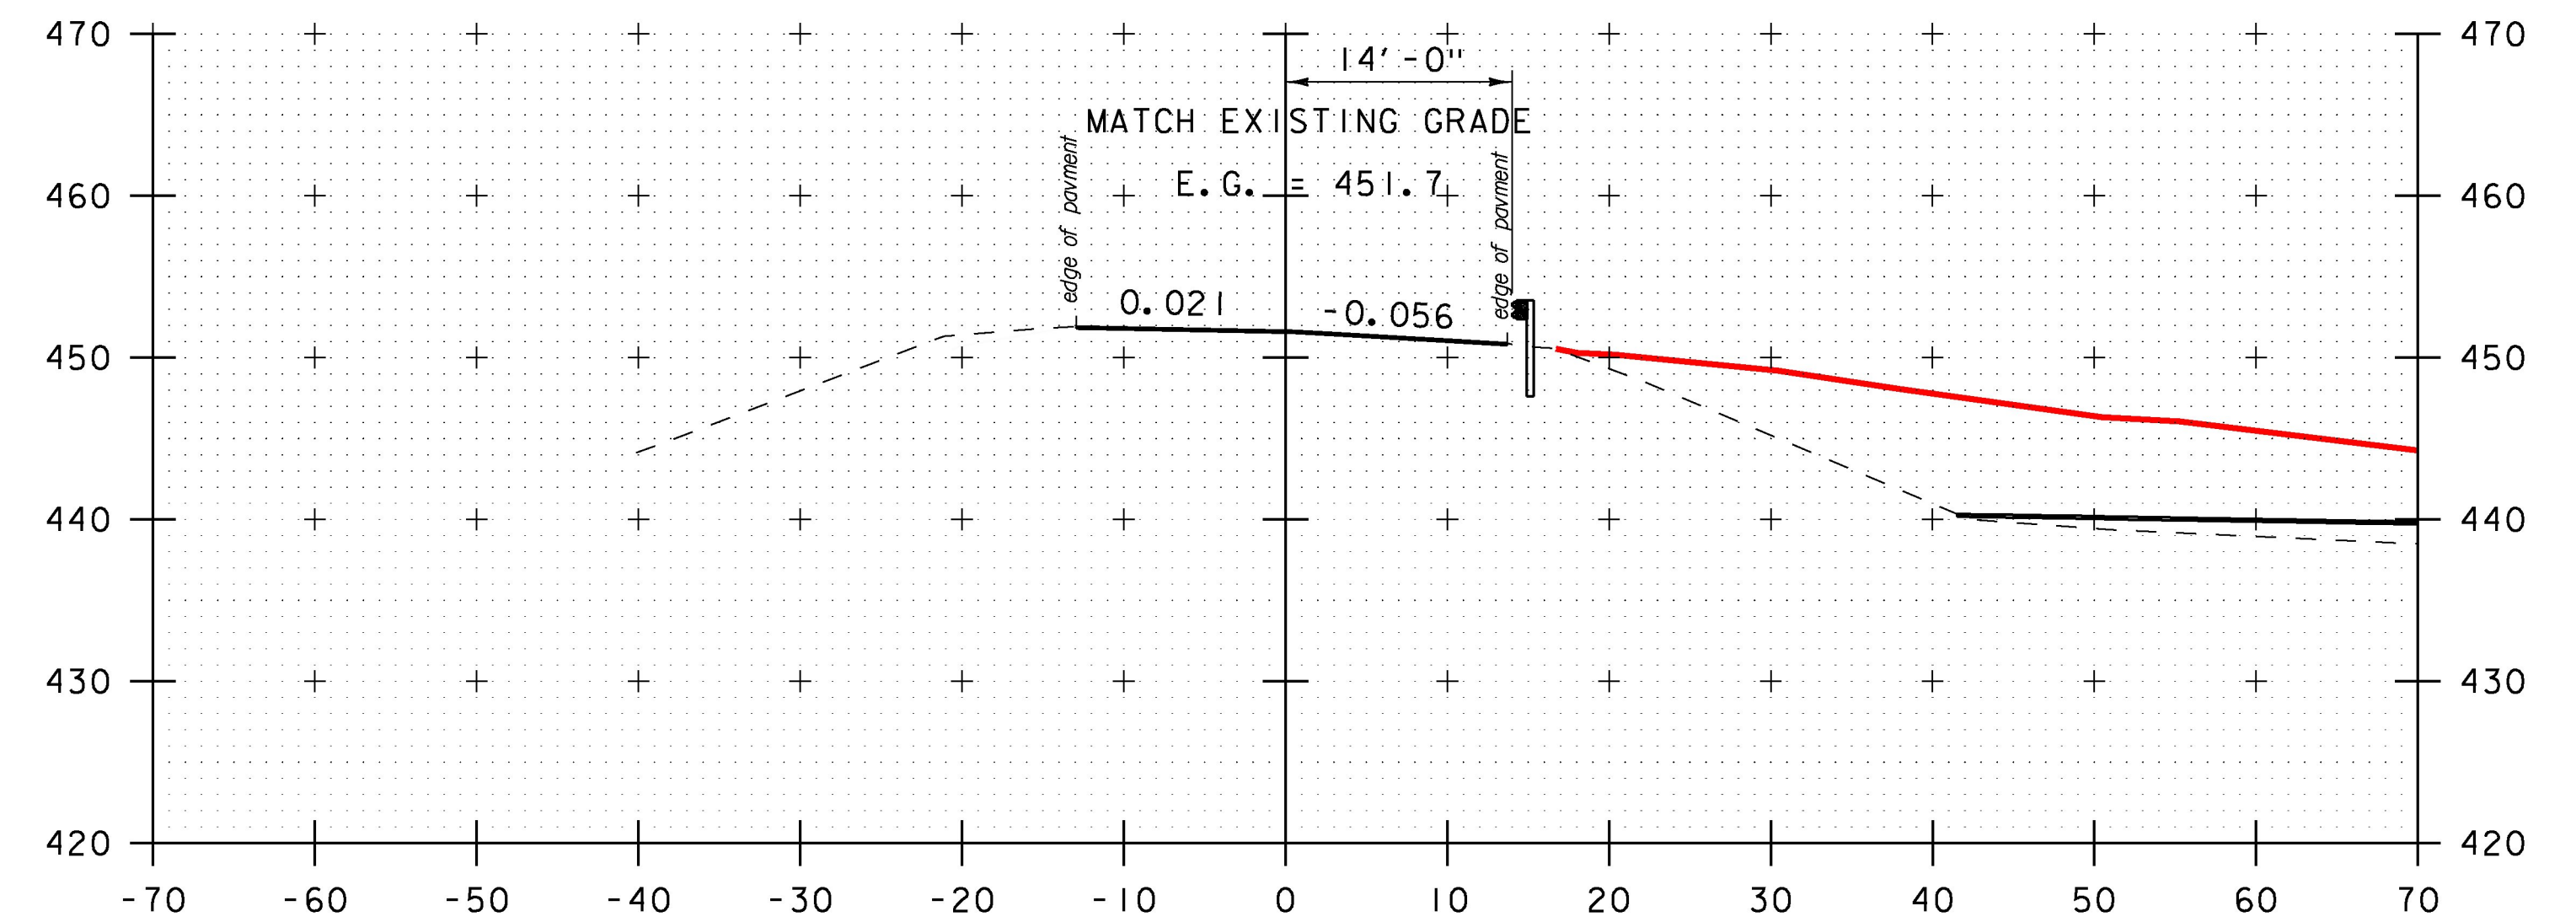

83+00

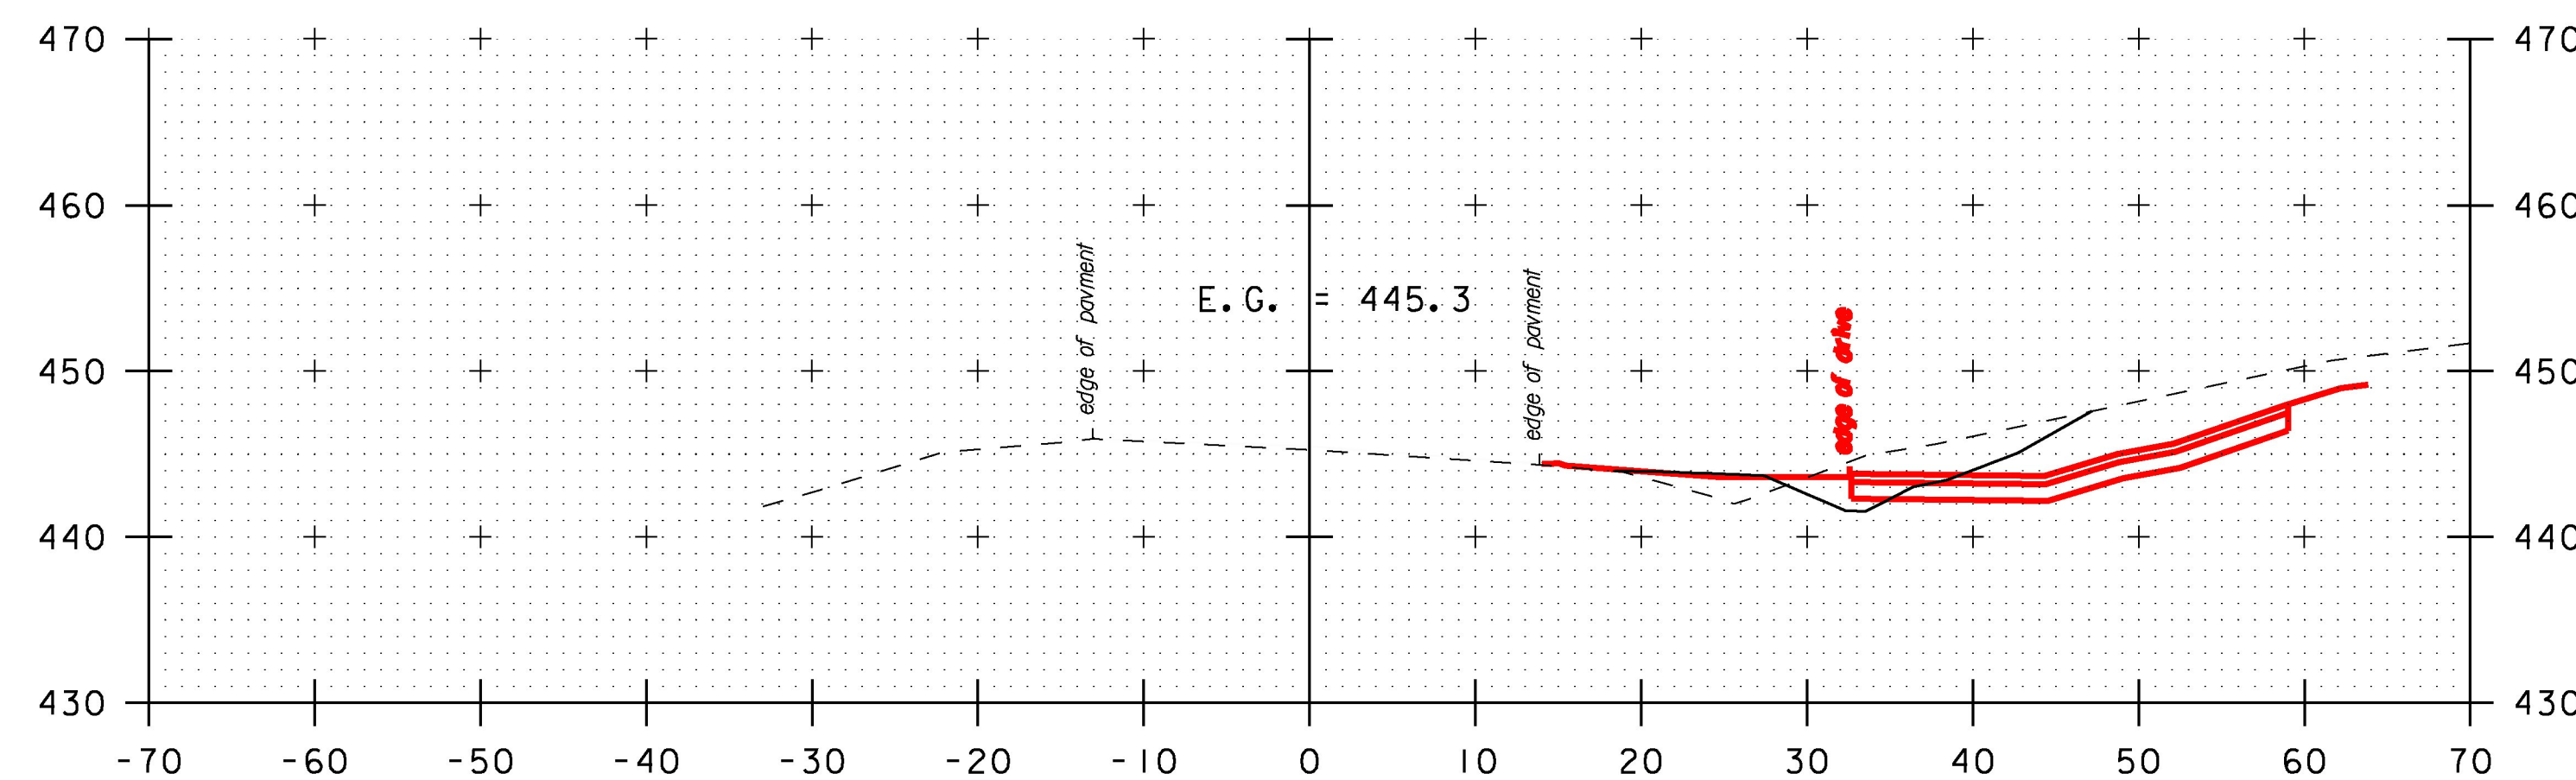

81+50

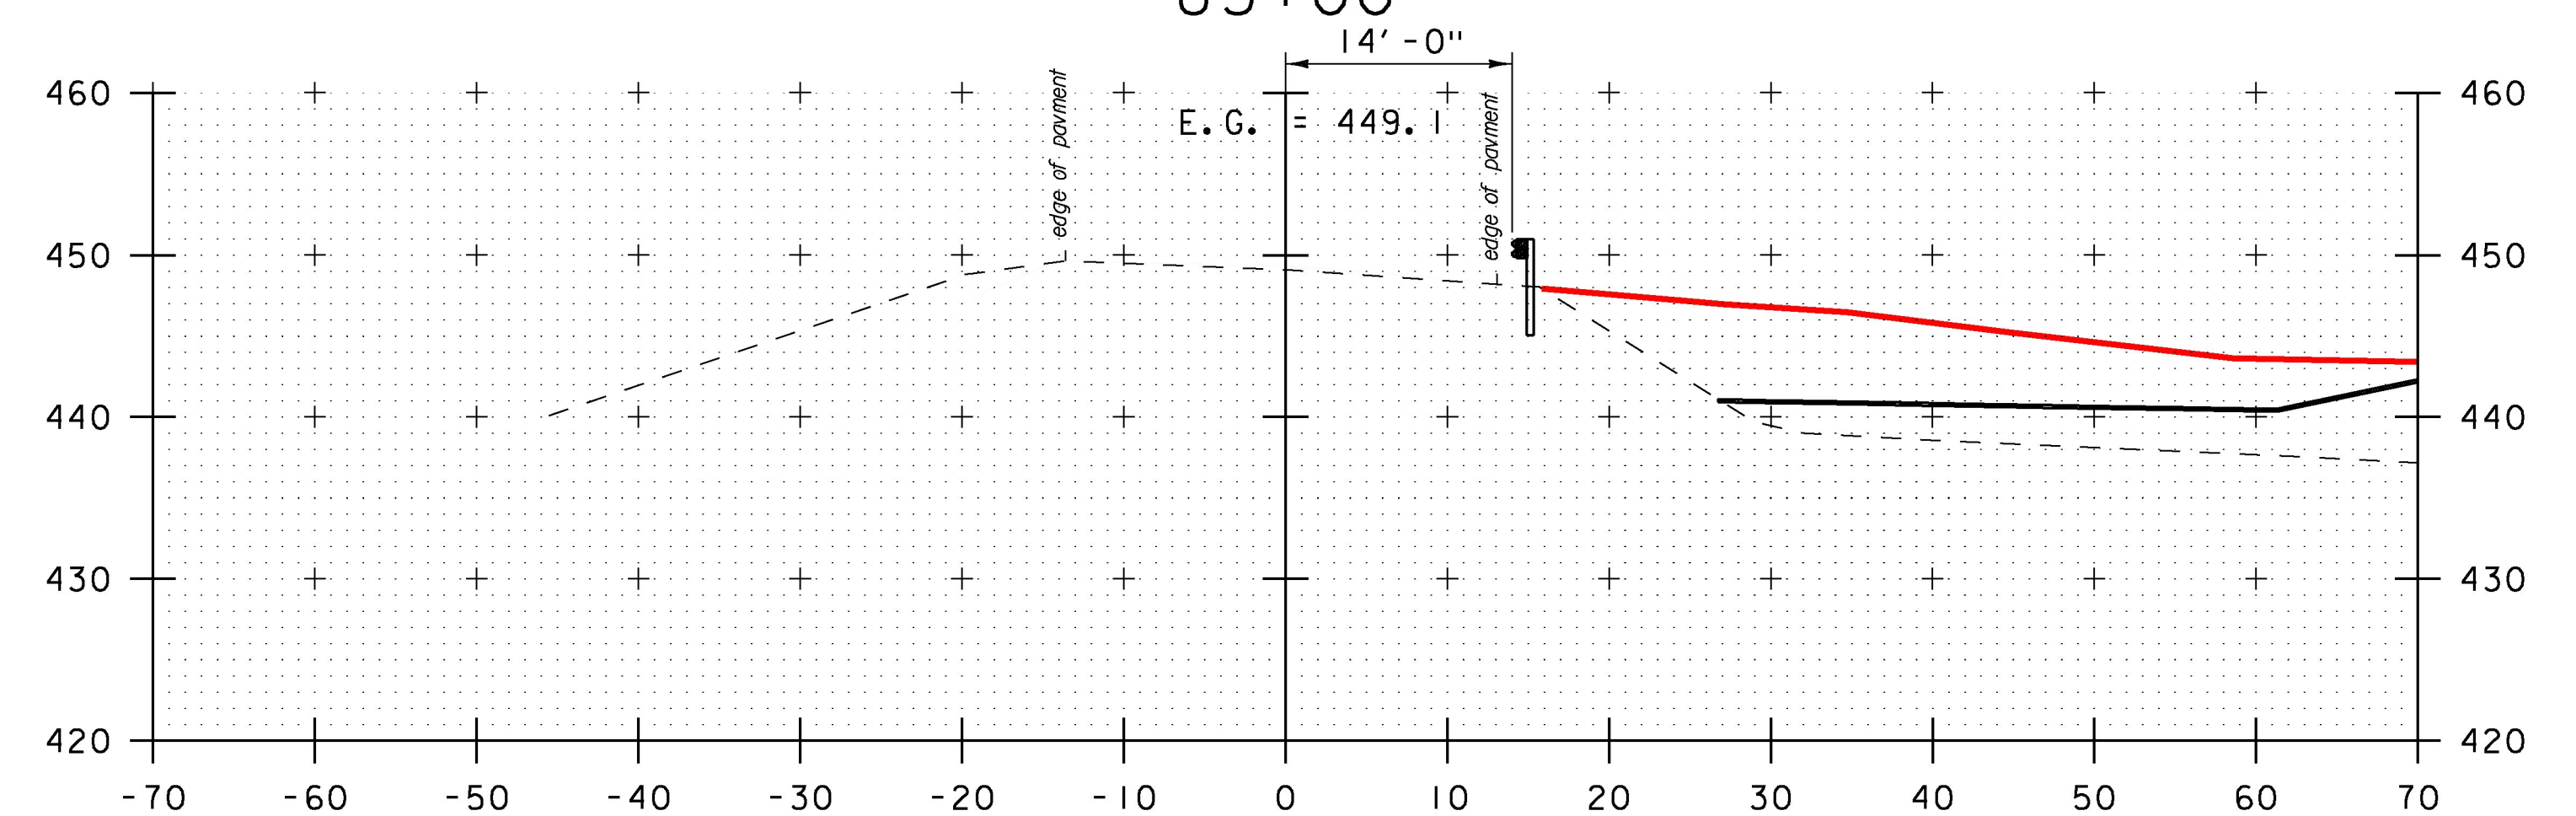

82+50

**RELEASED FOR  
CONSTRUCTION**  
NOVEMBER 24, 2015

PROJECT NAME: RYEGATE  
PROJECT NUMBER: STP CULV(10)

FILE NAME: z06cl56xs.dgn  
PROJECT LEADER: E. DETRICK  
DESIGNED BY: B. BRESLEND  
US ROUTE 5 CROSS SECTIONS SHEET 1

PLOT DATE: 11/24/2015  
DRAWN BY: B. BRESLEND  
CHECKED BY: E. DETRICK  
SHEET 13 OF 56

STA. 81+50 TO STA. 83+00

