


83+50

84+50

RELEASED FOR CONSTRUCTION
NOVEMBER 24, 2015

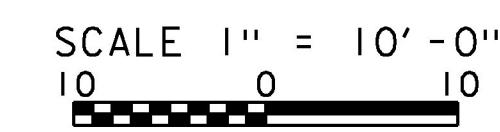

STA. 83+50 TO STA. 85+00



PROJECT NAME: RYEGATE
PROJECT NUMBER: STP CULV(10)

FILE NAME: z06cl56xs.dgn
PROJECT LEADER: E. DETRICK
DESIGNED BY: B. BRESLEND
US ROUTE 5 CROSS SECTIONS SHEET 2

PLOT DATE: 11/24/2015
DRAWN BY: B. BRESLEND
CHECKED BY: E. DETRICK
SHEET 14 OF 56