




88+00

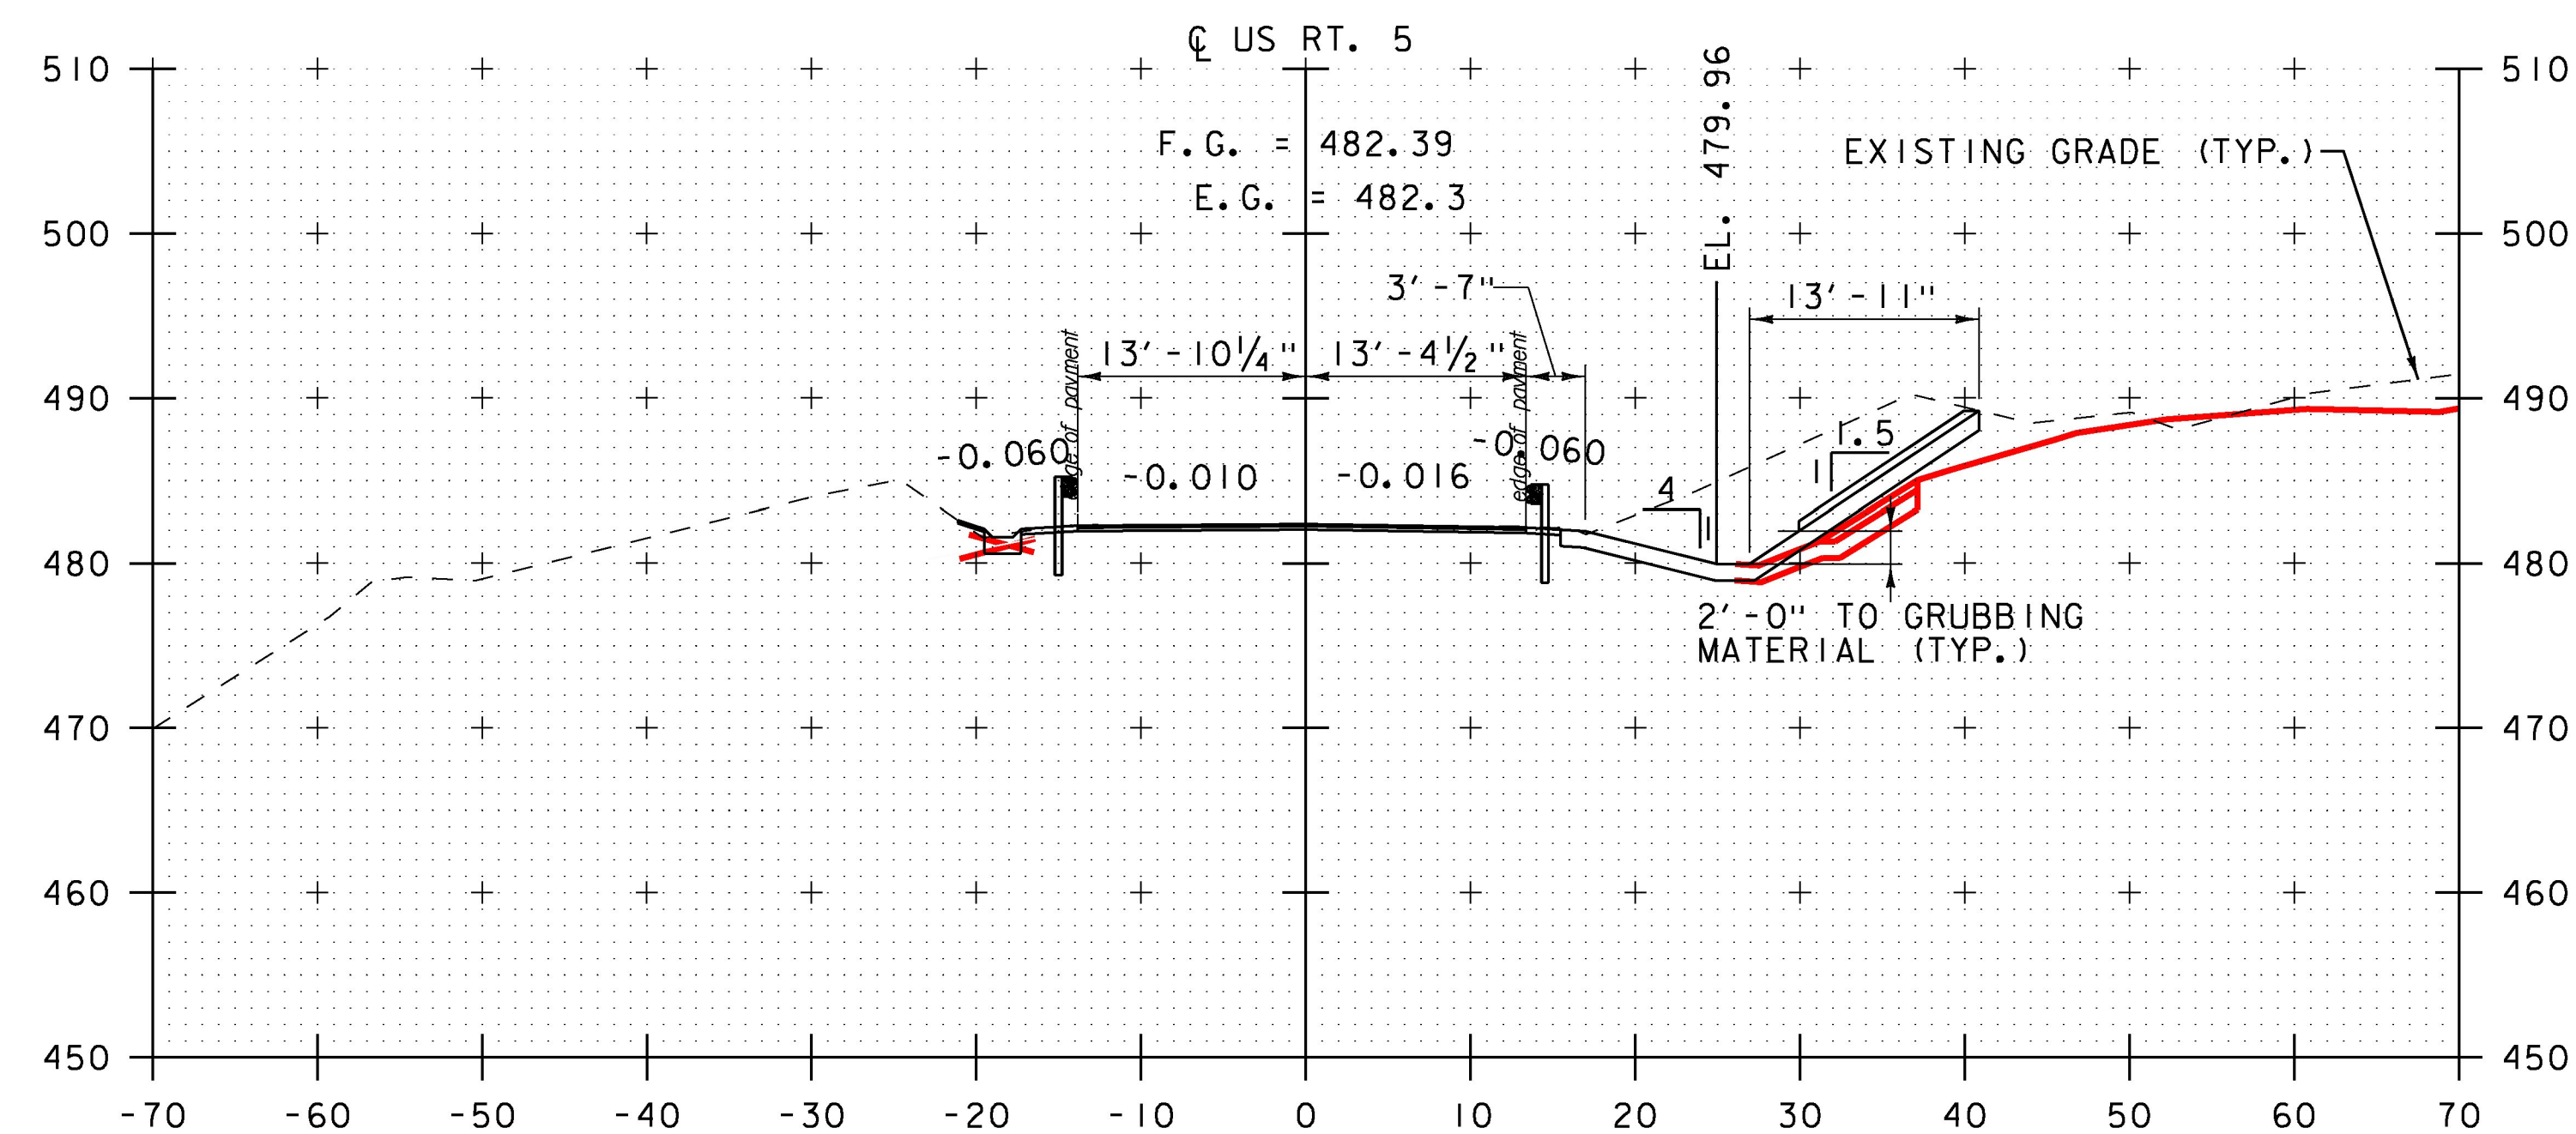

87+50

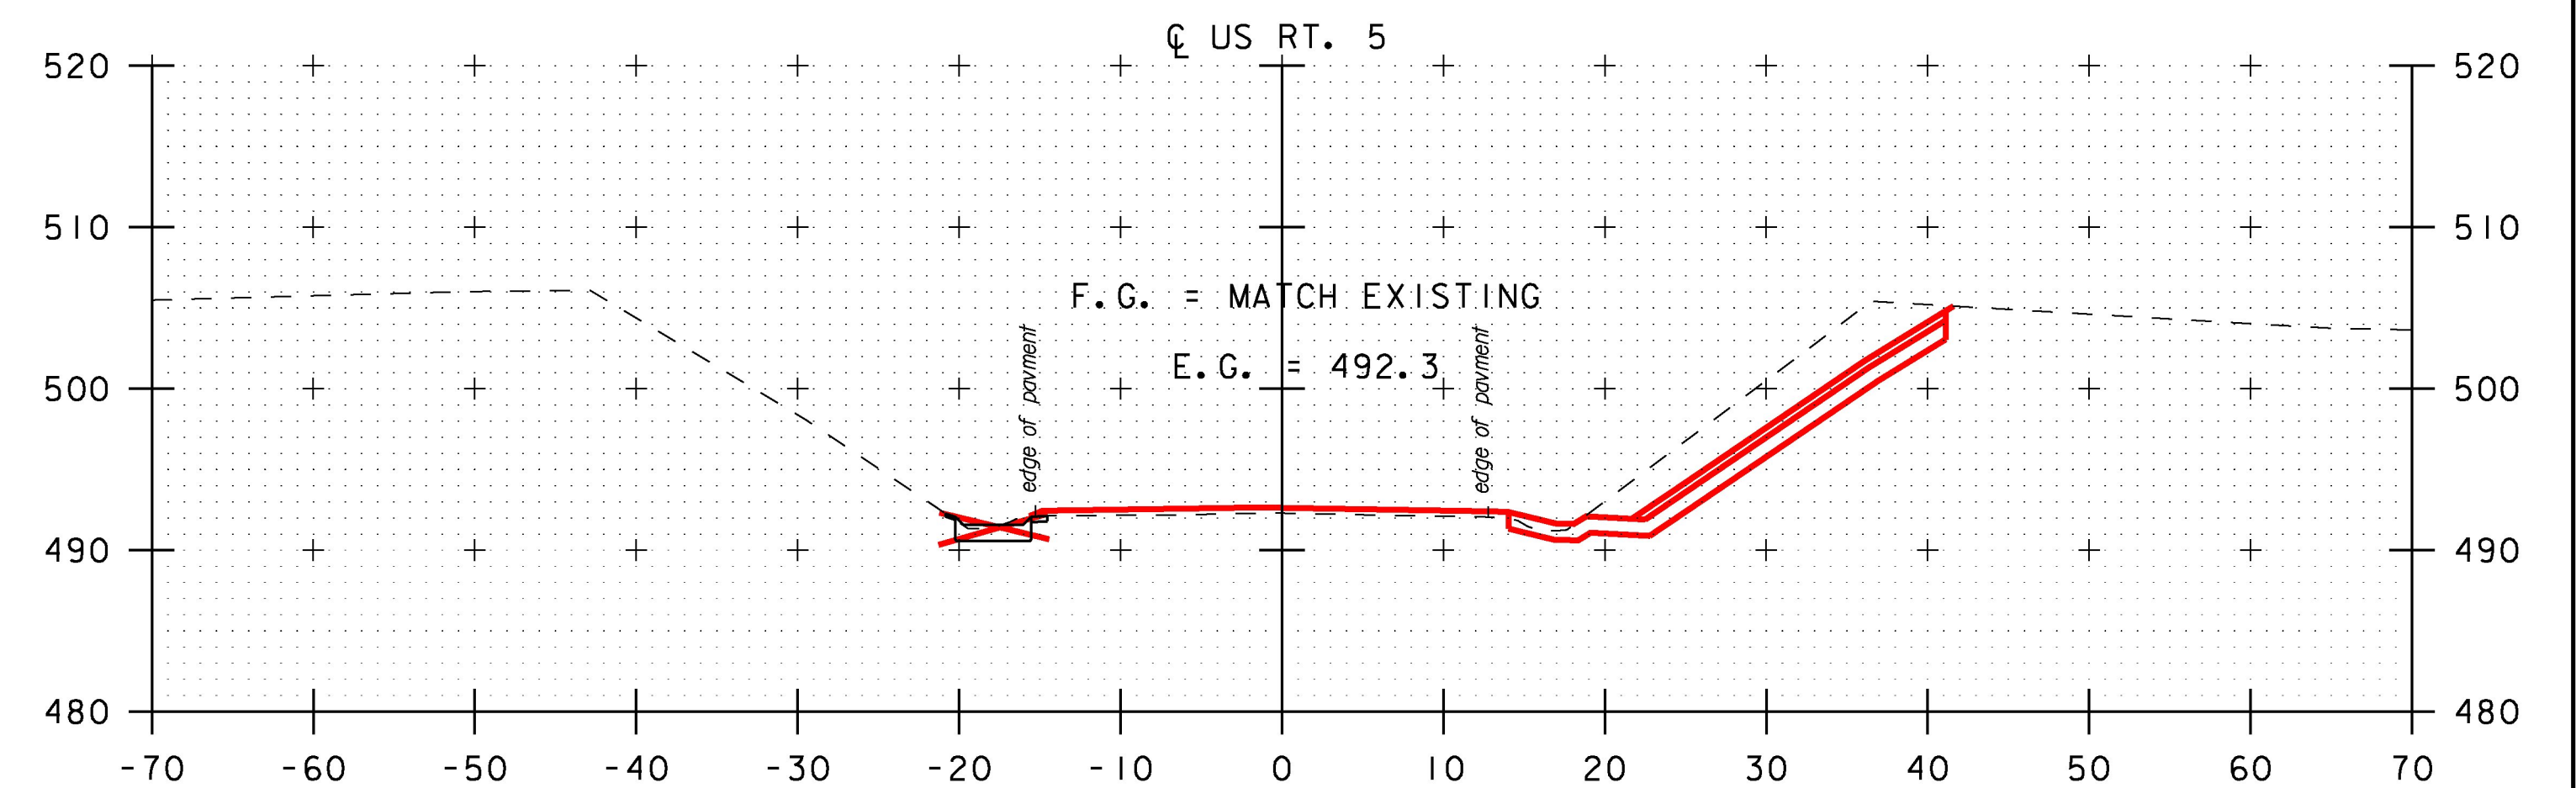

89+00

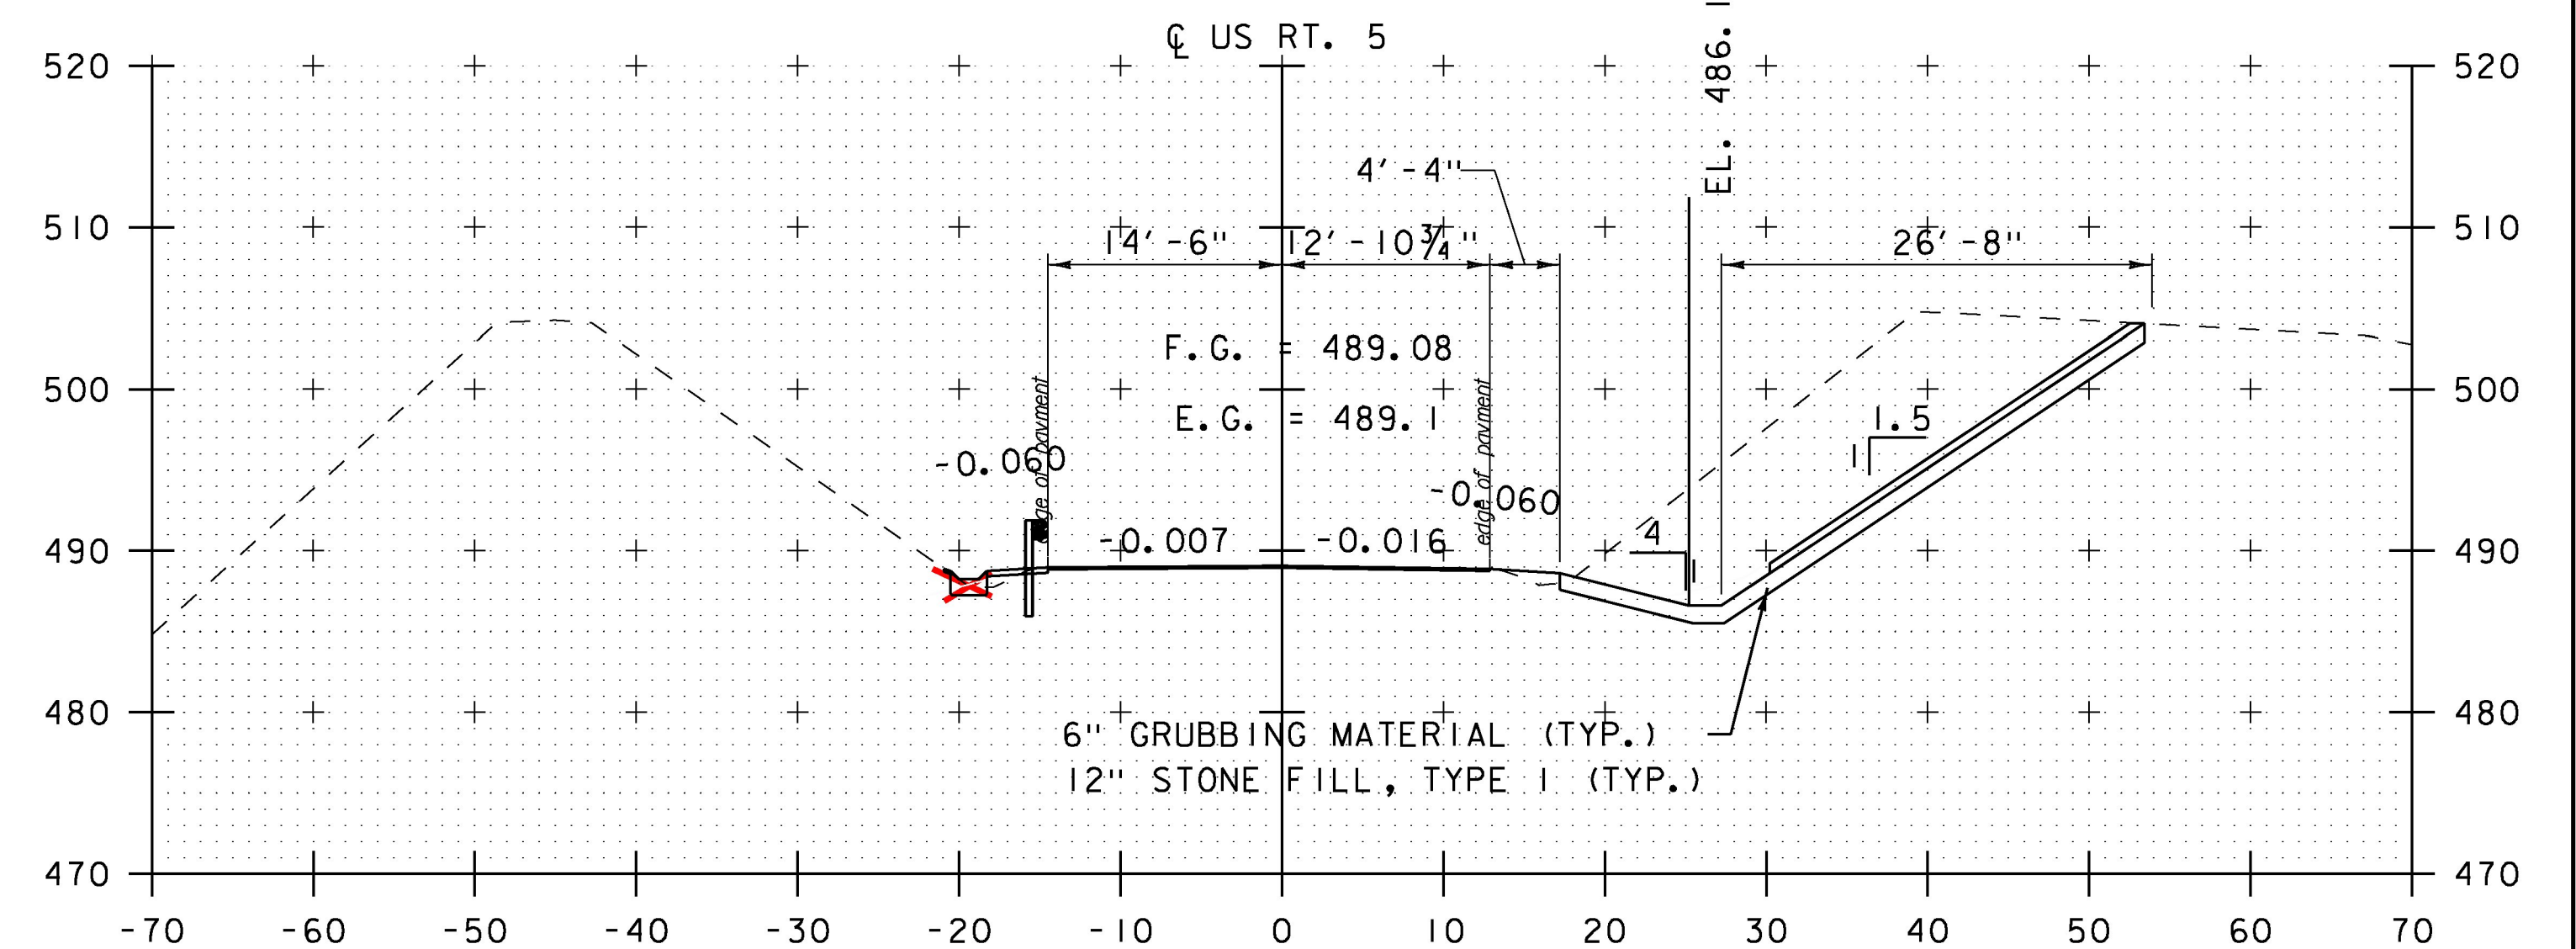

88+50

**RELEASED FOR
CONSTRUCTION**
NOVEMBER 24, 2015

PROJECT NAME: RYEGATE
PROJECT NUMBER: STP CULV(10)

FILE NAME: z06cl56xs.dgn
PROJECT LEADER: E. DETRICK
DESIGNED BY: B. BRESLEND
US ROUTE 5 CROSS SECTIONS SHEET 4

PLOT DATE: 11/24/2015
DRAWN BY: B. BRESLEND
CHECKED BY: E. DETRICK
SHEET 16 OF 56

STA. 87+50 TO STA. 89+00

