


**RELEASED FOR
 CONSTRUCTION**
 NOVEMBER 24, 2015

PROJECT NAME: RYEGATE
 PROJECT NUMBER: STP CULV(10)

FILE NAME: z06cl56xs.dgn
 PROJECT LEADER: E. DETRICK
 DESIGNED BY: B. BRESLEND
 WACR CROSS SECTION SHEET 1

PLOT DATE: 11/24/2015
 DRAWN BY: B. BRESLEND
 CHECKED BY: E. DETRICK
 SHEET 17 OF 56

NOTE: FINISH GRADE ELEVATION SHOWN IS FOR THE TOP OF THE LOW RAIL. EXISTING GRADE ELEVATION IS AT THE CENTERLINE.

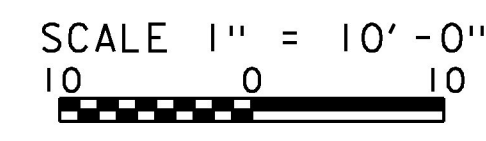

STA. 2357+00 TO STA. 2358+50

