


**RELEASED FOR
CONSTRUCTION**
NOVEMBER 24, 2015

PROJECT NAME: RYEGATE
PROJECT NUMBER: STP CULV(10)

FILE NAME: z06cl56xs.dgn
PROJECT LEADER: E. DETRICK
DESIGNED BY: B. BRESLEND
WACR CROSS SECTION SHEET 5

PLOT DATE: 11/24/2015
DRAWN BY: B. BRESLEND
CHECKED BY: E. DETRICK
SHEET 21 OF 56

NOTE: FINISH GRADE ELEVATION SHOWN IS FOR THE TOP OF THE LOW RAIL. EXISTING GRADE ELEVATION IS AT THE CENTERLINE.

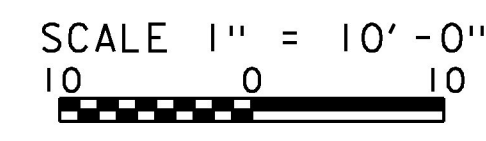

STA. 2363+50 TO STA. 2365+00

