




0+38

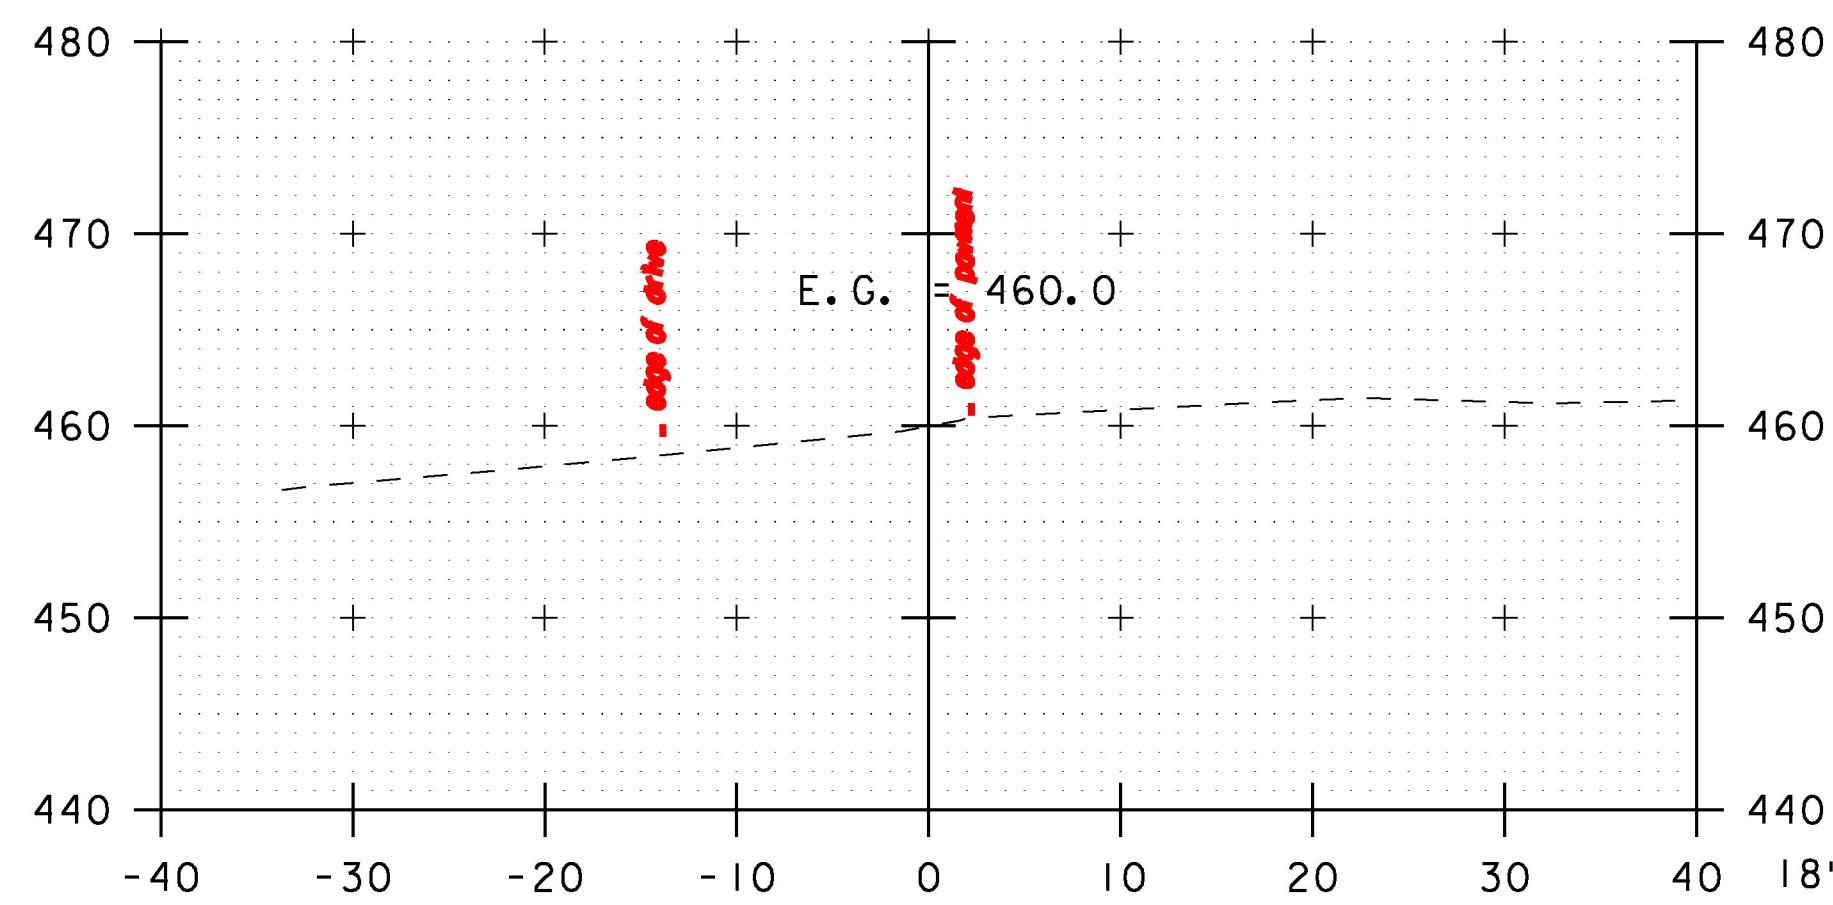


0+25

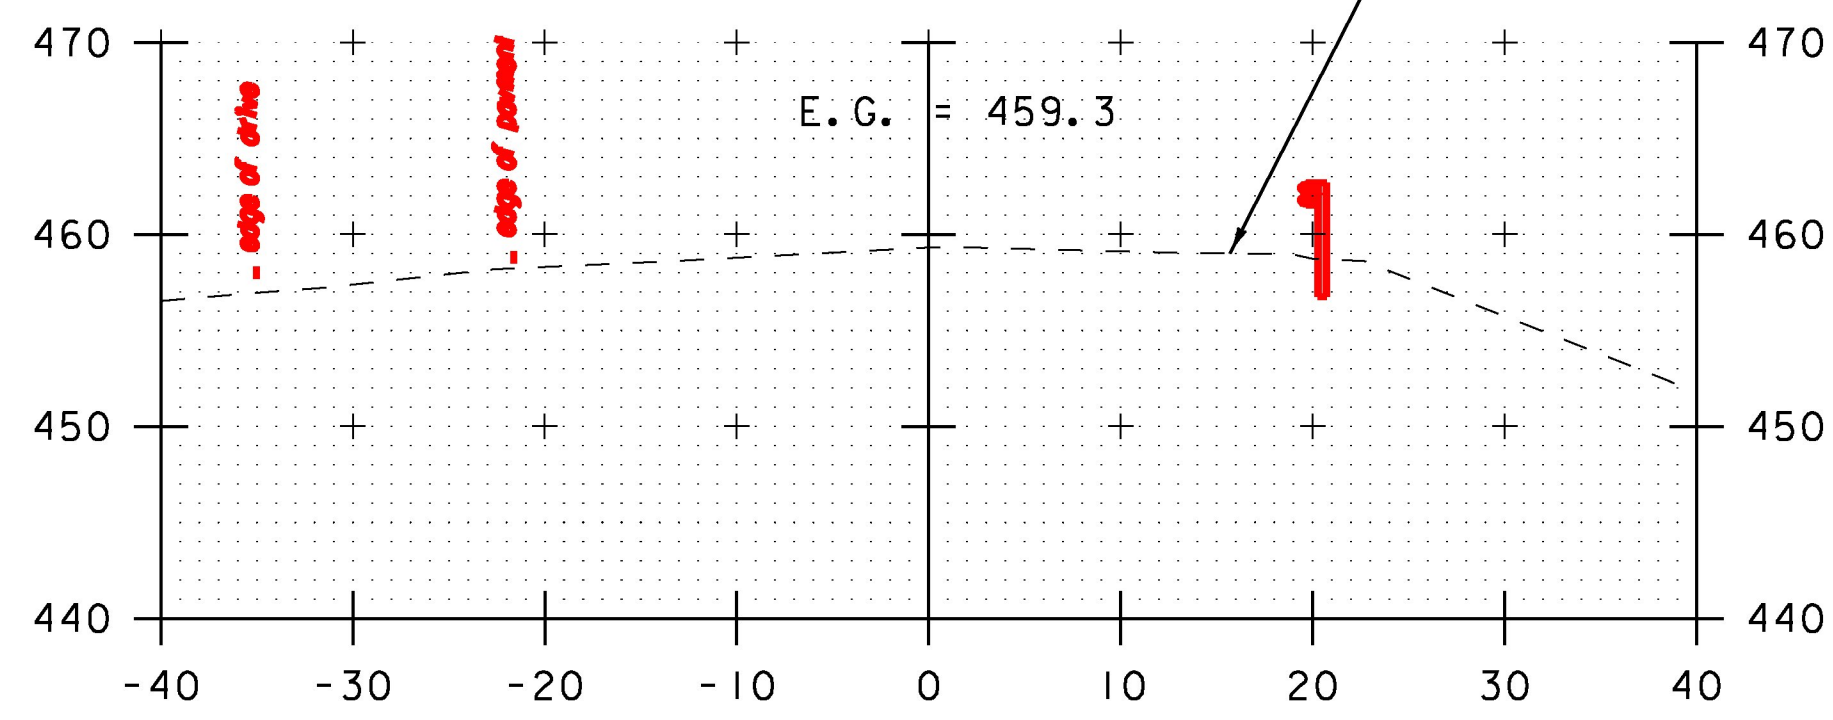


0+00

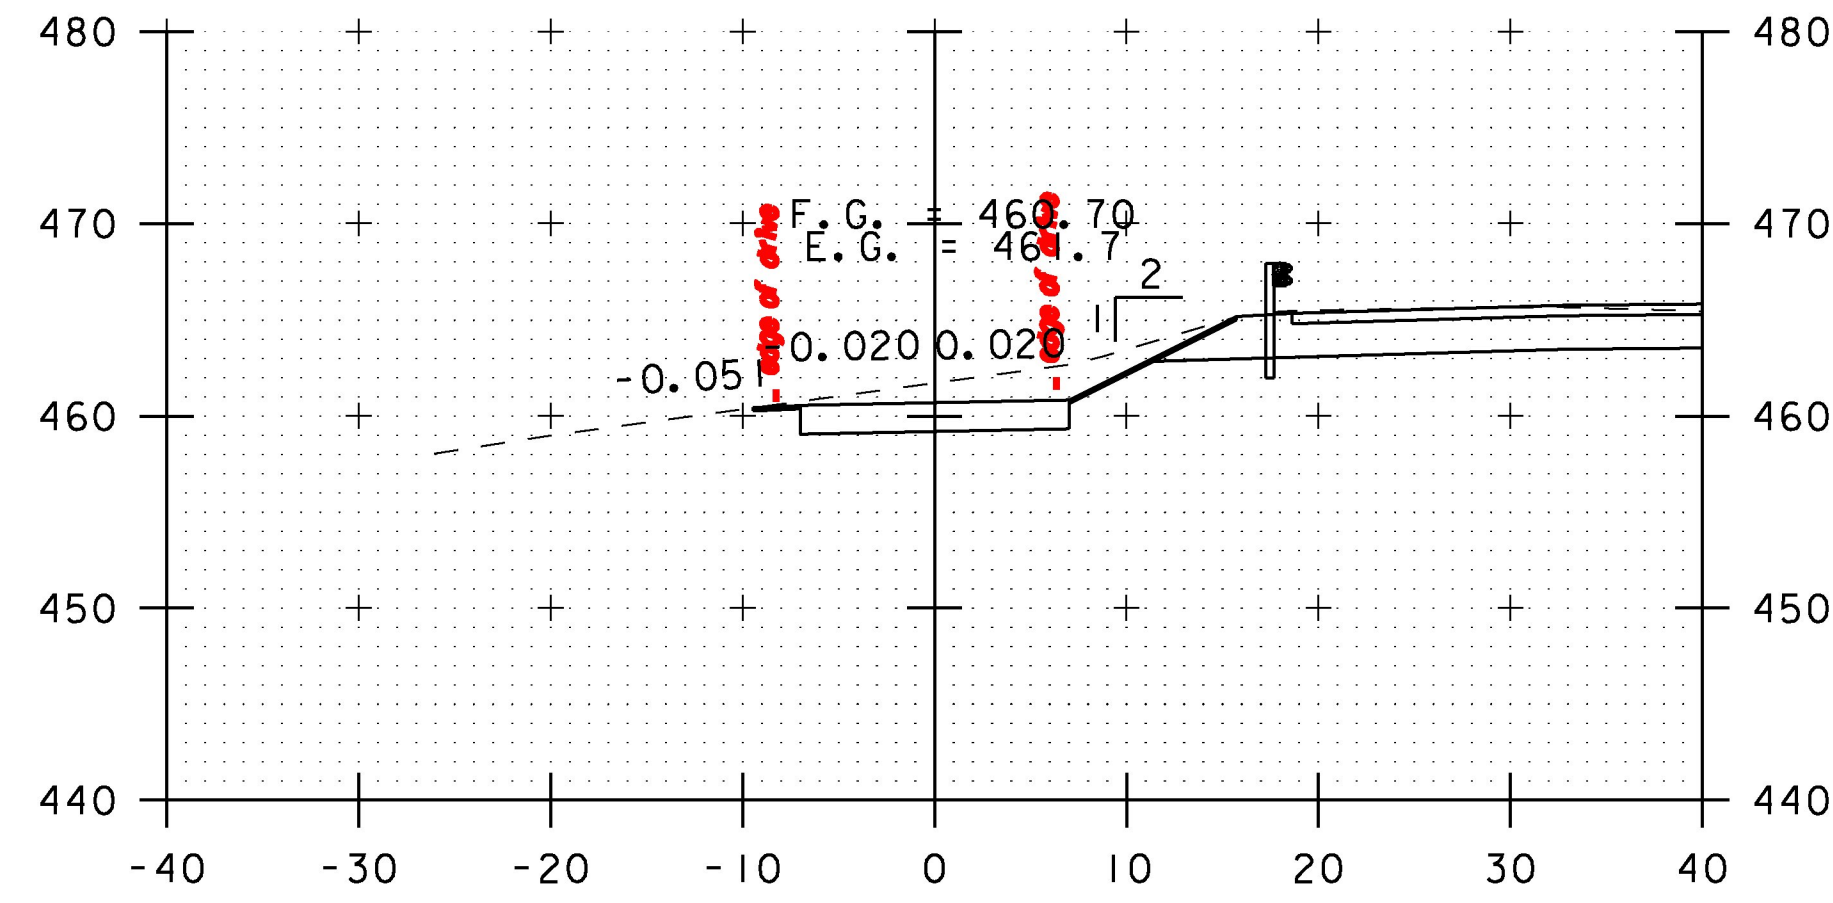


1+00

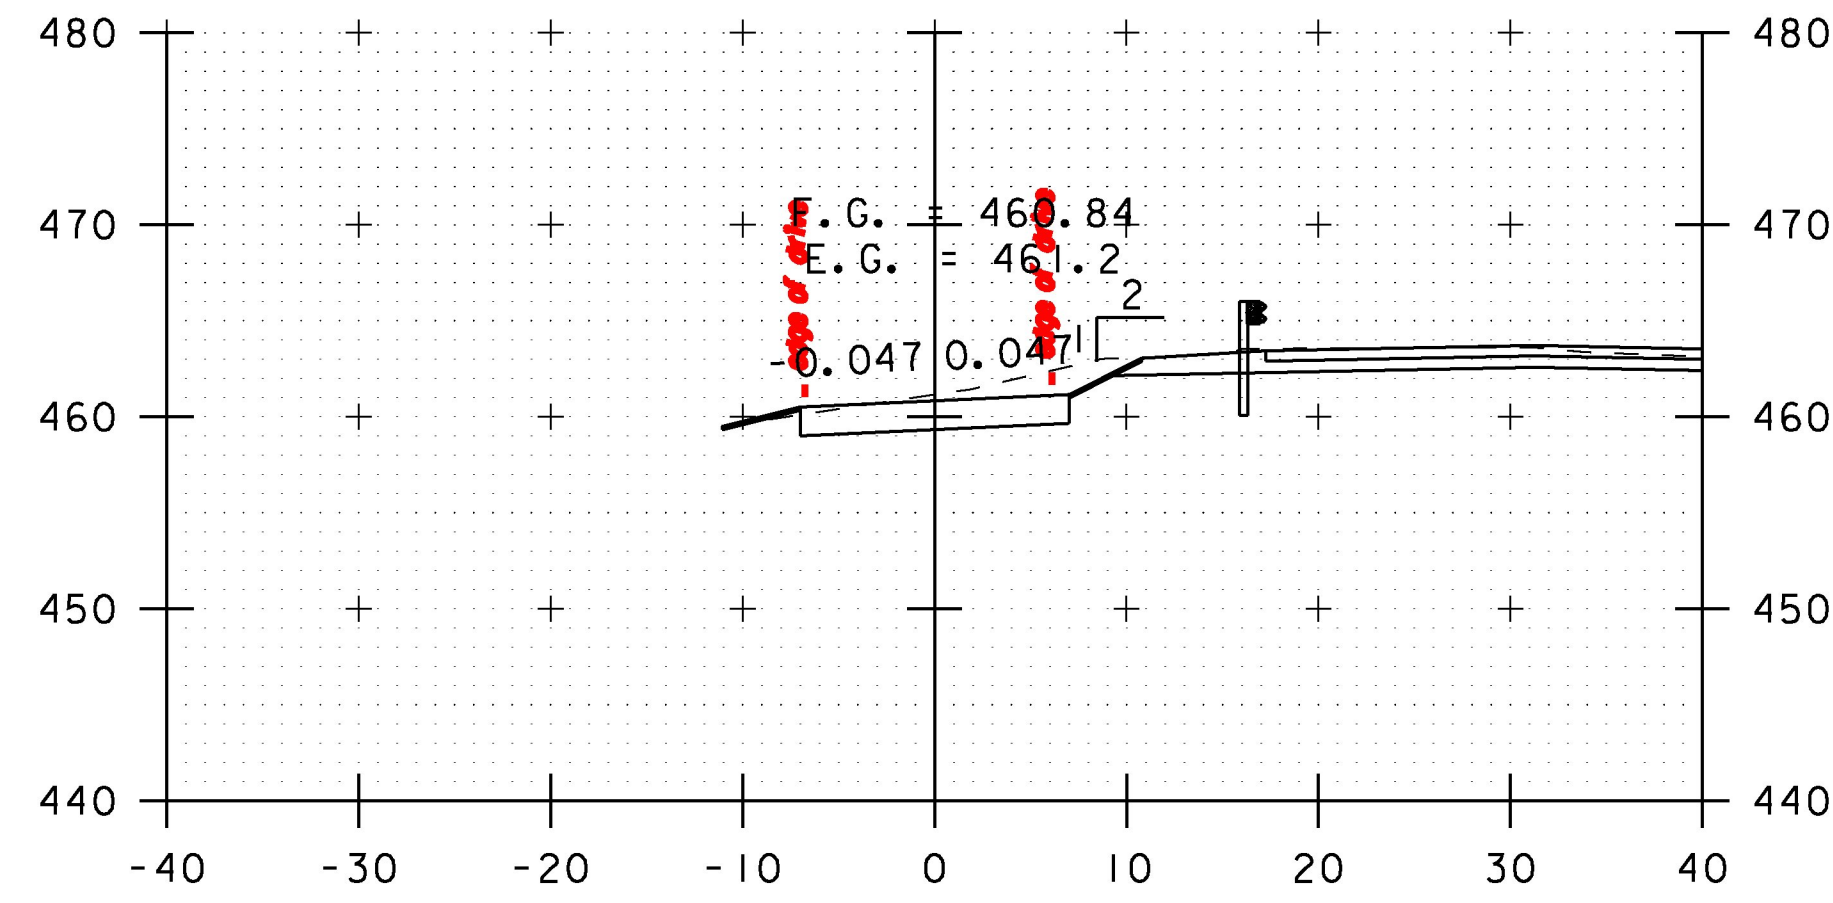


0+75

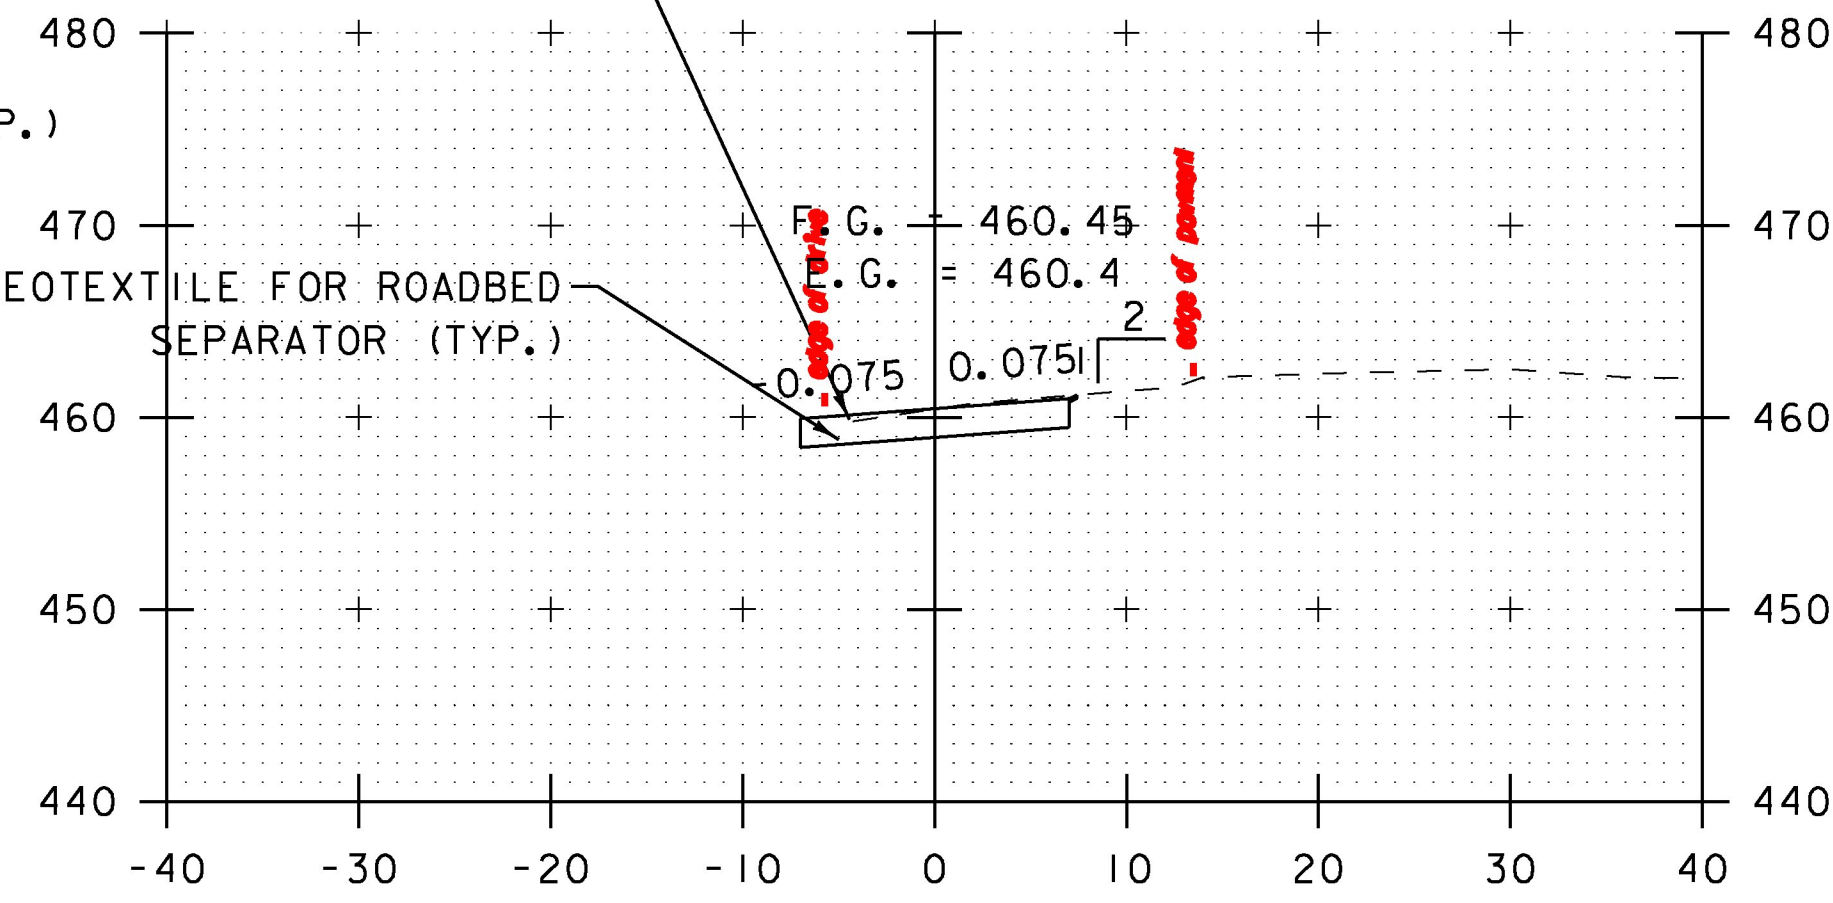

0+50

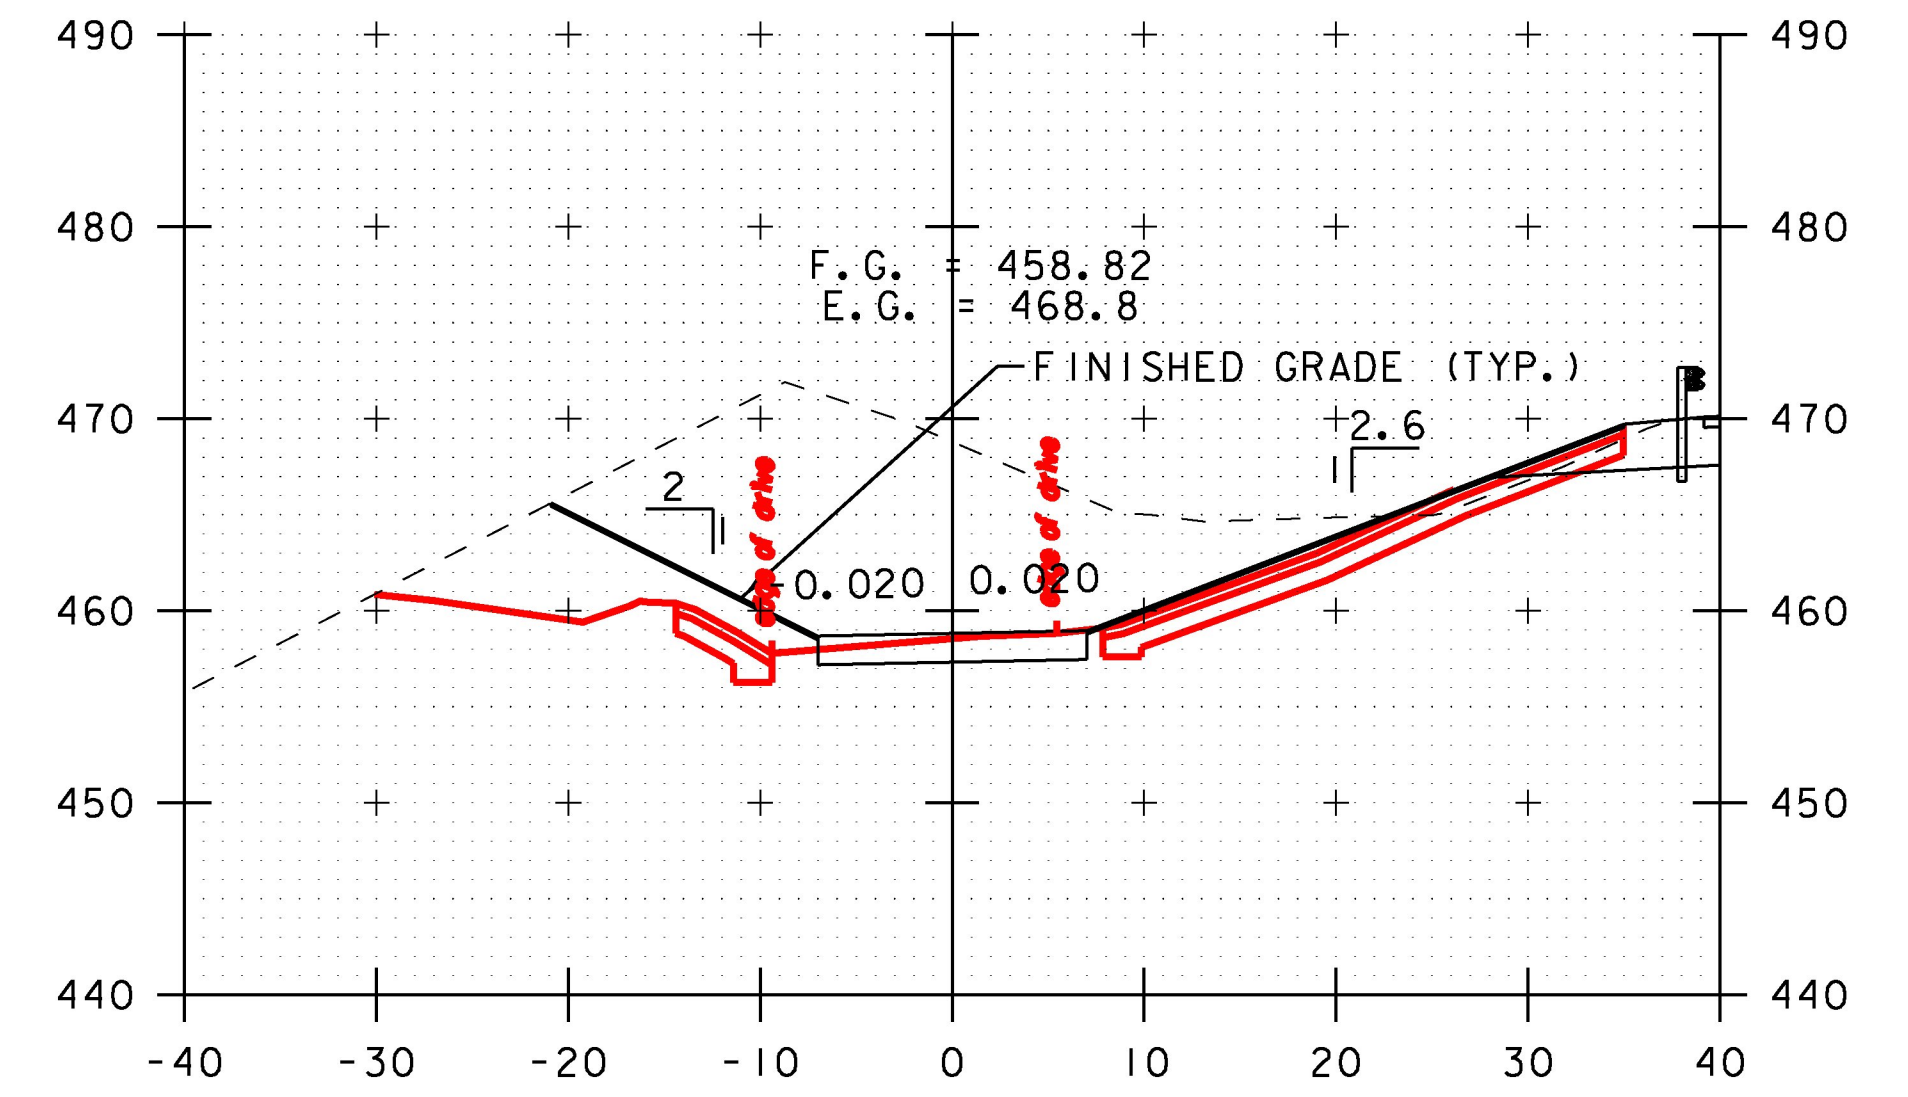


1+50

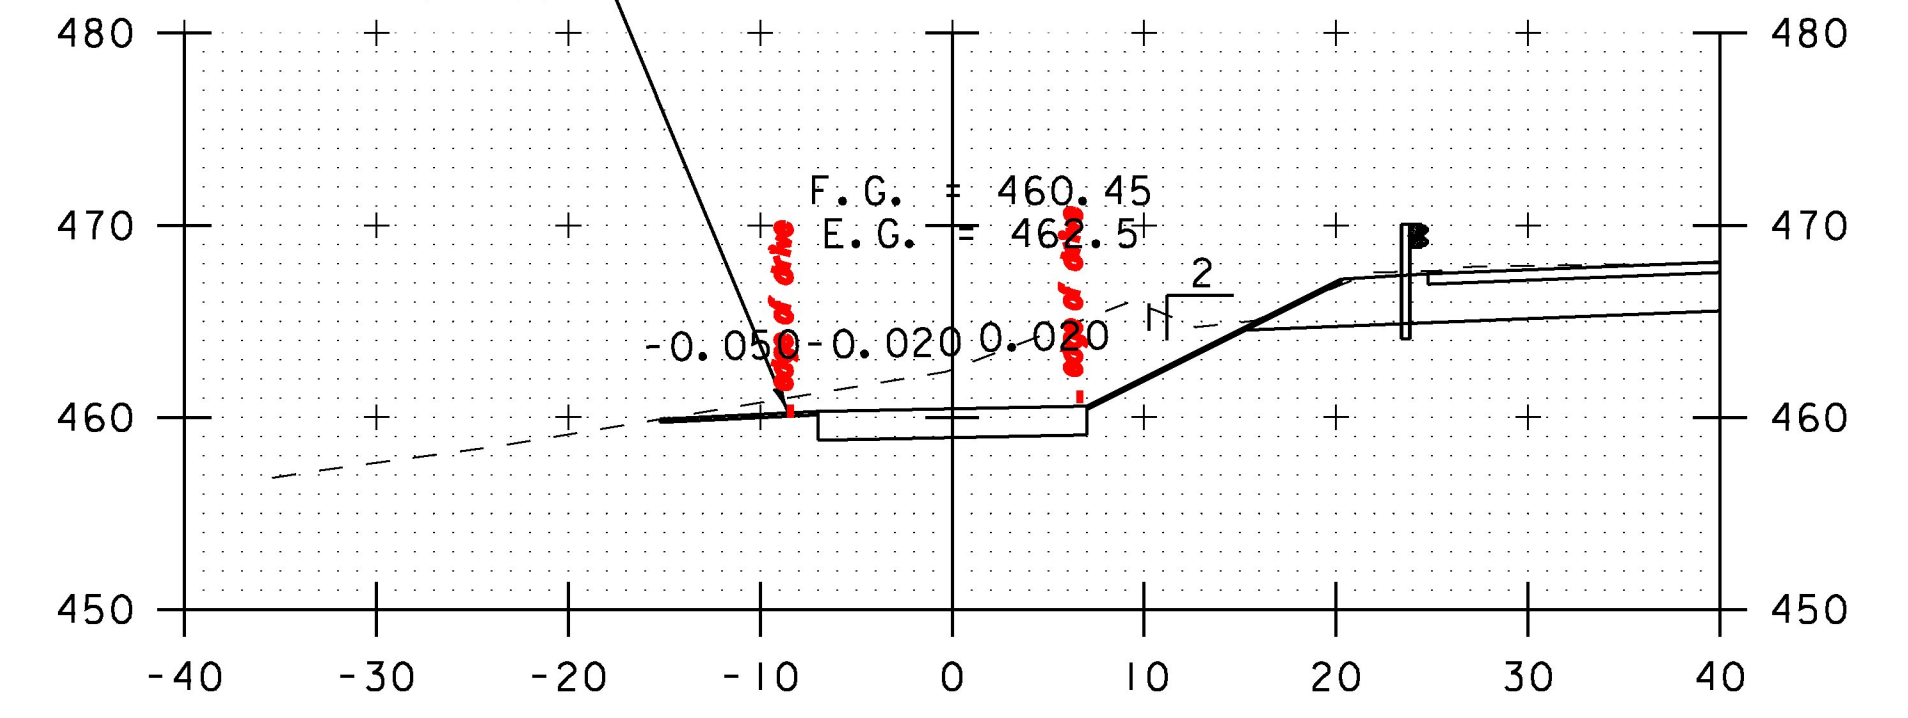

1+25

NOTE: US ROUTE 5 WORK NOT SHOWN ON STA. 0+00 - 0+50 CROSS SECTIONS.

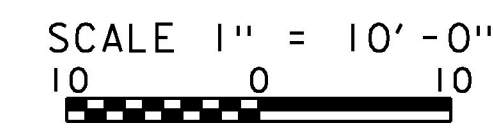

STA. 0+00 TO STA. 1+50



RELEASED FOR CONSTRUCTION

NOVEMBER 24, 2015

PROJECT NAME: RYEGATE
PROJECT NUMBER: STP CULV(10)

FILE NAME: z06cl56xs_accl.dgn
PROJECT LEADER: E. DETRICK
DESIGNED BY: B. BRESLEND
ACCESS ROAD 1 CROSS SECTION SHEET 1

PLOT DATE: 11/24/2015
DRAWN BY: B. BRESLEND
CHECKED BY: E. DETRICK
SHEET 23 OF 56