




2+00

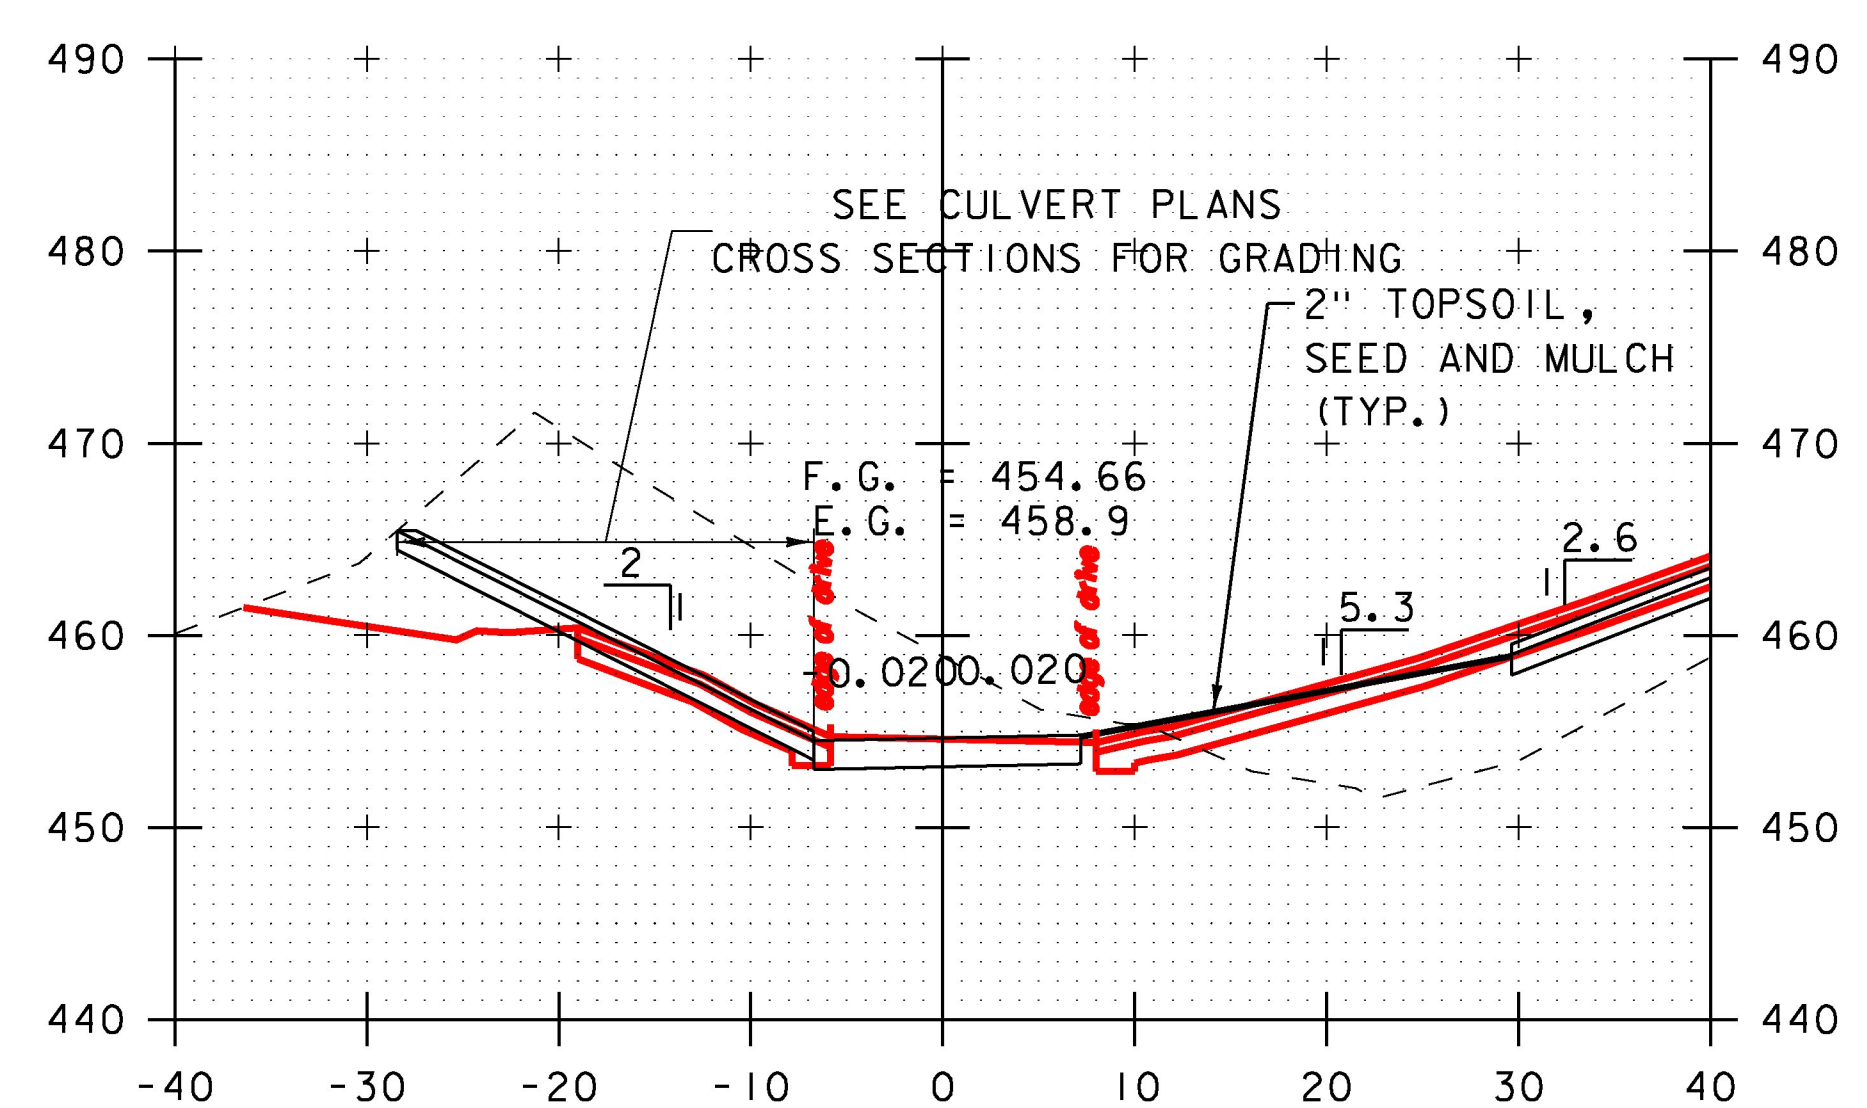

1+75

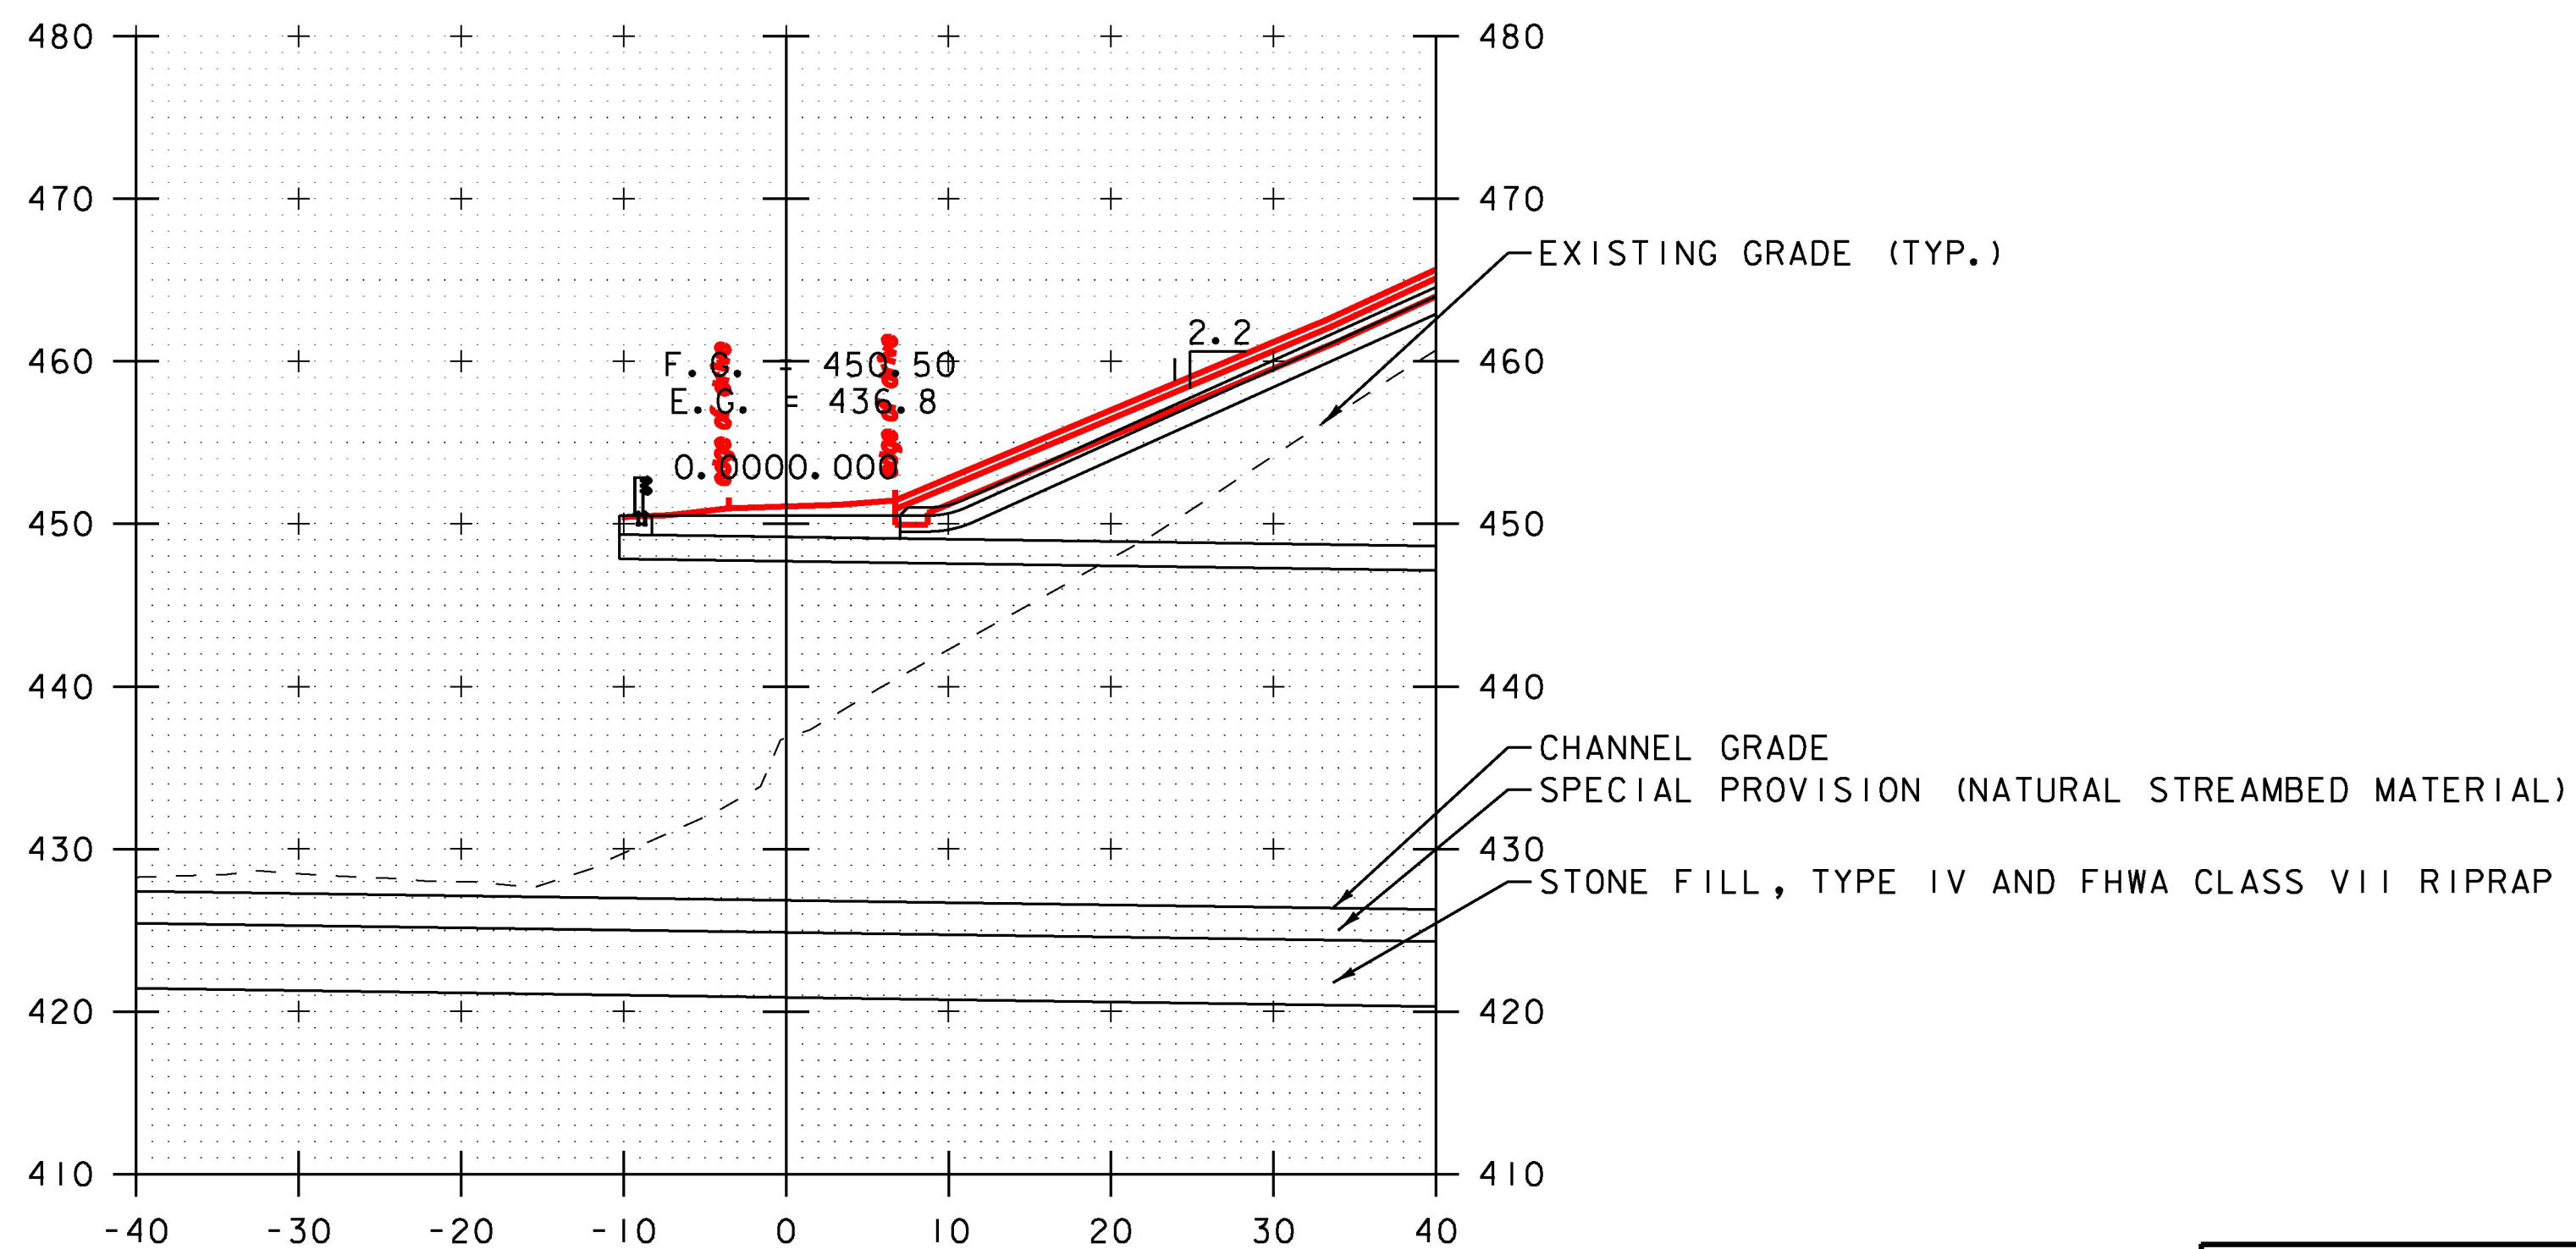

2+25

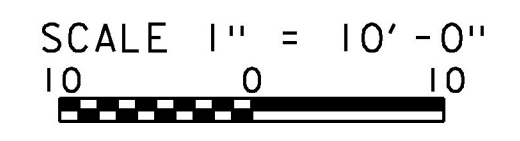

STA. 1+75 TO STA. 2+25



RELEASED FOR CONSTRUCTION
NOVEMBER 24, 2015

PROJECT NAME: RYEGATE	PLOT DATE: 11/24/2015
PROJECT NUMBER: STP_CULV(10)	DRAWN BY: B. BRESLEND
FILE NAME: z06cl56xs_accl.dgn	CHECKED BY: E. DETRICK
DESIGNED BY: B. BRESLEND	ACCESS ROAD 1 CROSS SECTION SHEET 2
	SHEET 24 OF 56