


21+25

21+75

**RELEASED FOR
CONSTRUCTION**
NOVEMBER 24, 2015

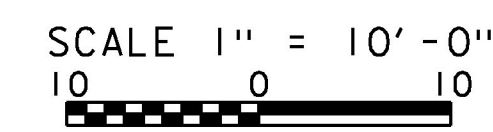

STA. 21+25 TO STA. 22+00



PROJECT NAME: RYEGATE
PROJECT NUMBER: STP CULV(10)

FILE NAME: z06cl56xs_acc2.dgn
PROJECT LEADER: E. DETRICK
DESIGNED BY: B. BRESLEND
ACCESS ROAD 2 CROSS SECTION SHEET 2

PLOT DATE: 11/24/2015
DRAWN BY: B. BRESLEND
CHECKED BY: E. DETRICK
SHEET 26 OF 56