




23+50

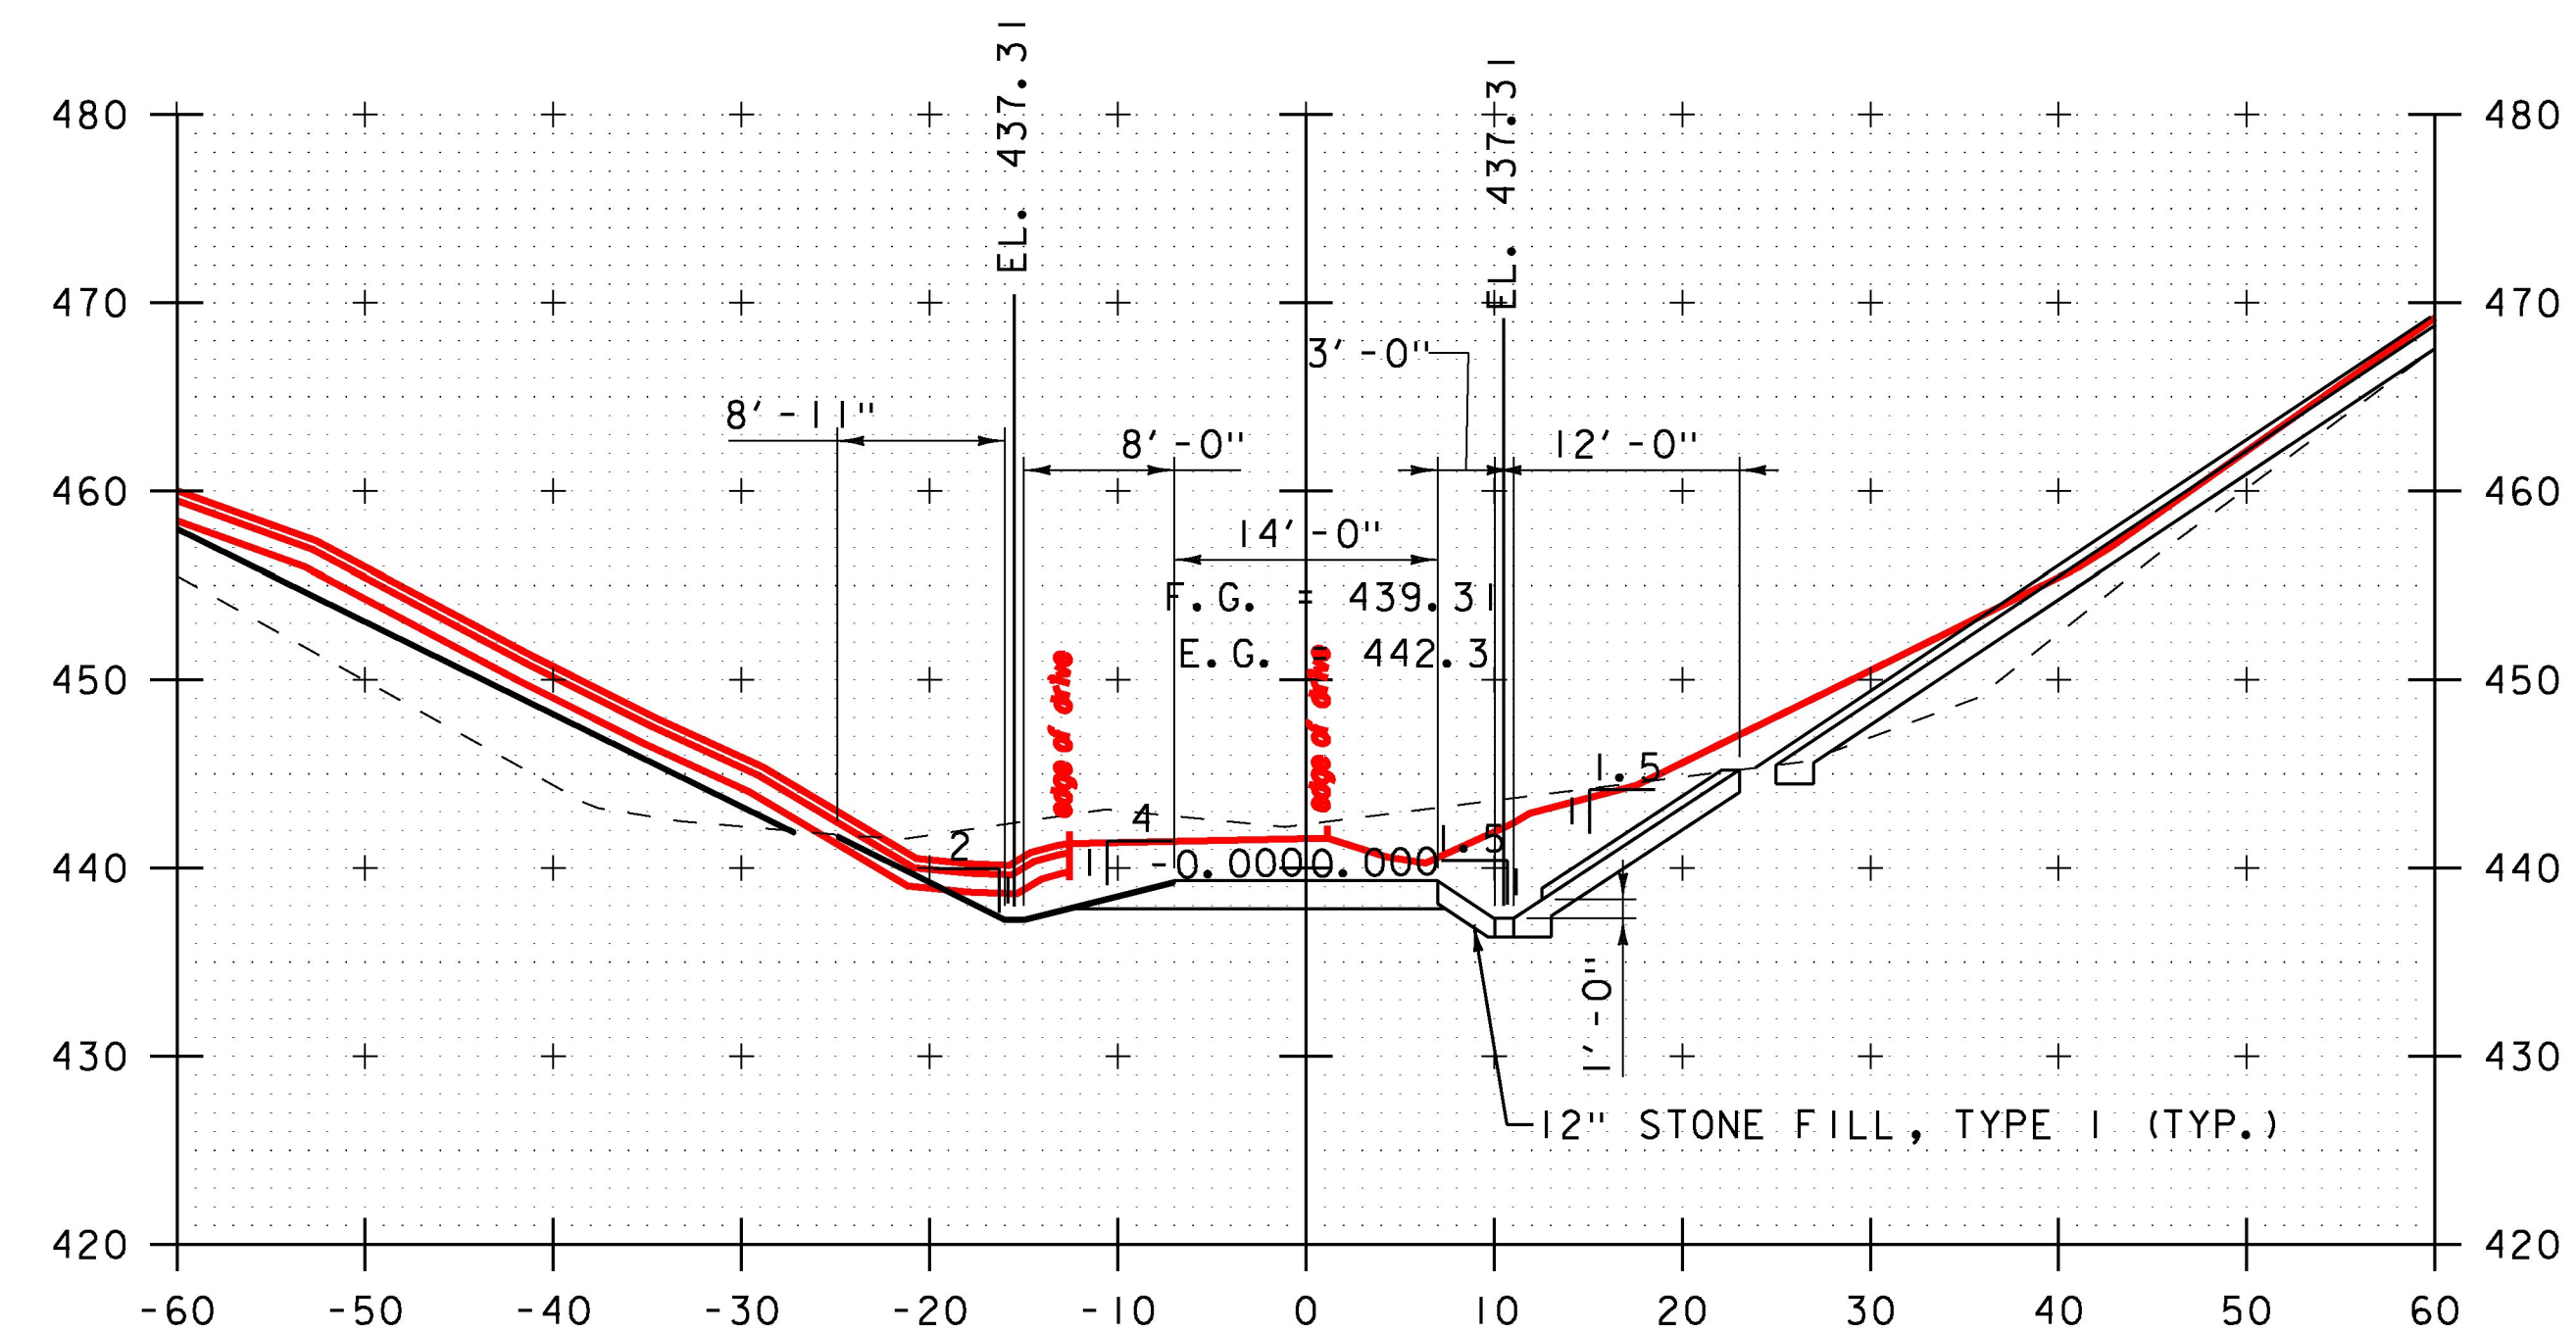

24+00

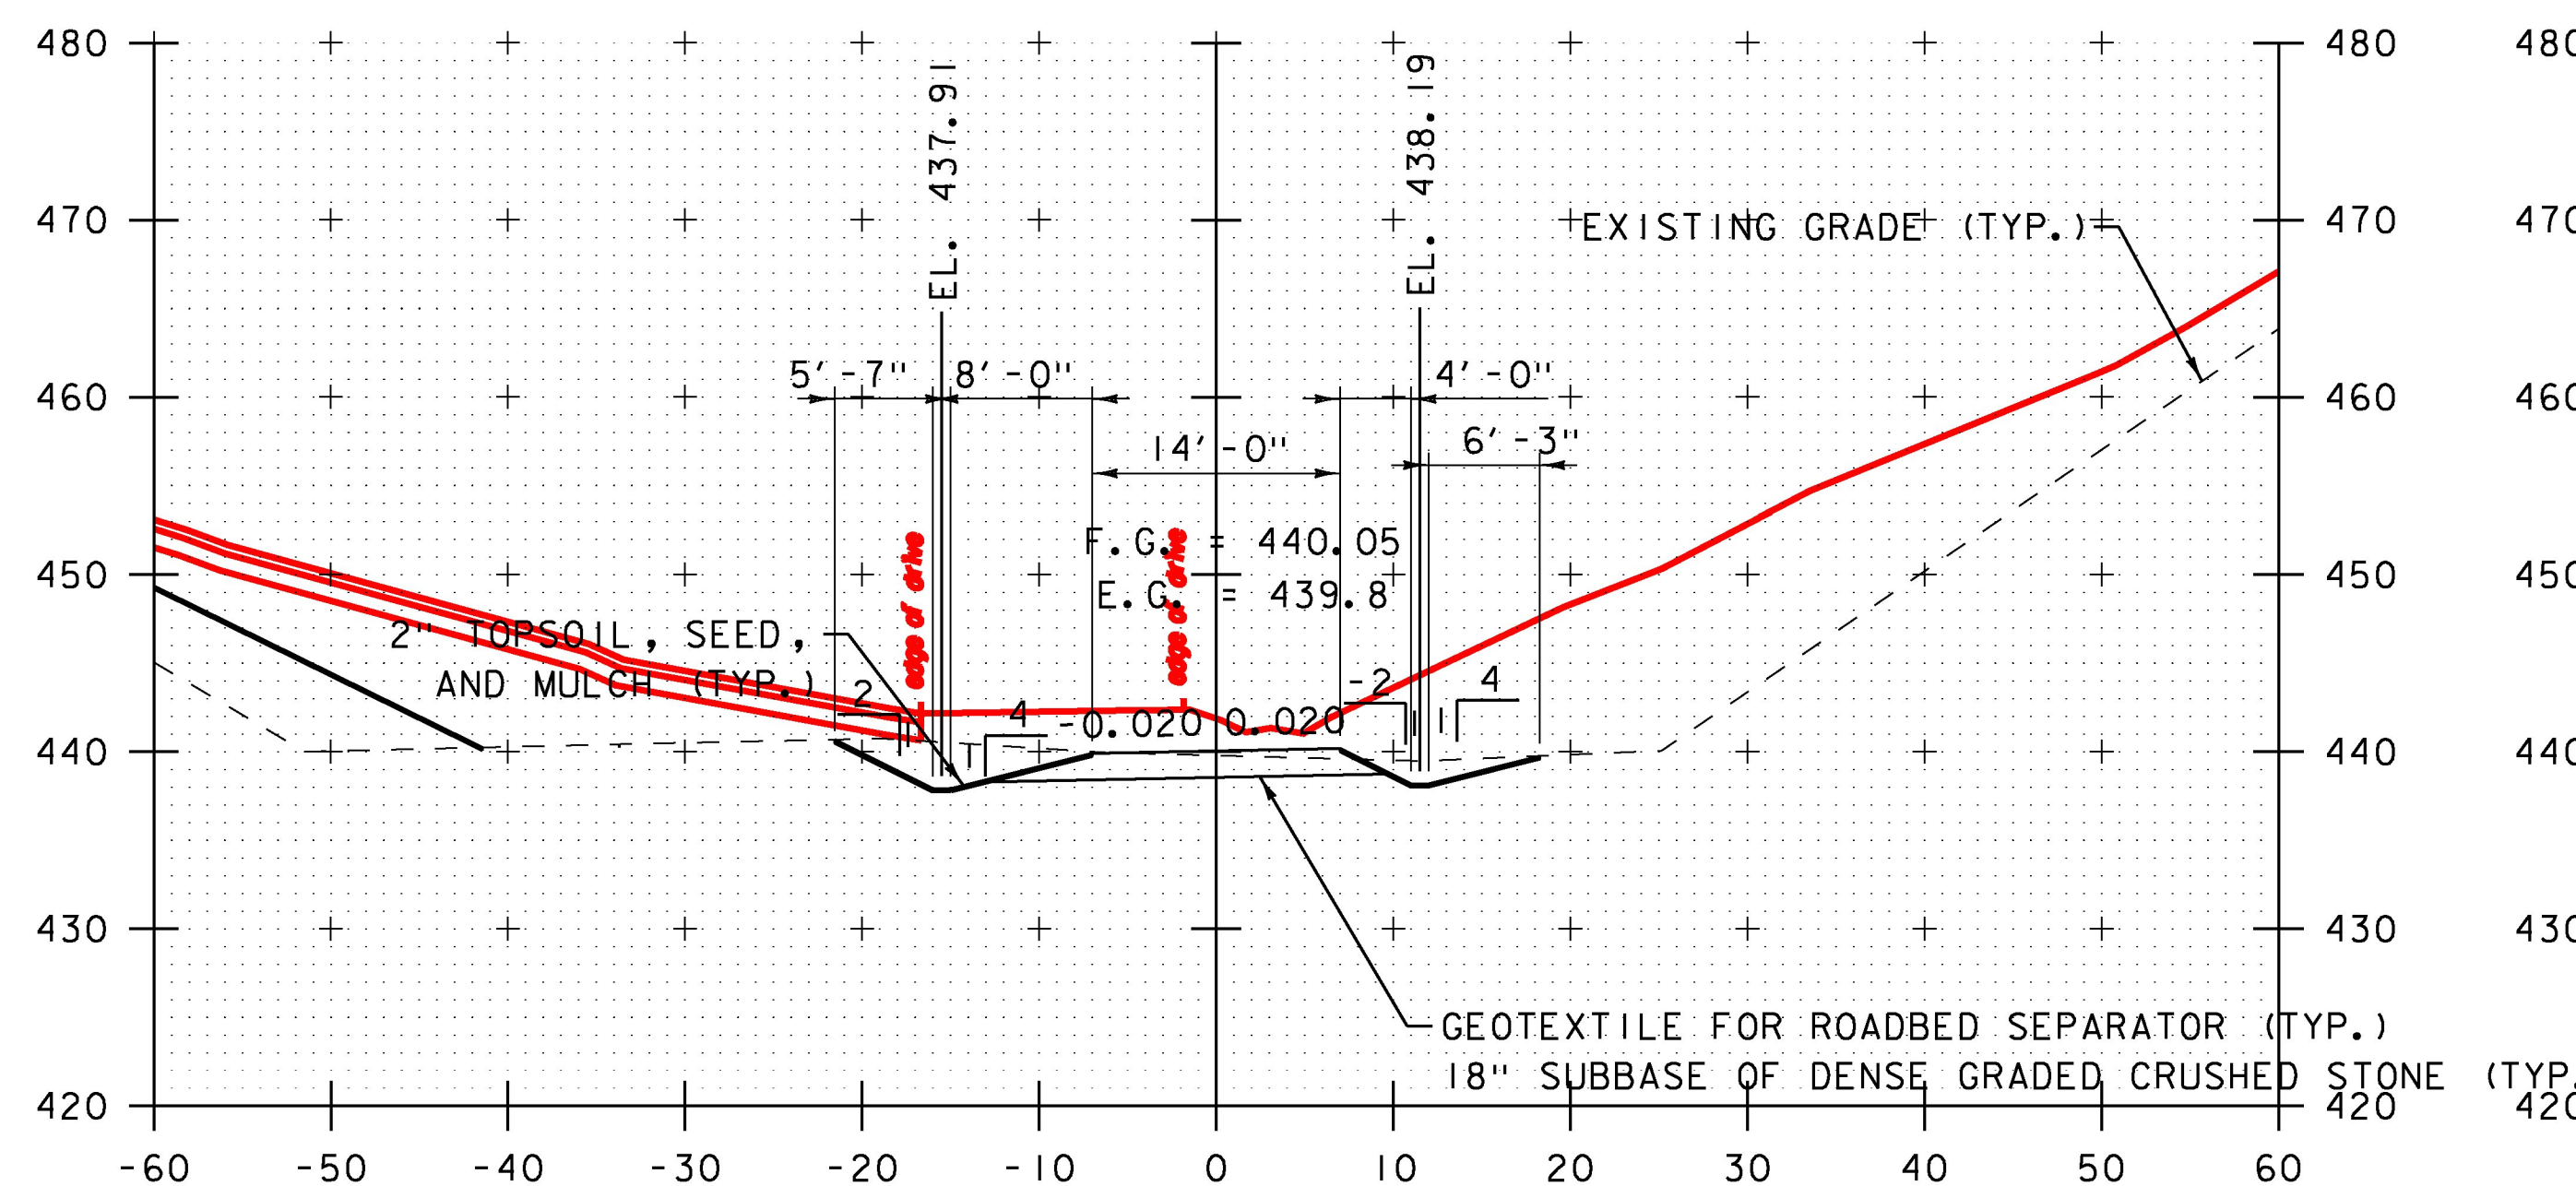


23+25

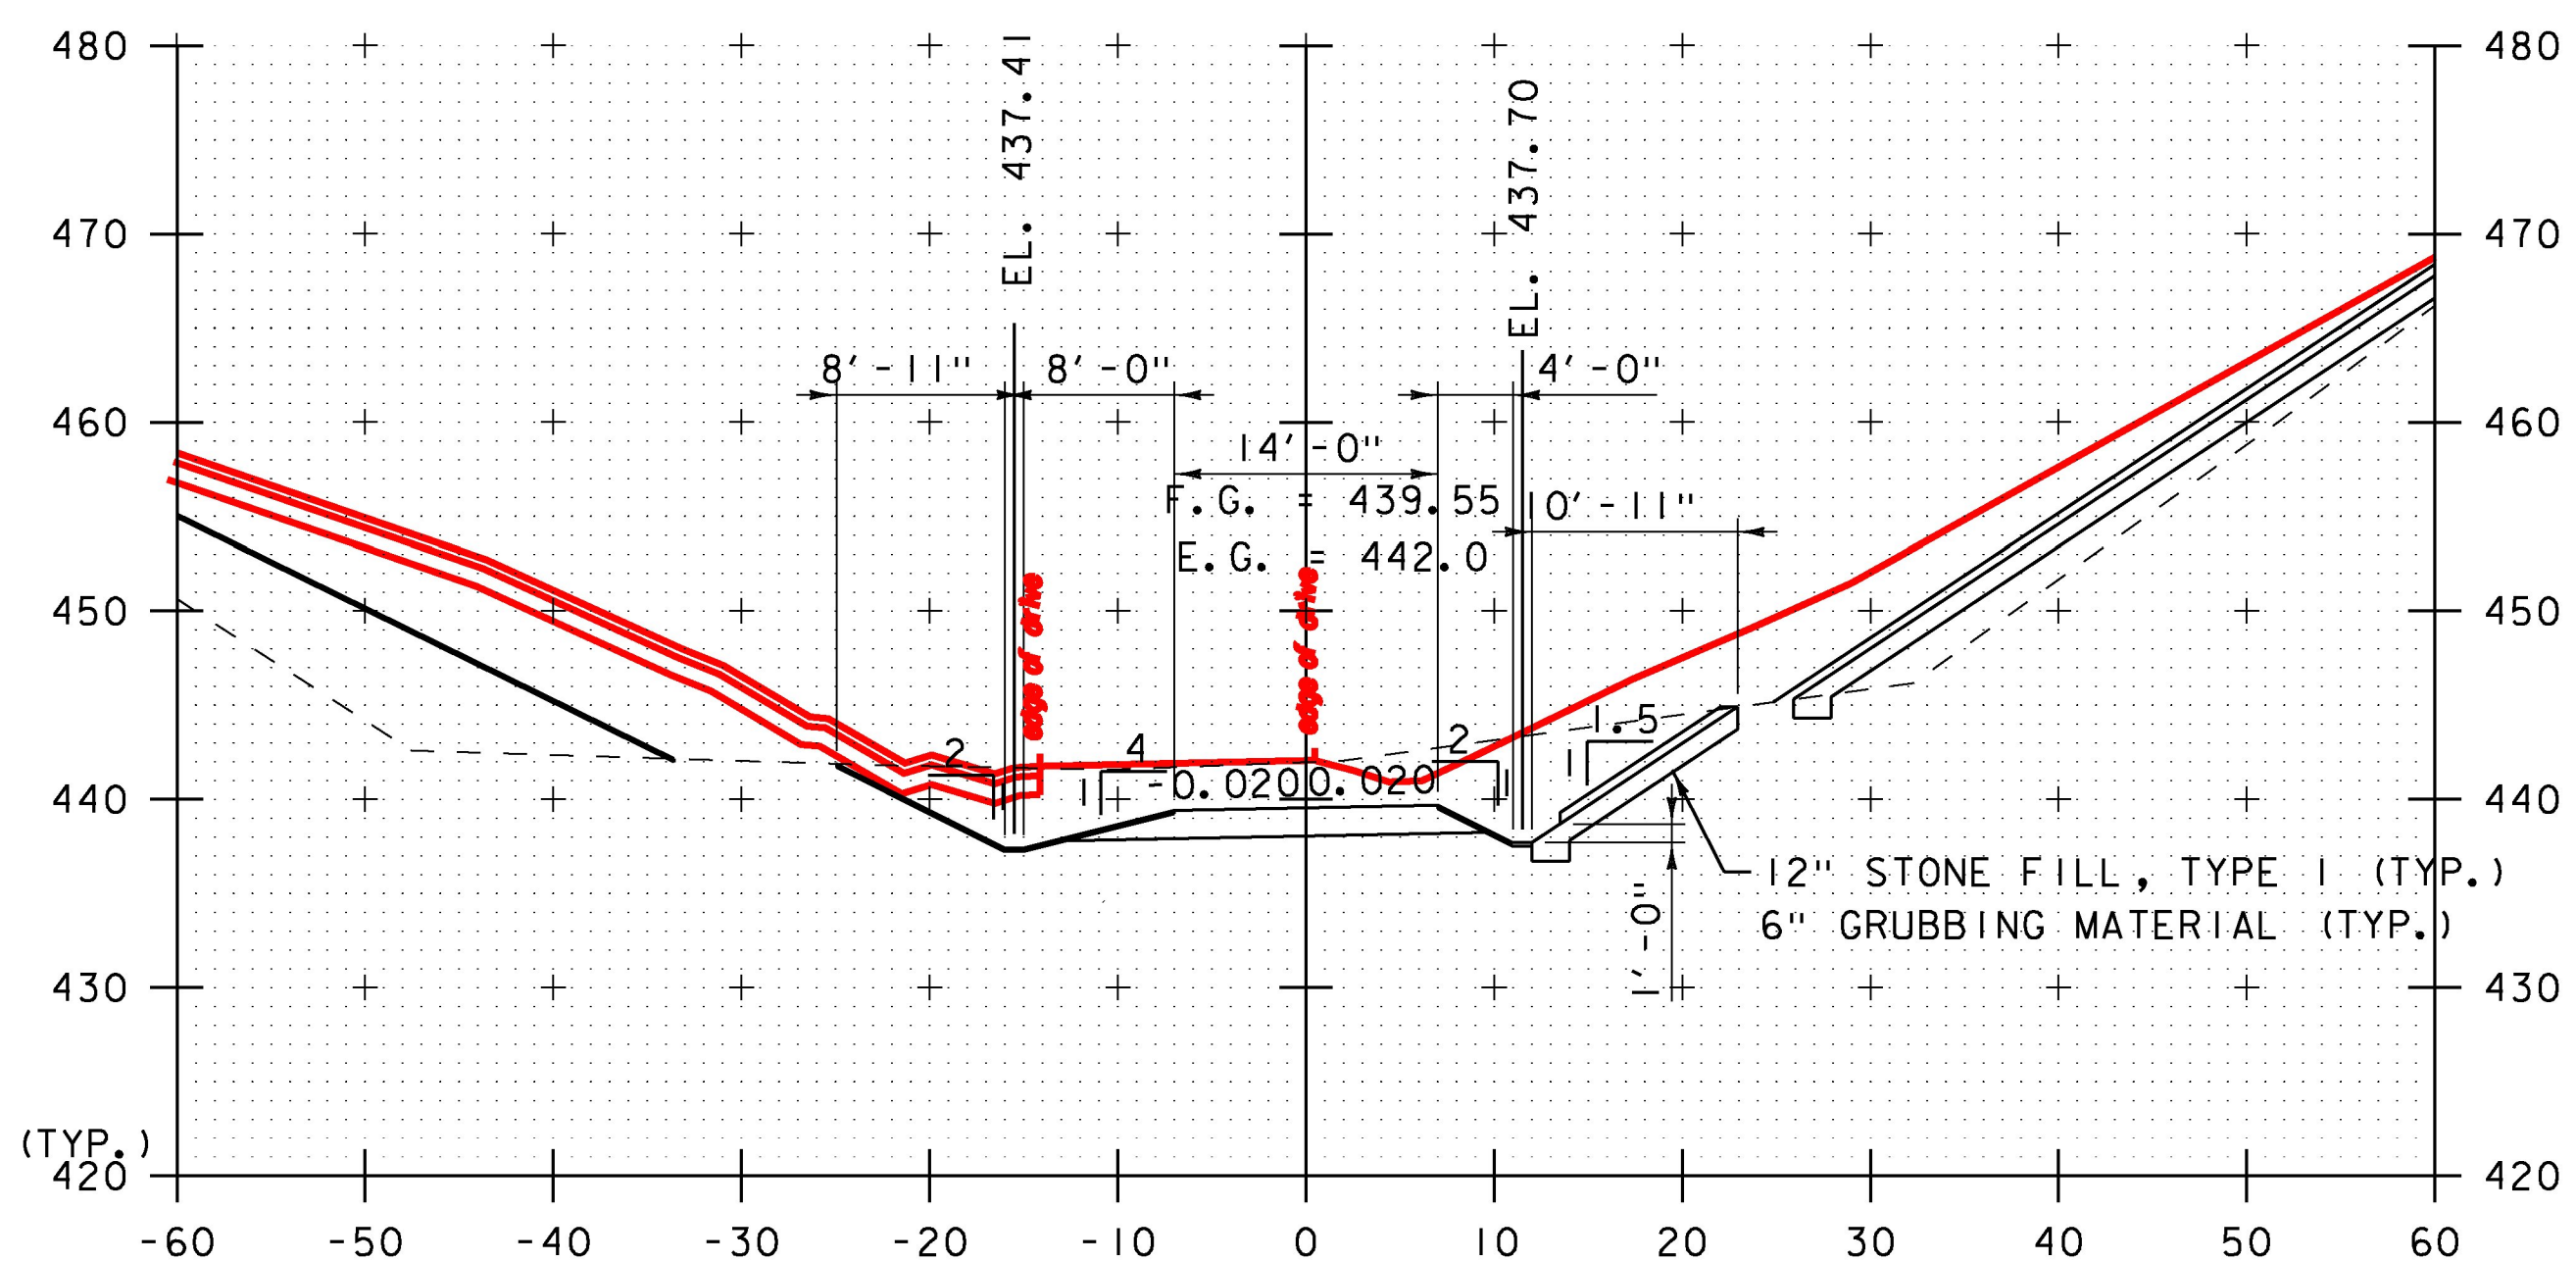

23+75

**RELEASED FOR CONSTRUCTION**  
NOVEMBER 24, 2015

STA. 23+25 TO STA. 24+00

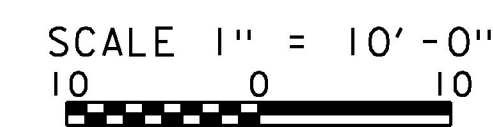

PROJECT NAME: RYEGATE  
PROJECT NUMBER: STP CULV(10)

FILE NAME: z06cl56xs\_acc2.dgn  
PROJECT LEADER: E. DETRICK  
DESIGNED BY: B. BRESLEND  
ACCESS ROAD 2 CROSS SECTION SHEET 4

PLOT DATE: 11/24/2015  
DRAWN BY: B. BRESLEND  
CHECKED BY: E. DETRICK  
SHEET 28 OF 56