


24+34
(PARALLEL TO CHANNEL WALL)

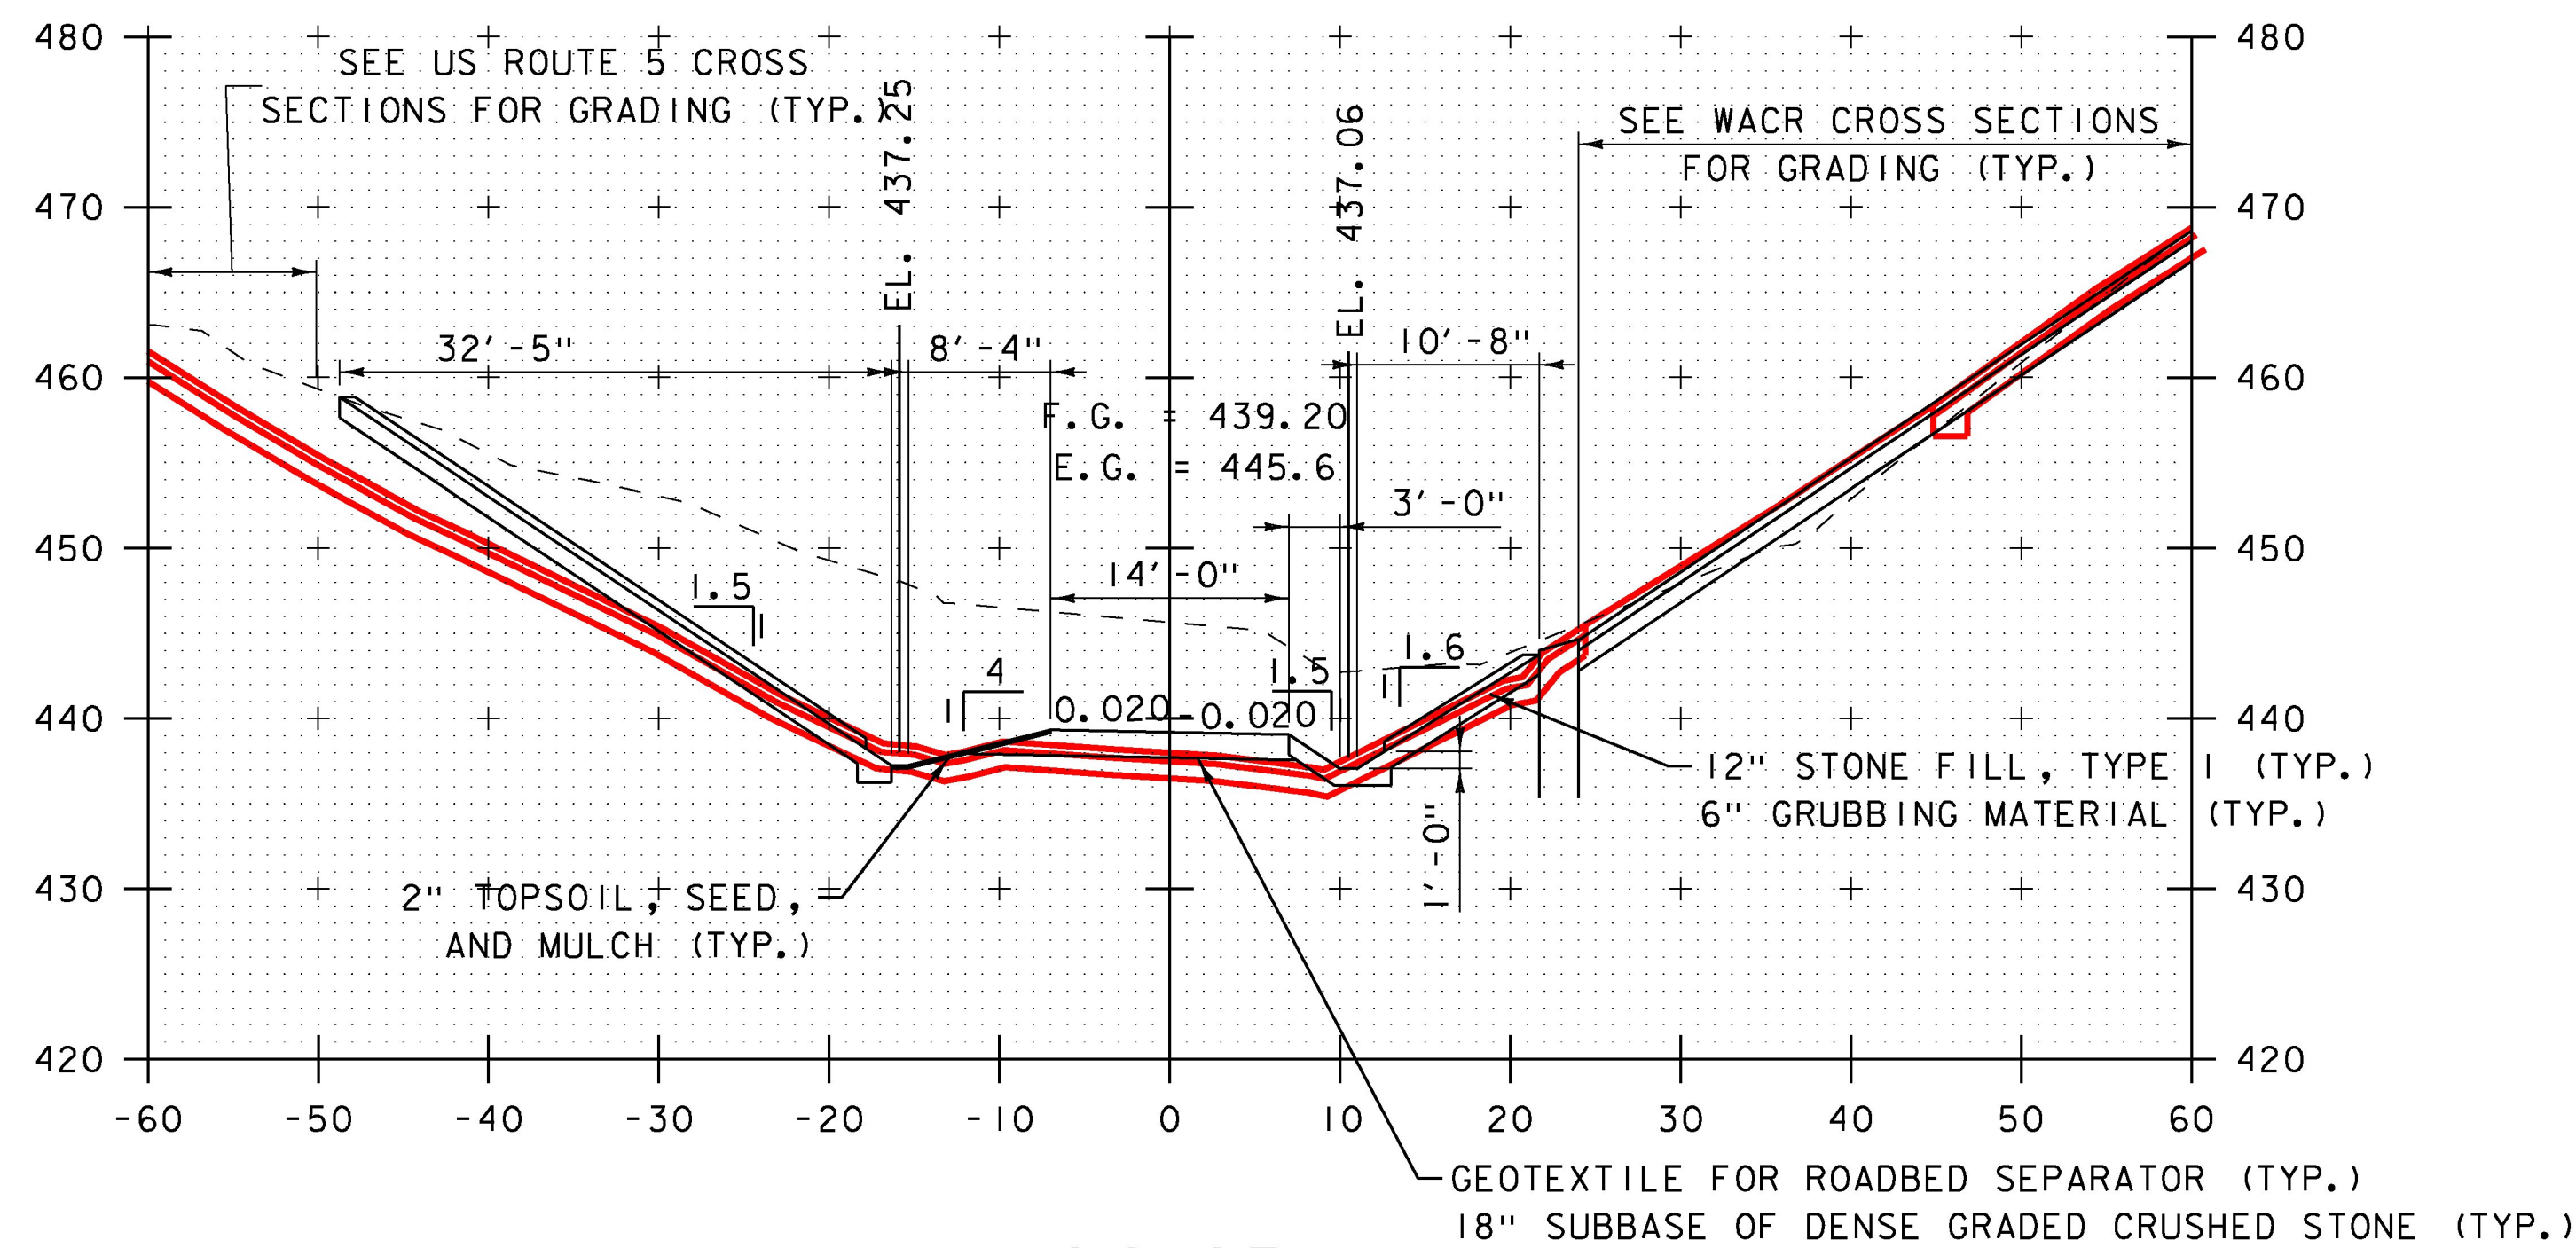

24+25

3 STA. 12+97.66, 22.50' RT
 PRECAST REINFORCED CONCRETE PIPE
 DROP INLET WITH THROAT AND COVER,
 SEE VTRANS STD D-1 FOR DETAILS
 INV. IN = 434.00
 INV. OUT = 430.10
 INSTALL WITH INLET ON NORTH & SOUTH

4 STA. 12+97.66, 22.50' RT TO
 STA. 12+97.75, 16.00' RT
 15" CPEP (SL) (5'-0")
 INV. IN = 430.10
 INV. OUT = 430.00

STA. 24+25 TO STA. 24+41

SCALE 1" = 10'-0"



**RELEASED FOR
 CONSTRUCTION**

NOVEMBER 24, 2015

PROJECT NAME: RYEGATE
 PROJECT NUMBER: STP CULV(10)

FILE NAME: z06cl56xs_acc2.dgn
 PROJECT LEADER: E. DETRICK
 DESIGNED BY: B. BRESLEND
 ACCESS ROAD 2 CROSS SECTION SHEET 5

PLOT DATE: 11/24/2015
 DRAWN BY: B. BRESLEND
 CHECKED BY: E. DETRICK
 SHEET 29 OF 56