


- SOIL NAIL WITH PLATE
  - TIEBACK OR SOIL NAIL WITH WALER BEAM OR BRACKET
  - ⊙ TEST SOIL NAIL
  - ⊗ 3/4" STEEL LAGGING OR 3" WOOD LAGGING OR SHOTCRETE
  - ⌋ HP12x53 SOLDIER PILE
- } SEE WP 3.4.4 AMENDMENT 2

GENERAL NOTES:

1. ACTUAL AS-BUILT CONDITION OF WALL IS SHOWN TO HIGHLIGHT SHEETPILE CONFIGURATION AROUND EXISTING STONE BOX CULVERT
2. SHEETS DRIVEN OVER CULVERT ARE TO REFUSAL. IT APPEARS THAT THEY ARE HITTING A FLAT ROCK OR STONE SURFACE WHICH MAY BE THE TOP OF CULVERT. HOWEVER, BECAUSE THE DISTANCE ABOVE THE VISIBLE CAP STONE IS SIGNIFICANT, THIS PLAN SHOWS LAGGING HERE WHICH WILL BE USED IF NEEDED

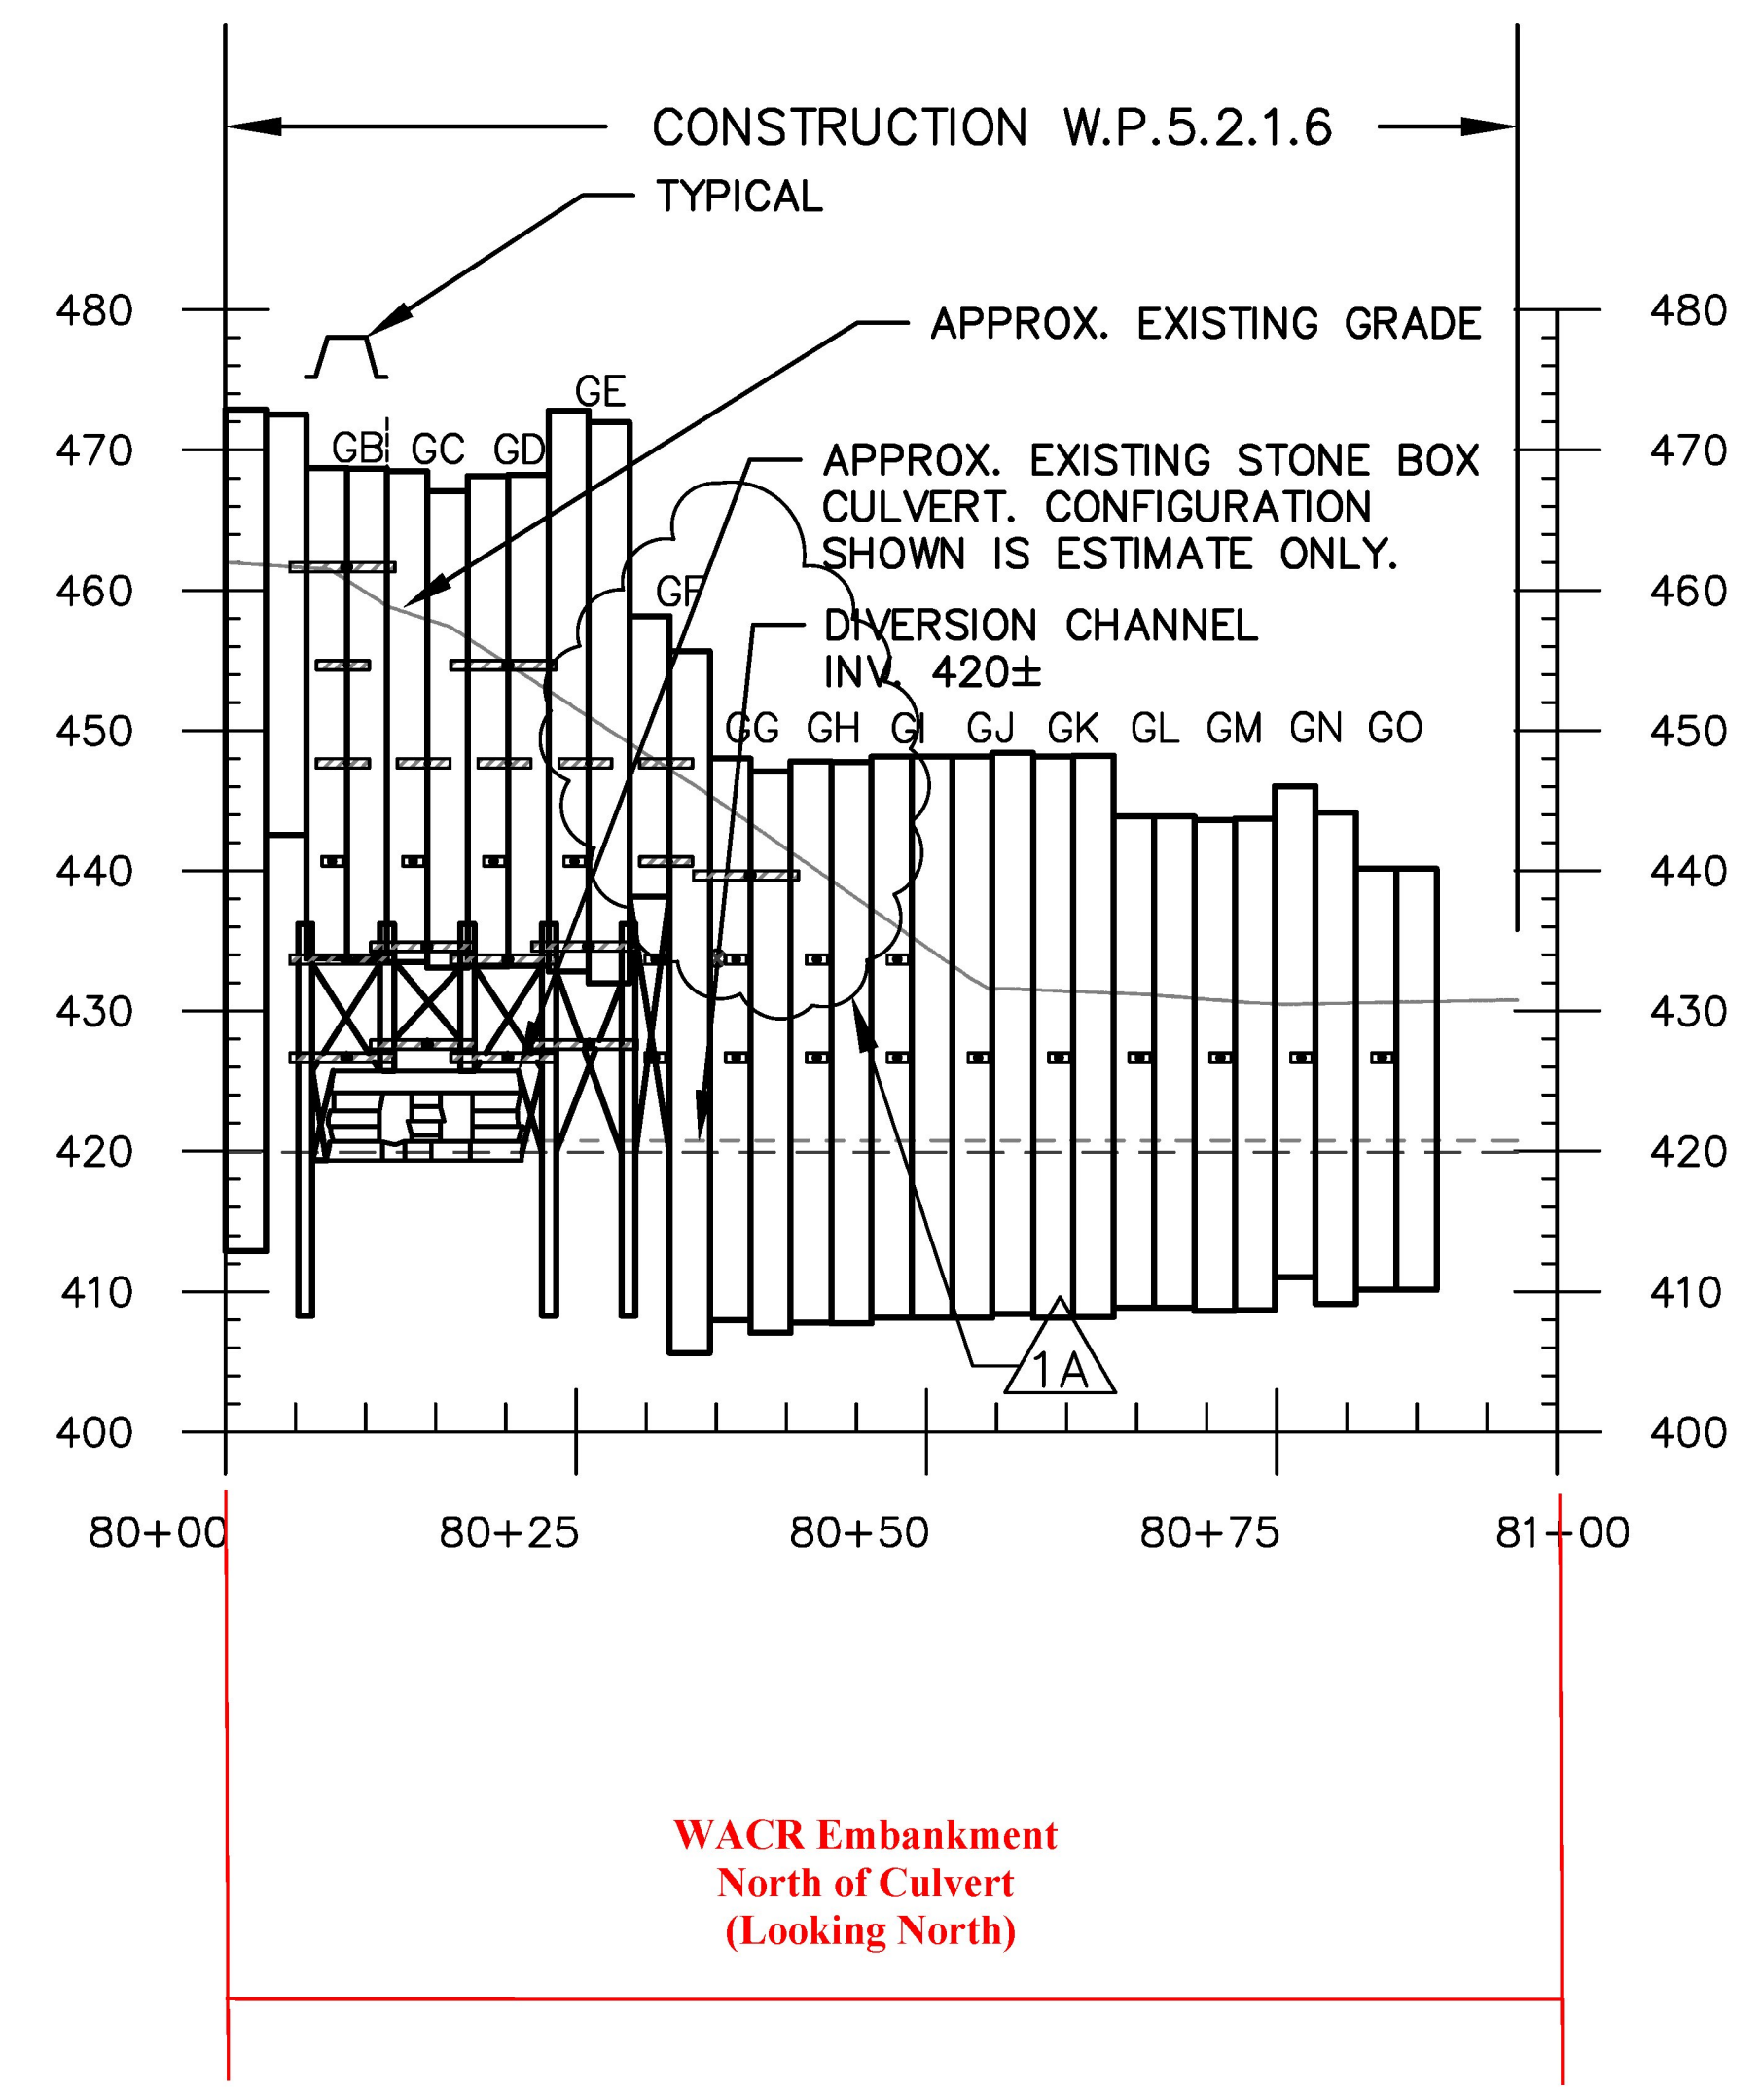

- Wales and Soil Anchor Heads Removed  
 - Sheet Piles Removed Except As Shown In Plan View

**(For Reference Only)**

PROJECT NAME: RYEGATE	
PROJECT NUMBER: STP CULV(10)	
FILE NAME:	PLOT DATE:
PROJECT LEADER:	DRAWN BY:
DESIGNED BY:	CHECKED BY:
Abandoned Structures	SHEET 7 OF 8