


- SOIL NAIL WITH PLATE
TIEBACK OR SOIL NAIL
WITH WALER BEAM OR
BRACKET
- ⊙ TEST SOIL NAIL

SHEETPILES AND SOLDIER PILES SHOWN FROM 10+00 TO 10+63
REPRESENT AS-BUILT CONDITION. SHEETPILES SHOWN OUTSIDE THIS AREA
ARE DEPICTED AS DESIGNED BECAUSE THOSE SHEETS ARE INSTALLED
CONSISTENT WITH THE RFC DESIGN OR WITHIN THE TOLERANCE ALLOWED
THEREIN. SEE WP 3.4.4 FOR WALL DETAILS.

SOLDIER PILES ADDED TO THIS AREA. CHANGES WILL
BE SHOWN ON AMENDED WP 3.4.4. NO CHANGE IN
TIEBACK OR SOIL NAIL LOCATIONS, DIMENSIONS OR
LOADS. SEE DETAIL SHEET 12 OF 15 FOR WALER
DETAILS.

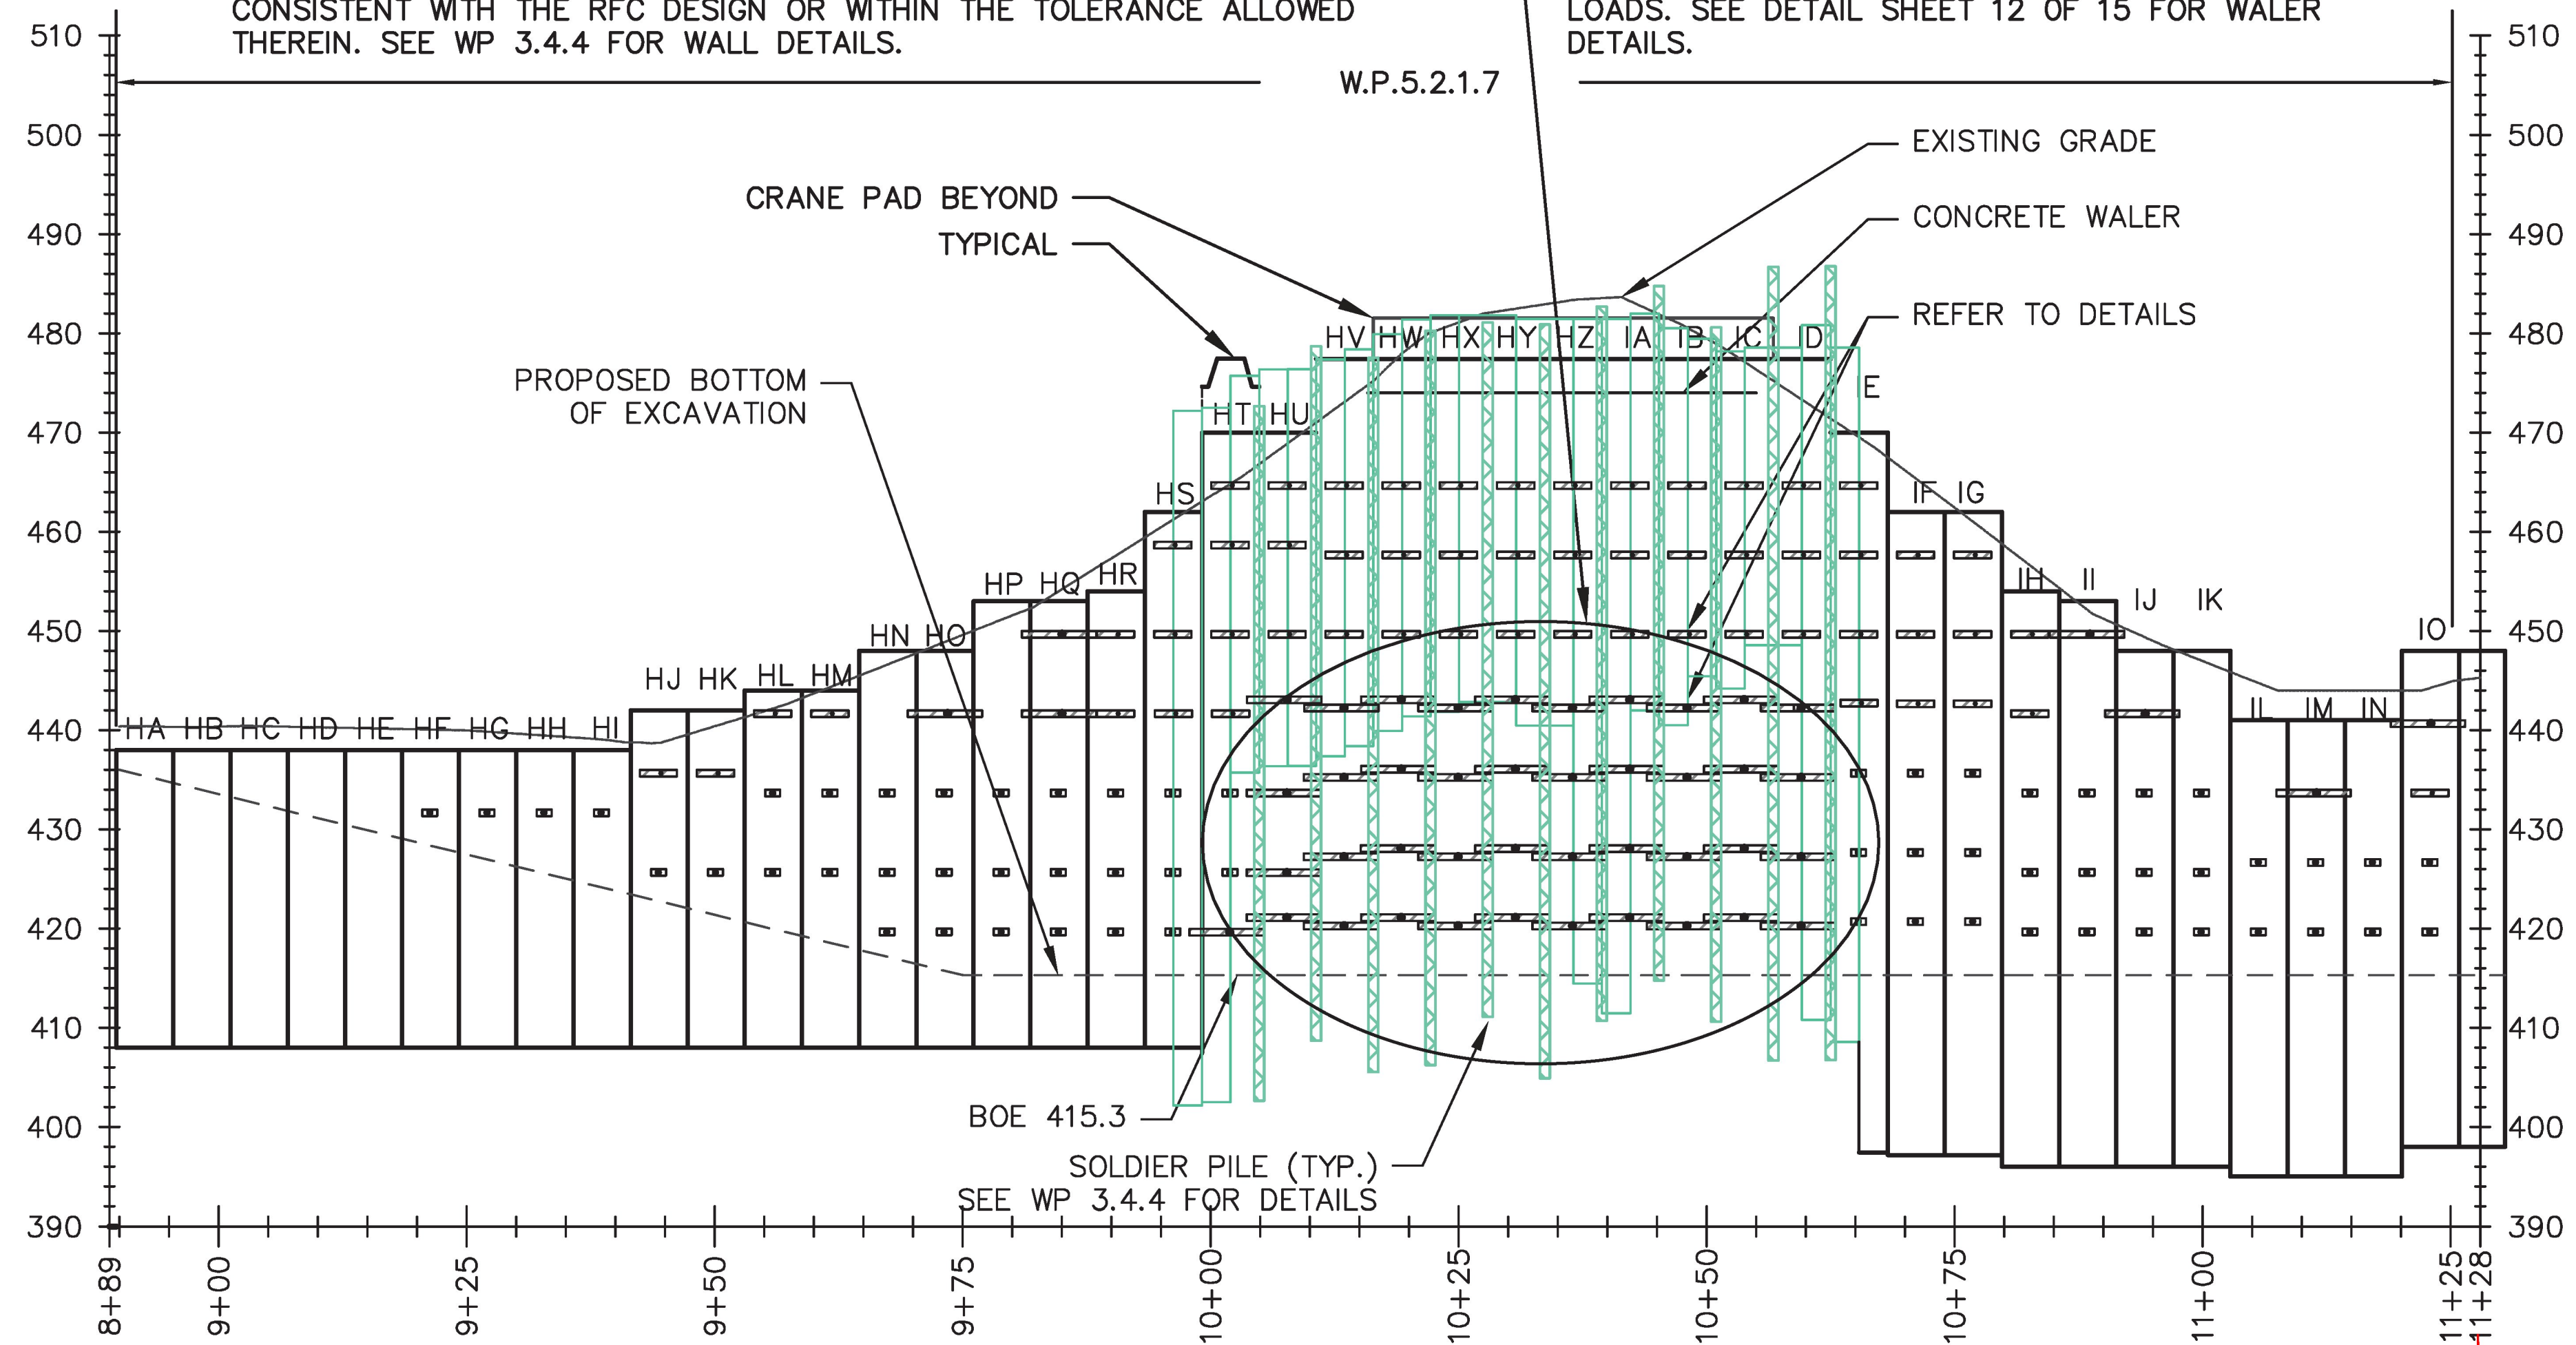

**WACR Embankment
South of Culvert
(Looking South)**

- Wales and Soil Anchor Heads Removed
- Sheet Piles Removed Except As Shown In Plan View

(For Reference Only)

| | |
|------------------------------|--------------|
| PROJECT NAME: RYEGATE | |
| PROJECT NUMBER: STP CULV(10) | |
| FILE NAME: | PLOT DATE: |
| PROJECT LEADER: | DRAWN BY: |
| DESIGNED BY: | CHECKED BY: |
| Abandoned Structures | SHEET 8 OF 8 |